


CAMBER DETAIL

TYP. DIAPHRAGM STIFFENER
WELD DETAIL


* NO WELD FOR $\frac{3}{8}$ " MIN.
OR $\frac{7}{8}$ " MAX.

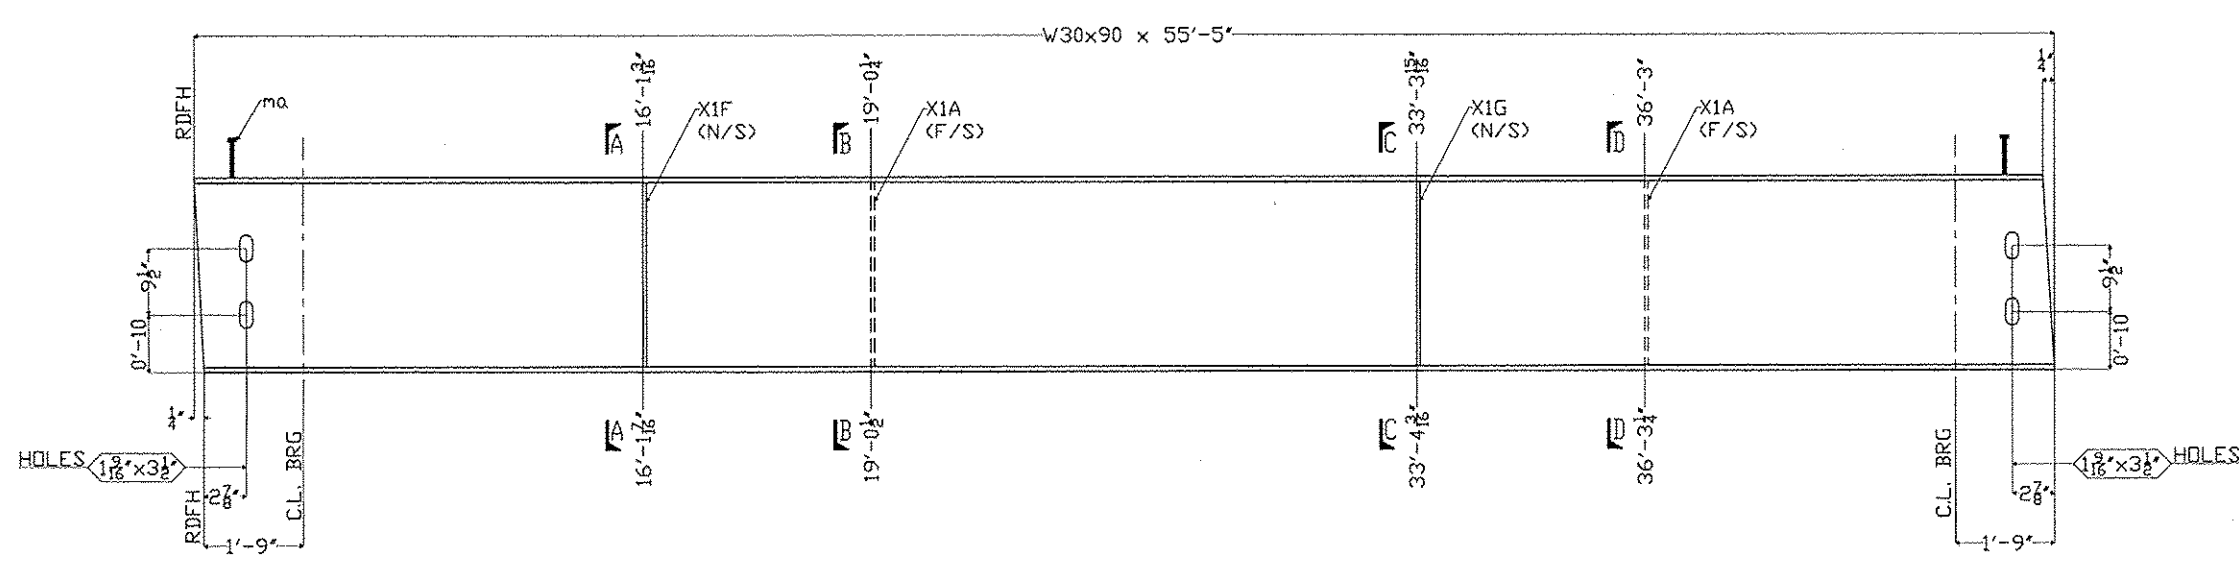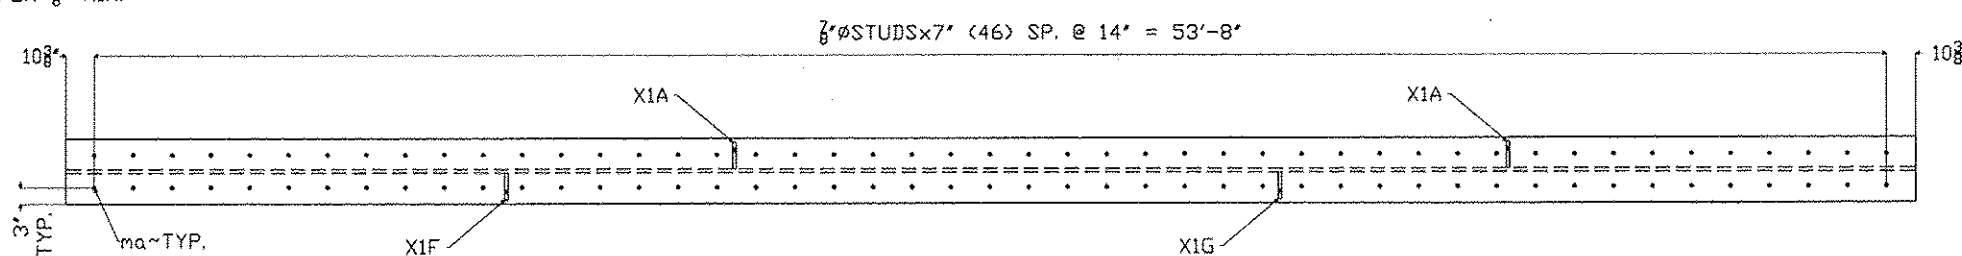


ONE ~ GIRDER DETAIL ~ 3B1

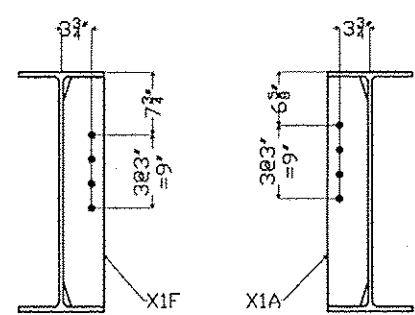


SECTION A-A

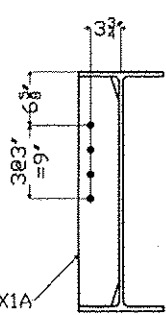

SECTION B-B

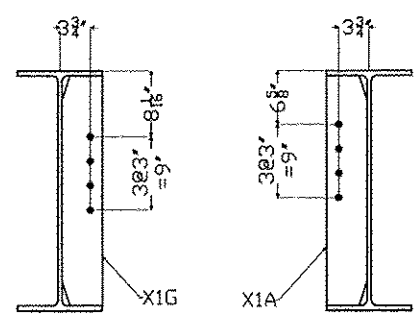

SECTION C-C

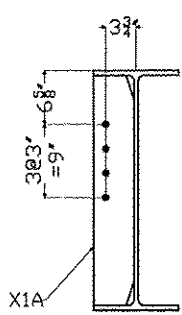

SECTION D-D

SHIPPER		BILL OF MATERIAL					ITEM	QTY
NO.	MARK	NO.	MARK	SIZE	LENGTH	REMARKS		
I	3BI			W/30"x90"	55'-5"	CVN		
		2	XIA	PL 4"x6"	2'-6"	CVN		
		1	XIF	PL 4"x6"	2'-6"	CVN		
		1	XIG	PL 4"x6"	2'-6"	CVN		
		94	no	3/8" STUB	0'-7"			

RECEIVED
CK'D BY _____ OK'D BY RSY
OCT 17 2011
RESUBMIT _____ APPROVED ☒
BY _____ DATE 10/18/2011

			
REV NO		DATE	
		REVISION	
GIRDER DETAIL			
TOWN OF ROXBURY, WASHINGTON COUNTY, VT			
PROJECT NUMBER: BHF 0187(S)			
VT 12A, MAJOR COLLECTOR - BRIDGE 15			
PRECISE STRUCTURAL PRODUCTS			
			
3 FARM LANE GEORGETOWN, VT 05733 878-332-2681			
OWNER: VT AGENCY OF TRANSPORTATION			
CONTRACTOR: LUCK BROTHERS INC			
DESIGN BY	CHECKED BY	APPV.	SHOP DET.
10/07/11	10/10/11		
		3590	3