



STATE OF VERMONT AGENCY OF TRANSPORTATION

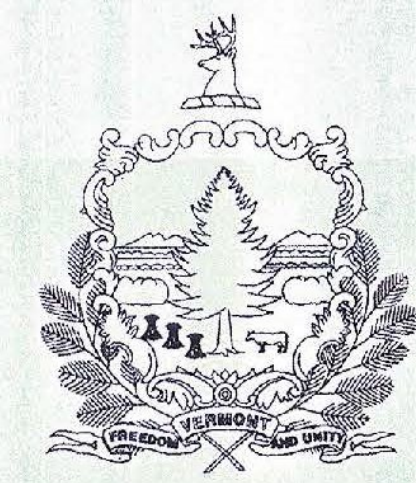

PROPOSED IMPROVEMENT BRIDGE PROJECT TOWN OF WOODSTOCK COUNTY OF WINDSOR

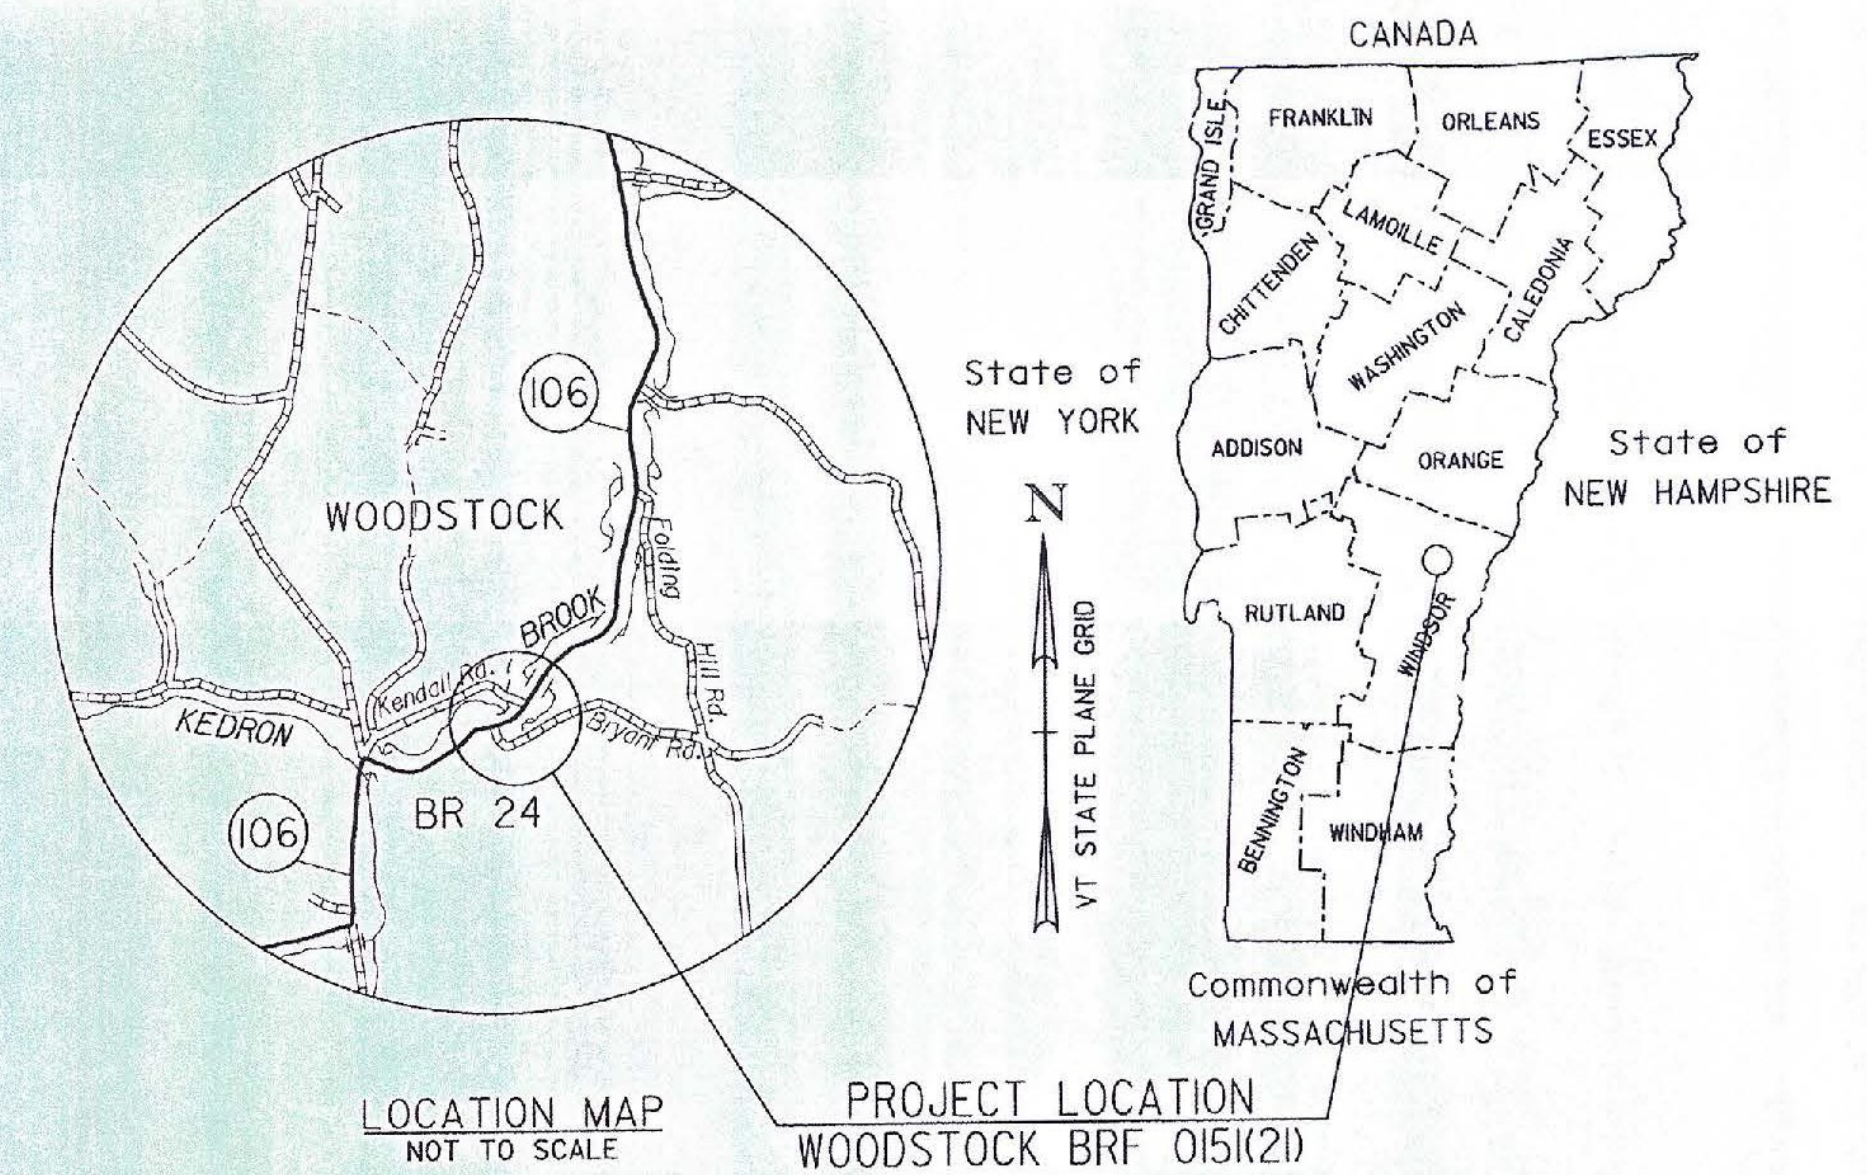


RECORD PLANS	
CONTRACTOR:	MILLER CONSTRUCTION, INC - WINDSOR, VT
RESIDENT ENGINEER:	TOM CHASE
CONSTRUCTION BEGAN:	MAY 2, 2016
CONSTRUCTION COMPLETE:	JUNE 28, 2016
RECORD PLANS BY:	TOM CHASE & KEVIN KING
I HEREBY CERTIFY THAT ALL THE CONSTRUCTION REQUIRED BY THIS SET OF DRAWINGS HAS BEEN ACCOMPLISHED AS INDICATED HEREIN.	
BY	<u>Thomas A. Chase</u> RESIDENT ENGINEER
DATE	<u>01/30/17</u>
NOTE: Any further information concerning final quantities, amounts or other details relative to this project may be found at Central Files in the electronic archives.	

VERMONT ROUTE 106 (MAJOR COLLECTOR RURAL) BRIDGE NO. 24

PROJECT LOCATION: IN THE TOWN OF WOODSTOCK, VERMONT ROUTE 106 APPROXIMATELY 200 FT SOUTH OF THE INTERSECTION WITH T.H. 61 (KENDALL ROAD) AT MILE MARKER 3.04.



PROJECT DESCRIPTION: REPLACEMENT OF EXISTING BRIDGE WITH A PRECAST CONCRETE STRUCTURE ALONG WITH RELATED ROADWAY AND CHANNEL WORK.

LENGTH OF BRIDGE: 45.27 FEET = 0.008 MILES
LENGTH OF ROADWAY: 229.73 FEET = 0.044 MILES
LENGTH OF PROJECT: 275.00 FEET = 0.052 MILES

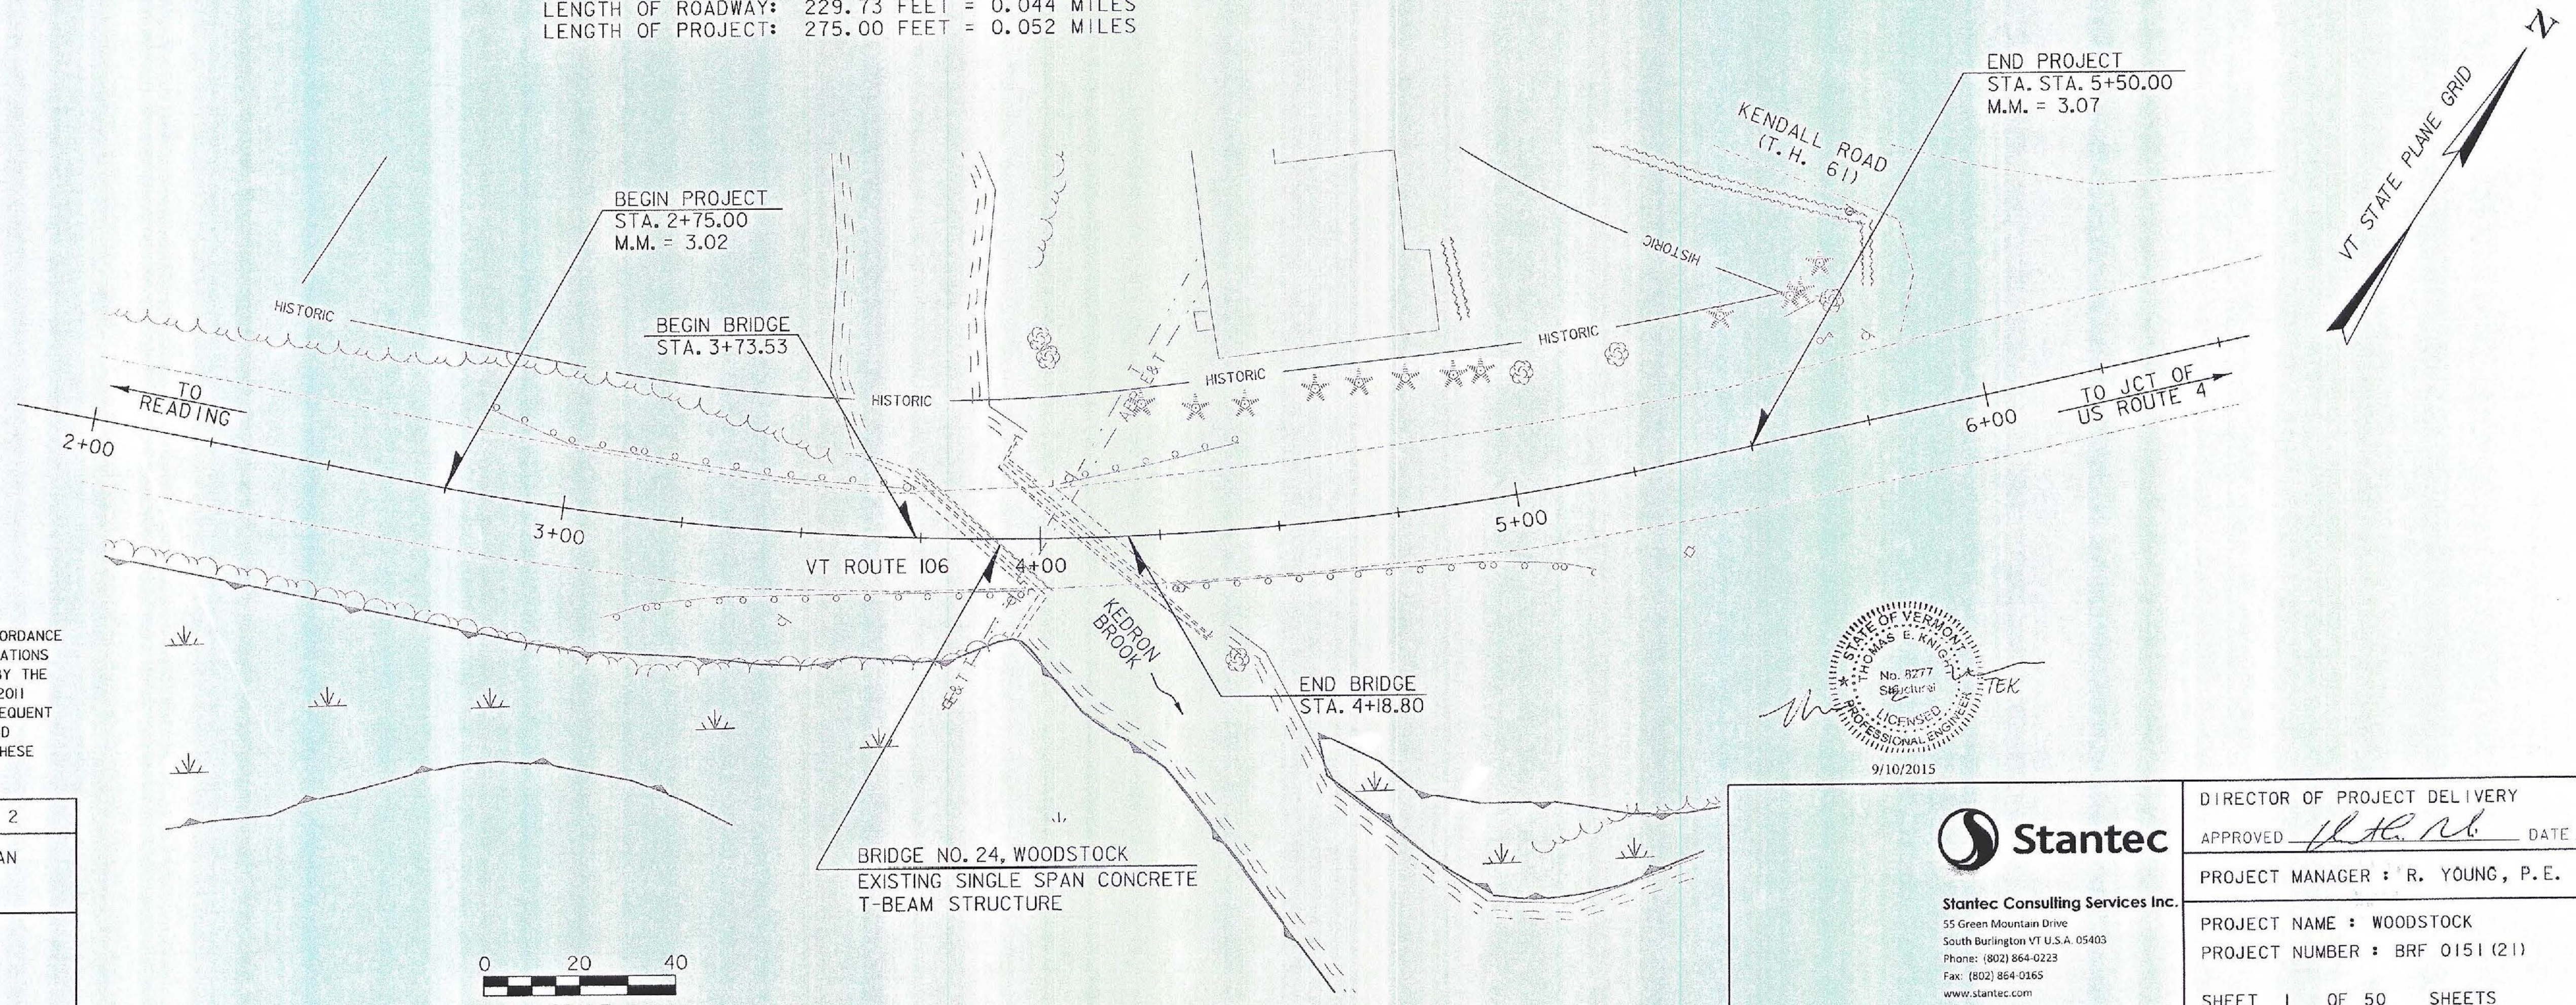

CONSTRUCTION IS TO BE CARRIED ON IN ACCORDANCE WITH THESE PLANS AND THE STANDARD SPECIFICATIONS FOR CONSTRUCTION DATED 2011, AS APPROVED BY THE FEDERAL HIGHWAY ADMINISTRATION ON JULY 20, 2011 FOR USE ON THIS PROJECT, INCLUDING ALL SUBSEQUENT REVISIONS AND SUCH REVISED SPECIFICATIONS AND SPECIAL PROVISIONS AS ARE INCORPORATED IN THESE PLANS.

QUALITY ASSURANCE PROGRAM : LEVEL 2	
SURVEYED BY : VTRANS, R. GILMAN	
SURVEYED DATE : 04/28/2011	
DATUM	
VERTICAL	NAVD 88
HORIZONTAL	NAD 83 (92)

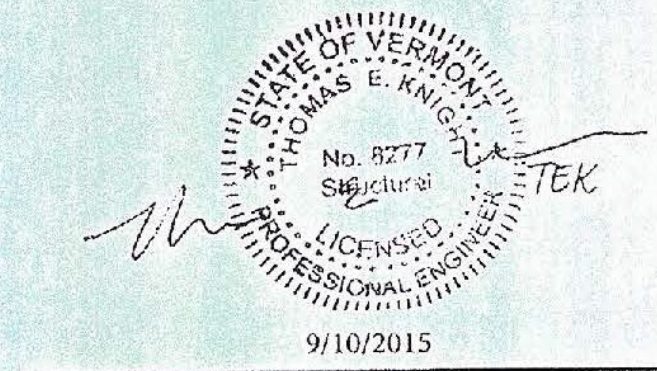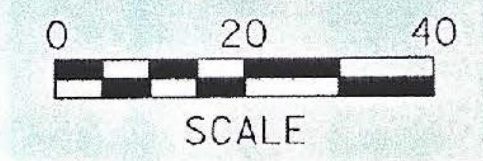

 Stantec Stantec Consulting Services Inc. <small>55 Green Mountain Drive South Burlington VT U.S.A. 05403 Phone: (802) 864-0223 Fax: (802) 864-0165 www.stantec.com</small>	DIRECTOR OF PROJECT DELIVERY APPROVED: <u>[Signature]</u> DATE <u>9/10/2015</u>
	PROJECT MANAGER : R. YOUNG, P.E. PROJECT NAME : WOODSTOCK PROJECT NUMBER : BR# 0151 (21) SHEET 1 OF 50 SHEETS