


PLAN
SCALE: 1" = 10'-0"
0 10 20

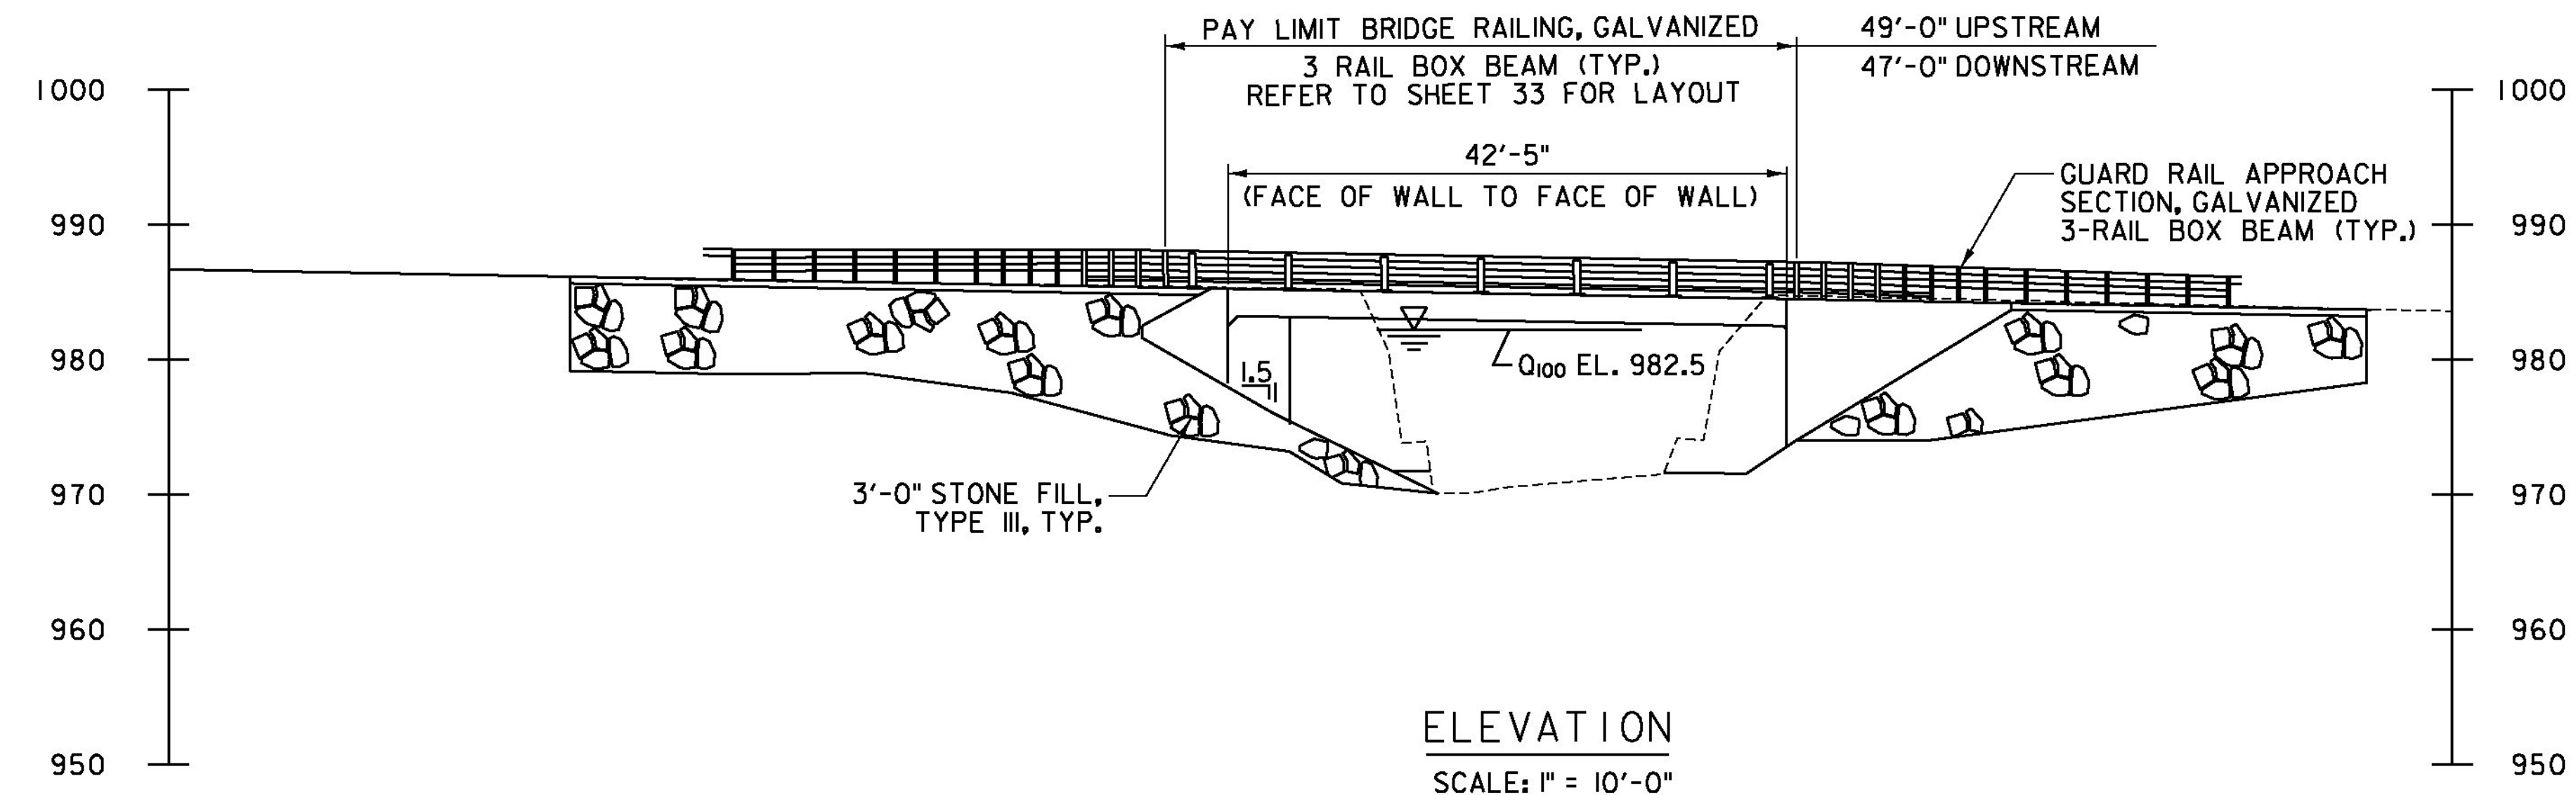

ELEVATION
SCALE: 1" = 10'-0"
0 10 20

PROJECT NAME:	WOODSTOCK	PLOT DATE:	9/2/2015
PROJECT NUMBER:	BRF 015(21)	DRAWN BY:	L. BUXTON
FILE NAME:	z10c426bdr.pe.dgn	DESIGNED BY:	T. KNIGHT
PROJECT LEADER:	G. BOGUE	CHECKED BY:	J. HUNGERFORD
PLAN AND ELEVATION		SHEET 24 OF 50	

