



STA. 52+85 LT
 END UNCLASSIFIED CHANNEL EXCAVATION
 GEOTEXTILE UNDER STONE FILL
 STONE FILL, TYPE III
 GRUBBING MATERIAL

52+90

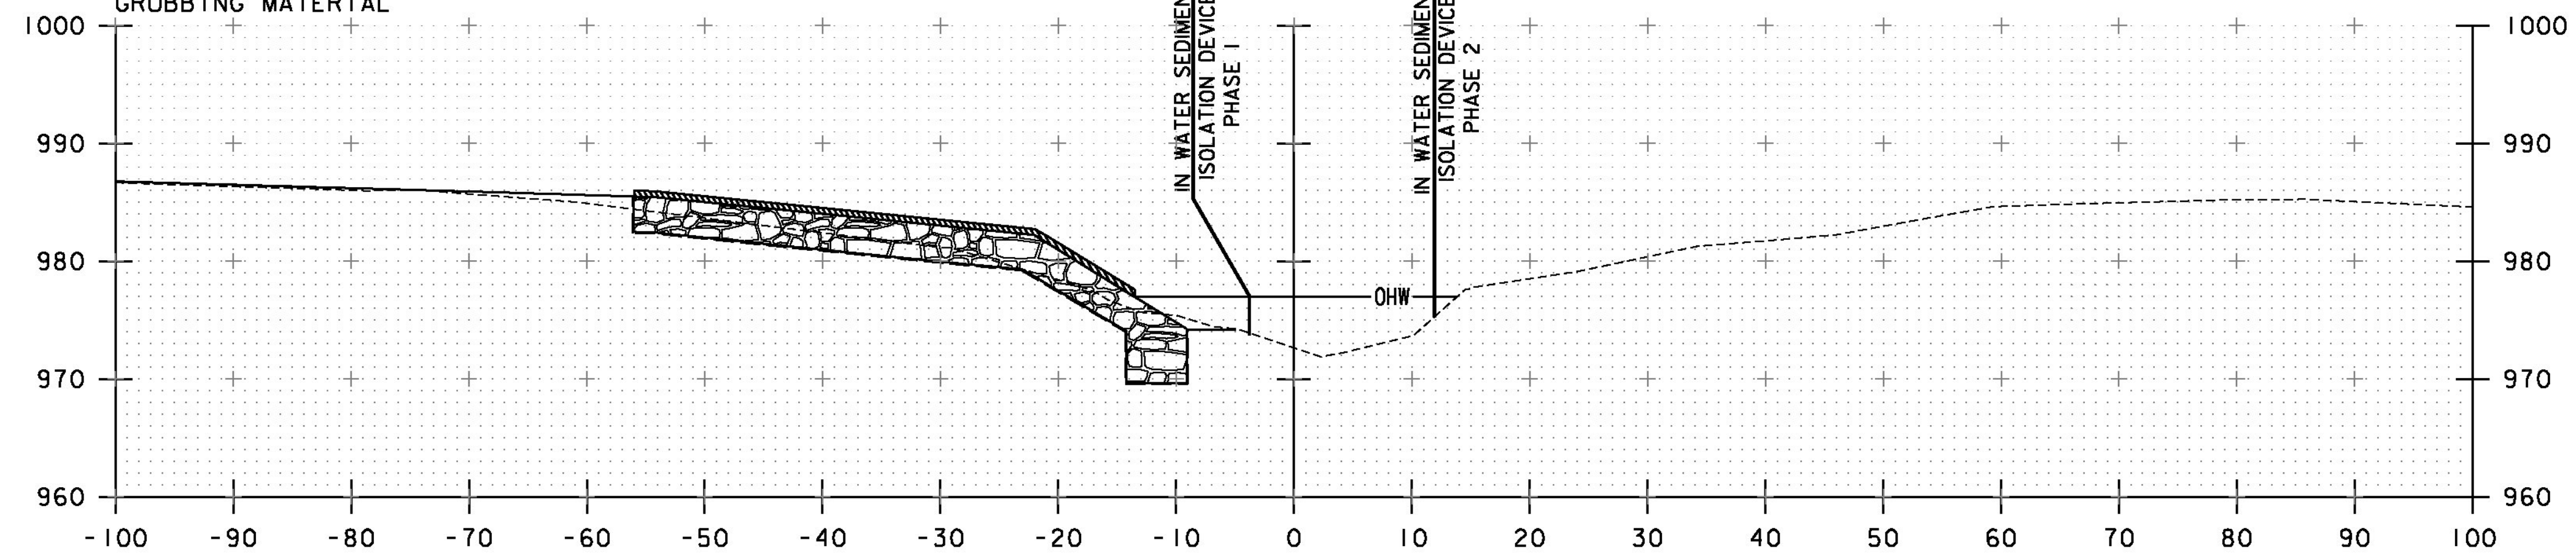

STA. 52+74 LT
 BEGIN GRUBBING MATERIAL

52+80

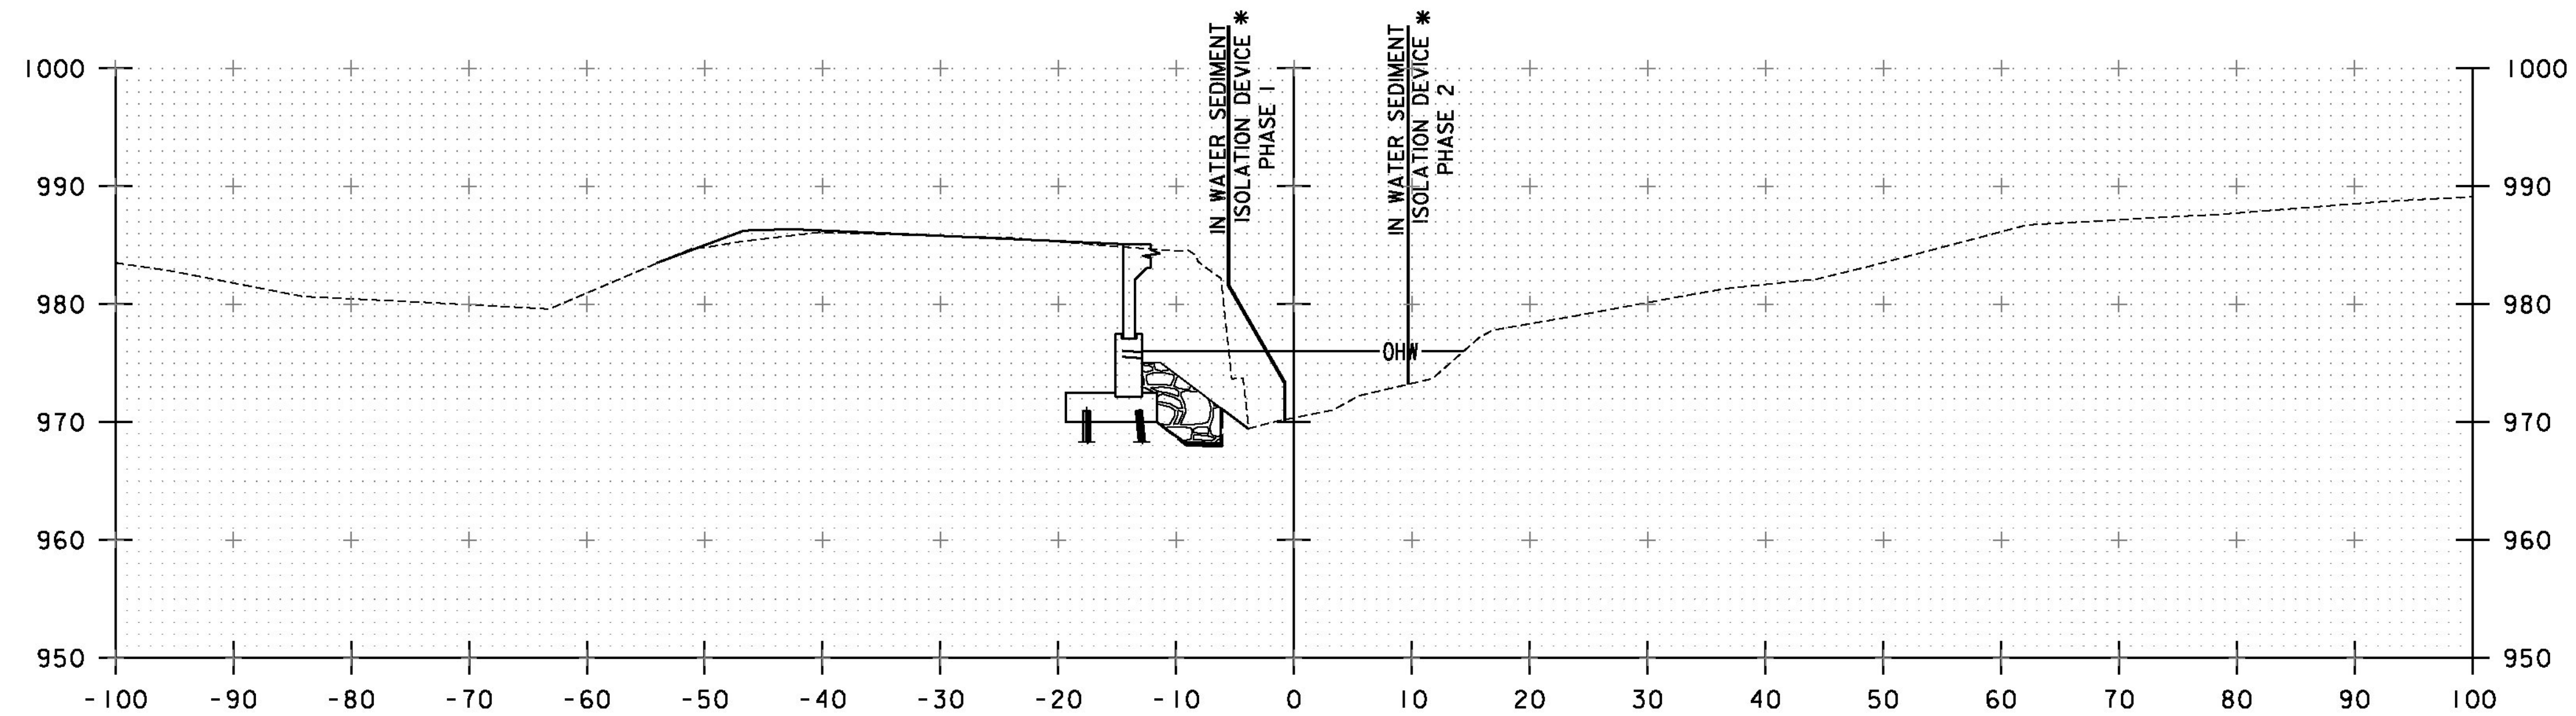


52+70

STA. 52+68 RT
 END UNCLASSIFIED CHANNEL EXCAVATION
 GEOTEXTILE UNDER STONE FILL
 STONE FILL, TYPE III
 GRUBBING MATERIAL

* SEE NOTE 2 ON SHEET 48
 FOR STREAM PHASING REQUIREMENTS

STA. 52+70 TO STA. 52+90

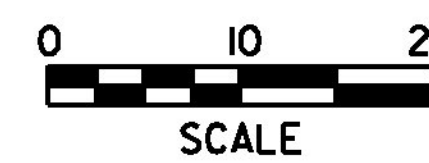

PROJECT NAME: WOODSTOCK
 PROJECT NUMBER: BRF 015(21)

FILE NAME: z10c426xs.dgn
 PROJECT LEADER: G. BOGUE
 DESIGNED BY: T. KNIGHT
 CHANNEL CROSS SECTIONS - CXS 4

PLOT DATE: 9/2/2015
 DRAWN BY: L. BUXTON
 CHECKED BY: J. HUNGERFORD
 SHEET 40 OF 50