


NOTES:
 1. ONE TREE AT STATION 4 + 22 LT SHALL BE REMOVED. ALL REMAINING TREES SHALL BE PROTECTED IN ACCORDANCE WITH SECTION 656.10.
 2. REFER TO CROSS SECTIONS FOR FINAL GRADE.

EPSC FINAL CONDITIONS PLAN



PROJECT NAME:	WOODSTOCK	FILE NAME:	z10c426bdr_EPSCfinal.dgn	PLOT DATE:	9/2/2015
PROJECT NUMBER:	BRF 015(21)	PROJECT LEADER:	G. BOGUE	DRAWN BY:	E. ALLING
		DESIGNED BY:	E. ALLING	CHECKED BY:	I. MAYNARD
		EPSC FINAL CONDITIONS PLAN - FCP 1			SHEET 44 OF 50

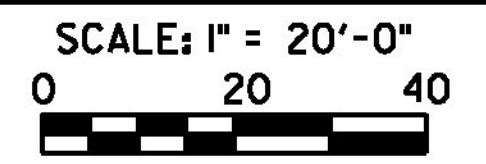