

Vermont Agency of Transportation

RECEIVED

ON: **January 7, 2016**

and Checked for

CONFORMANCE



BY: Rob Young DATE: 01/14/2016

X



APPROVED: Approval of drawings and/or procedures indicates concurrence with the information presented and does not relieve the Contractor or Fabricator of compliance with all specifications and code requirements	
APPROVED AS NOTED	
REVISE AND RESUBMIT	
NOT REVIEWED	
Date: 1/13/16	
By: <i>John E. Kline</i>	

Review by Stantec Consulting Services Inc. is for the sole purpose of ascertaining conformance with the general design concept. This review shall not mean that Stantec Consulting Services Inc. approves the detail design inherent in the shop drawings, responsibility for which shall remain with the Contractor. Submitting same, and such review shall not relieve the Contractor of his responsibility for errors or omissions in the shop drawing or of his responsibility for meeting all requirements of the Contract Documents. The contractor is responsible for dimensions to be confirmed and correlated at the job site, for information that pertains solely to the fabrication processes or to techniques of construction and installation and for coordination of the work of all subtrades.

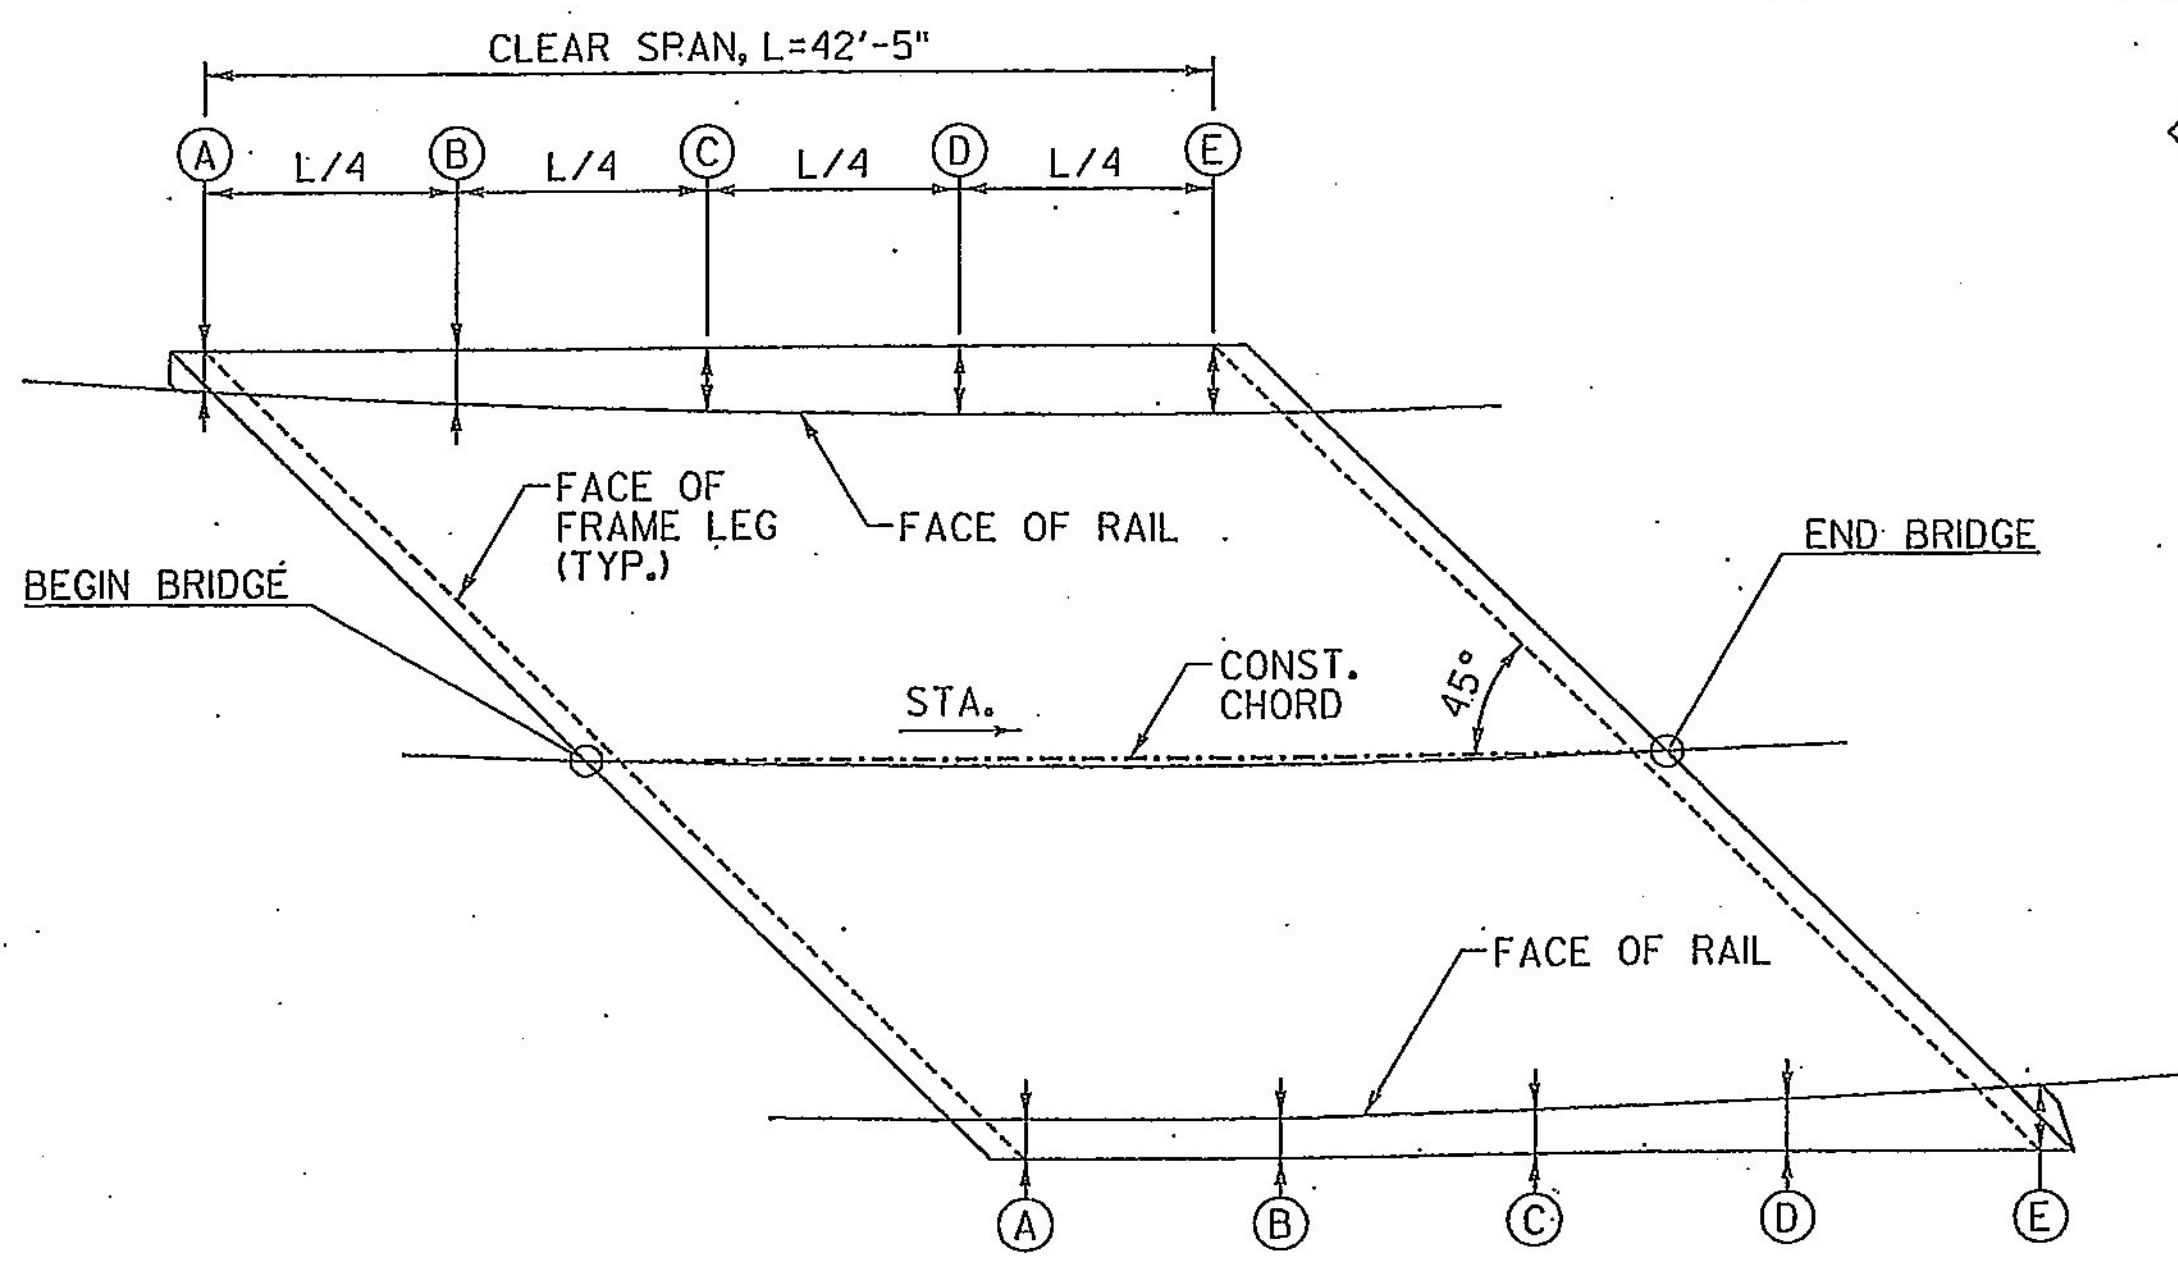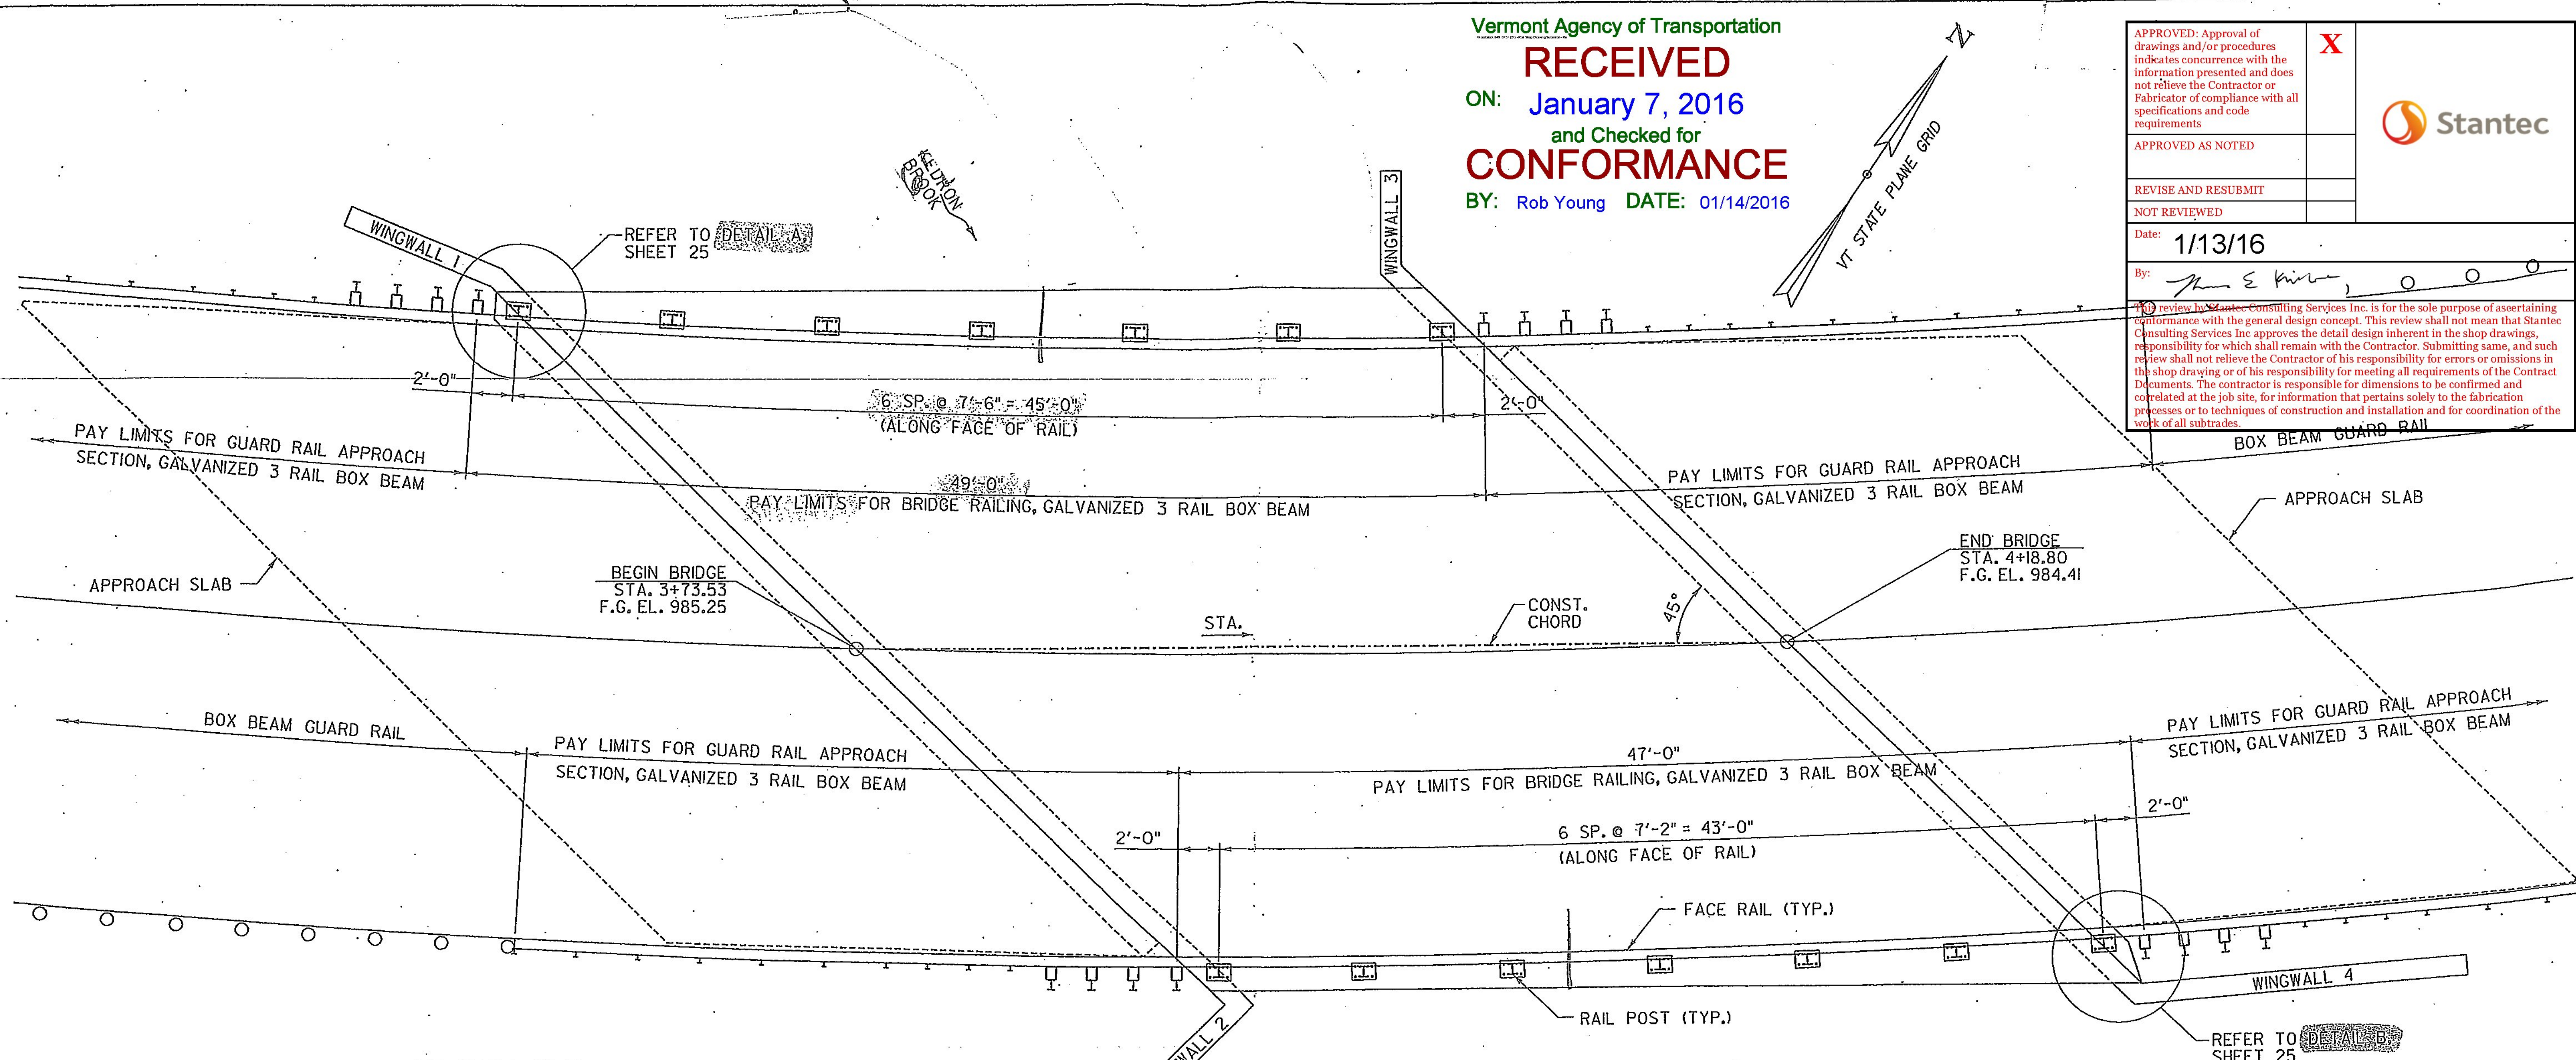

FACE OF RAIL TO FASCIA OFFSET
NOT TO SCALE

BRIDGE RAIL LAYOUT
SCALE: 1/4" = 1'-0"

POINT	OFFSET TO LEFT FASCIA (FT)	OFFSET TO RIGHT FASCIA (FT)
A	1.73	1.68
B	2.31	1.69
C	2.7	1.88
D	2.92	2.23
E	2.96	2.76

NOTE:
RAIL POST SPACING IS BASED ON ASSUMED FRAME LEG THICKNESS OF 1'-0". THE FABRICATOR SHALL ADJUST DIMENSIONS AS NECESSARY BASED ON ACTUAL FRAME LEG THICKNESS USED.

ITEM #: 525.335

STRUCTURAL STEEL TO COMPLY W/ ASTM A6.

TOLERANCE UNLESS OTHERWISE NOTED:
FRACTIONS = ± 1/16"
ANGLES = ± 1/2"
DIAMETERS = ± 1/32"

SHEET 4 OF 4

BRIDGE RAIL DETAILS SHEET
VERMONT ROUTE 108 (MAJOR COLLECTOR, RURAL), BRIDGE # 24
TOWN OF WOODSTOCK, COUNTY OF WINDSOR, VT.

R NO.	DATE	DESCRIPTION	BY	R NO.	DATE	DESCRIPTION	BY

ELDERLEE, INC.
OAKS CORNERS, NEW YORK 14518
email: dlong@elderlee.com / epeck@elderlee.com
Tel: 815-789-8870 Fax: 815-789-8815

APPROVED: *[Signature]*
SCALE: SCHEMATIC
DRAWING NO. FR.LAFAYETTE-WOODSTOCK/16