


**GUARD RAIL TO BRIDGE RAIL TRANSITION**

NORTH TRANSITION TO HAVE 620' CONVEX RADIUS,  
SOUTH TRANSITION TO HAVE 650' CONCAVE RADIUS.

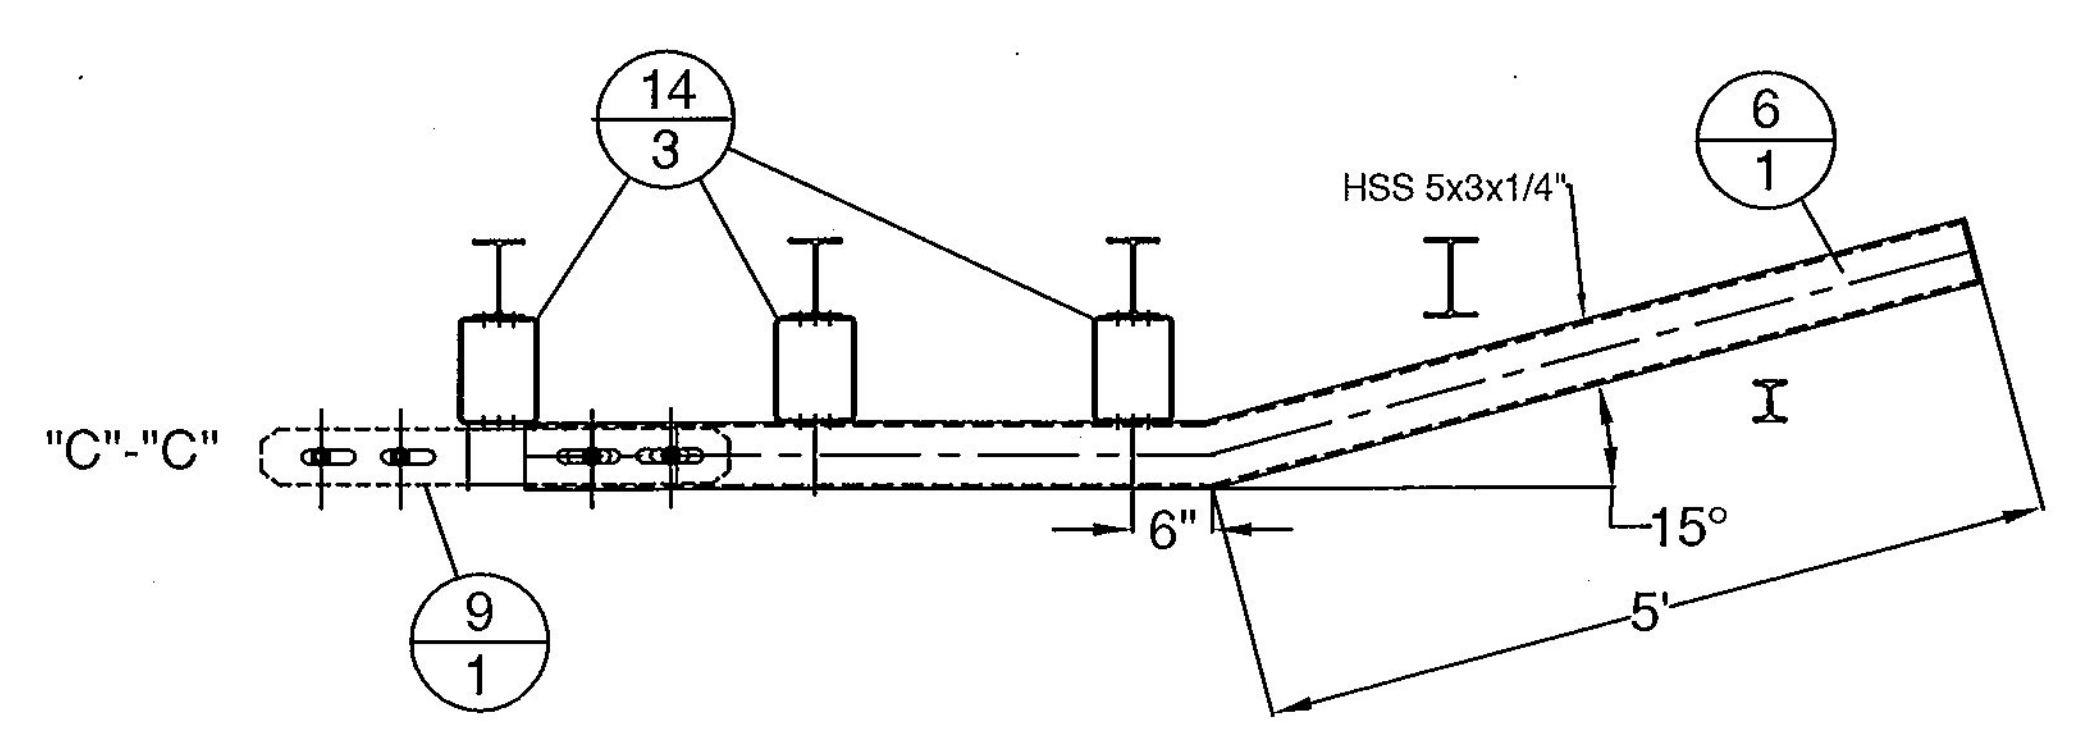

Vermont Agency of Transportation  
**RECEIVED**  
ON: **January 7, 2016**  
and Checked for  
**CONFORMANCE**  
BY: **Rob Young** DATE: **01/14/2016**

APPROVED: Approval of drawings and/or procedures indicates concurrence with the information presented and does not relieve the Contractor or Fabricator of compliance with all specifications and code requirements.

APPROVED AS NOTED

REVISE AND RESUBMIT

NOT REVIEWED

Date: **1/13/16**

By: *[Signature]*

This review by Stantec Consulting Services Inc. is for the sole purpose of ascertaining conformance with the general design concept. This review shall not mean that Stantec Consulting Services Inc. approves the detail design inherent in the shop drawings, responsibility for which shall remain with the Contractor. Submitting same, and such review shall not relieve the Contractor of his responsibility for errors or omissions in the shop drawing or of his responsibility for meeting all requirements of the Contract Documents. The contractor is responsible for dimensions to be confirmed and correlated at the job site, for information that pertains solely to the fabrication, processes or to techniques of construction and installation and for coordination of the work of all subtrades.

**Stantec**

ITEM #: 621.725  
STRUCTURAL STEEL TO COMPLY W/ ASTM A6  
TOLERANCE UNLESS OTHERWISE NOTED:  
FRACTIONS = ± 1/16"  
ANGLES = ± 1/2"  
DIAMETERS = ± 1/32"

SHEET 1 OF 5

**GUARD RAIL TO BRIDGE RAIL TRANSITION DETAILS SHEET**  
VERMONT ROUTE 106 (MAJOR COLLECTOR, RURAL), BRIDGE # 24  
TOWN OF WOODSTOCK, COUNTY OF WINDSOR, VT.

R NO.	DATE	DESCRIPTION	BY	R NO.	DATE	DESCRIPTION	BY
E 1	12/29/15	Revised Per 12/18/15 Markup	E.P.				

**ELDERLEE, INC.**  
OAKS CORNERS, NEW YORK 14518  
email: [dlong@elderlee.com](mailto:dlong@elderlee.com) / [epesk@elderlee.com](mailto:epesk@elderlee.com)  
Tel: 315-789-6670 Fax: 315-789-6615

ORTHOGONOGRAPHIC PROJECTION

DRAWN	E.P.	11/30/15
CHECKED	D.L.	11/30/15
APPROVED		
SCALE	SCHEMATIC	

DRAWING NO. F.R. LaFAYETTE-WOODSTOCK (21)