

BITUMINOUS CONCRETE PAVEMENT SUPERPAVE DESIGN MIXTURE CRITERIA	
DESIGN LIFE ESAL'S (DESIGN LANE)	2,029,040
DESIGN NUMBER OF GYRATIONS	65
PERFORMANCE GRADED ASPHALT BINDER	SEE SUBSECTION 490.03(b)


INDEX OF SHEETS
SEE SHEET 2 FOR INDEX OF SHEETS AND STANDARDS LIST

RECORD PLANS	
CONTRACTOR:	B.U.R. CONSTRUCTION, LLC, CLAREMONT, NH
RESIDENT ENGINEER:	PETER HODGSON
CONSTRUCTION BEGAN:	MAY 30, 2014
CONSTRUCTION COMPLETE:	MAY 28, 2015
RECORD PLANS BY:	PETER HODGSON & KEVIN KING
I HEREBY CERTIFY THAT ALL THE CONSTRUCTION REQUIRED BY THIS SET OF DRAWINGS HAS BEEN ACCOMPLISHED AS INDICATED HEREIN.	
BY:	<i>Peter Hodgson</i> RESIDENT ENGINEER
DATE:	March 5, 2018
NOTE: Any further information concerning final quantities, amounts or other details relative to this project may be found at Central Files in the electronic archives.	


STATE OF VERMONT AGENCY OF TRANSPORTATION



PROPOSED IMPROVEMENT TOWN OF BARRE COUNTY OF WASHINGTON VT ROUTE 14 (MINOR ARTERIAL)

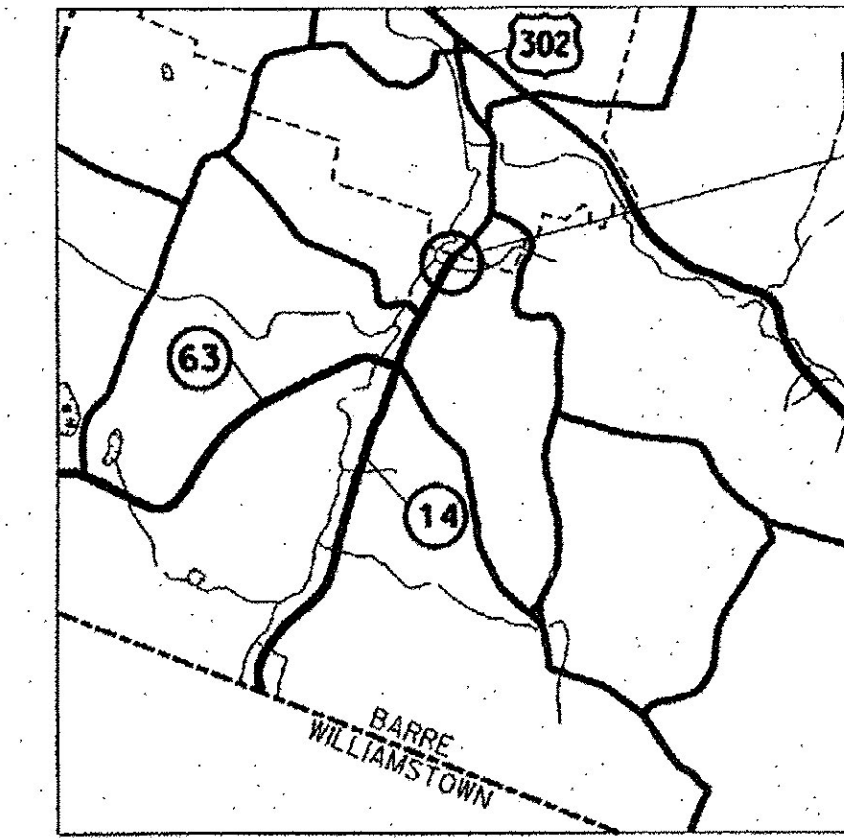


0 1.0 2.0 3.0
SCALE IN MILES

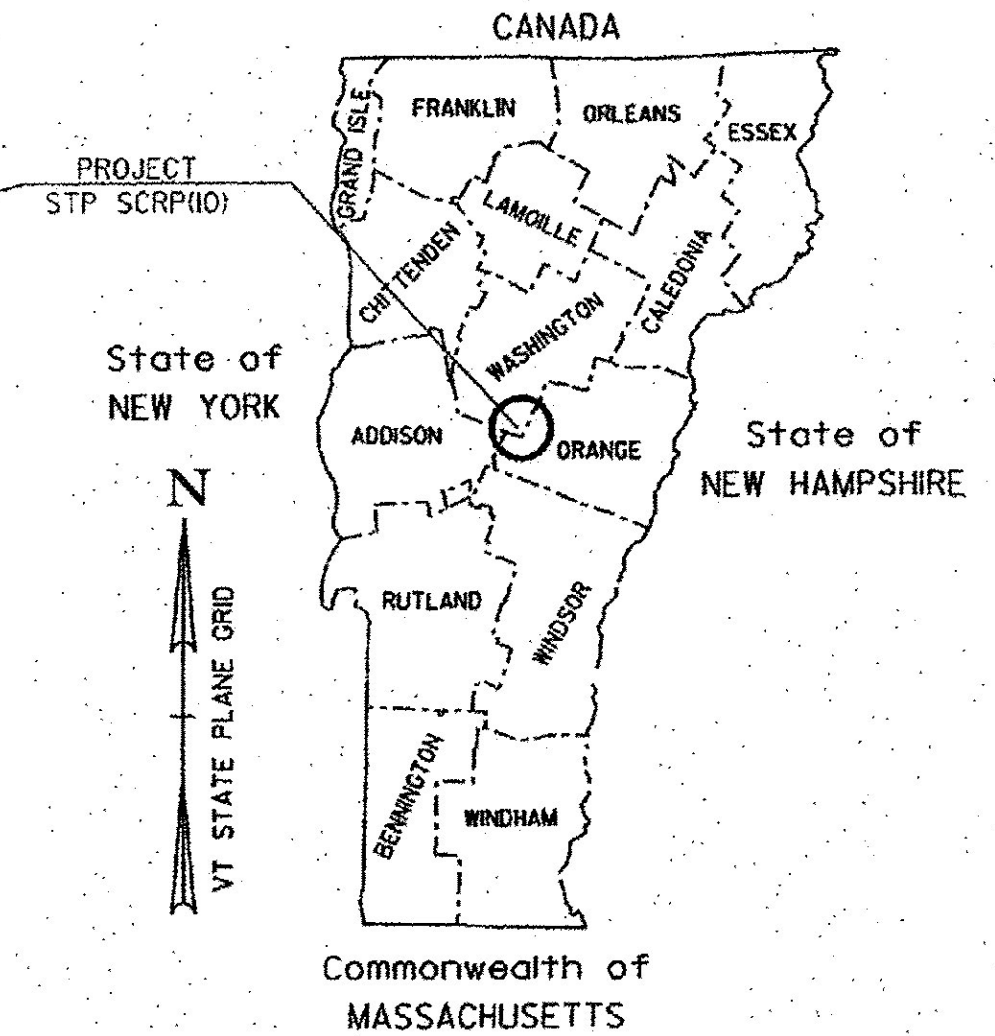

PROJECT LOCATION: BEGINNING IN THE TOWN OF BARRE ON VT ROUTE 14, AT STATION 118+00.00 (MM 2.235) AND EXTENDING NORTHERLY APPROXIMATELY 200' (0.038 MILE) TO STATION 120+00.00 (MM 2.273)

LENGTH OF ROADWAY = 193.00 FEET = 0.037 MILES
LENGTH OF BRIDGE = 7.00 FEET = 0.001 MILES
LENGTH OF PROJECT = 200.00 FEET = 0.038 MILES

PROJECT DESCRIPTION: WORK TO BE PERFORMED UNDER THIS PROJECT INCLUDES REMOVAL OF AN EXISTING STONE BOX CULVERT, CONCRETE HEADWALLS, INSTALLATION OF A NEW PRECAST CONCRETE BOX CULVERT, PAVEMENT, SUBBASE, STEEL BEAM GUARDRAIL AND OTHER HIGHWAY RELATED ITEMS.

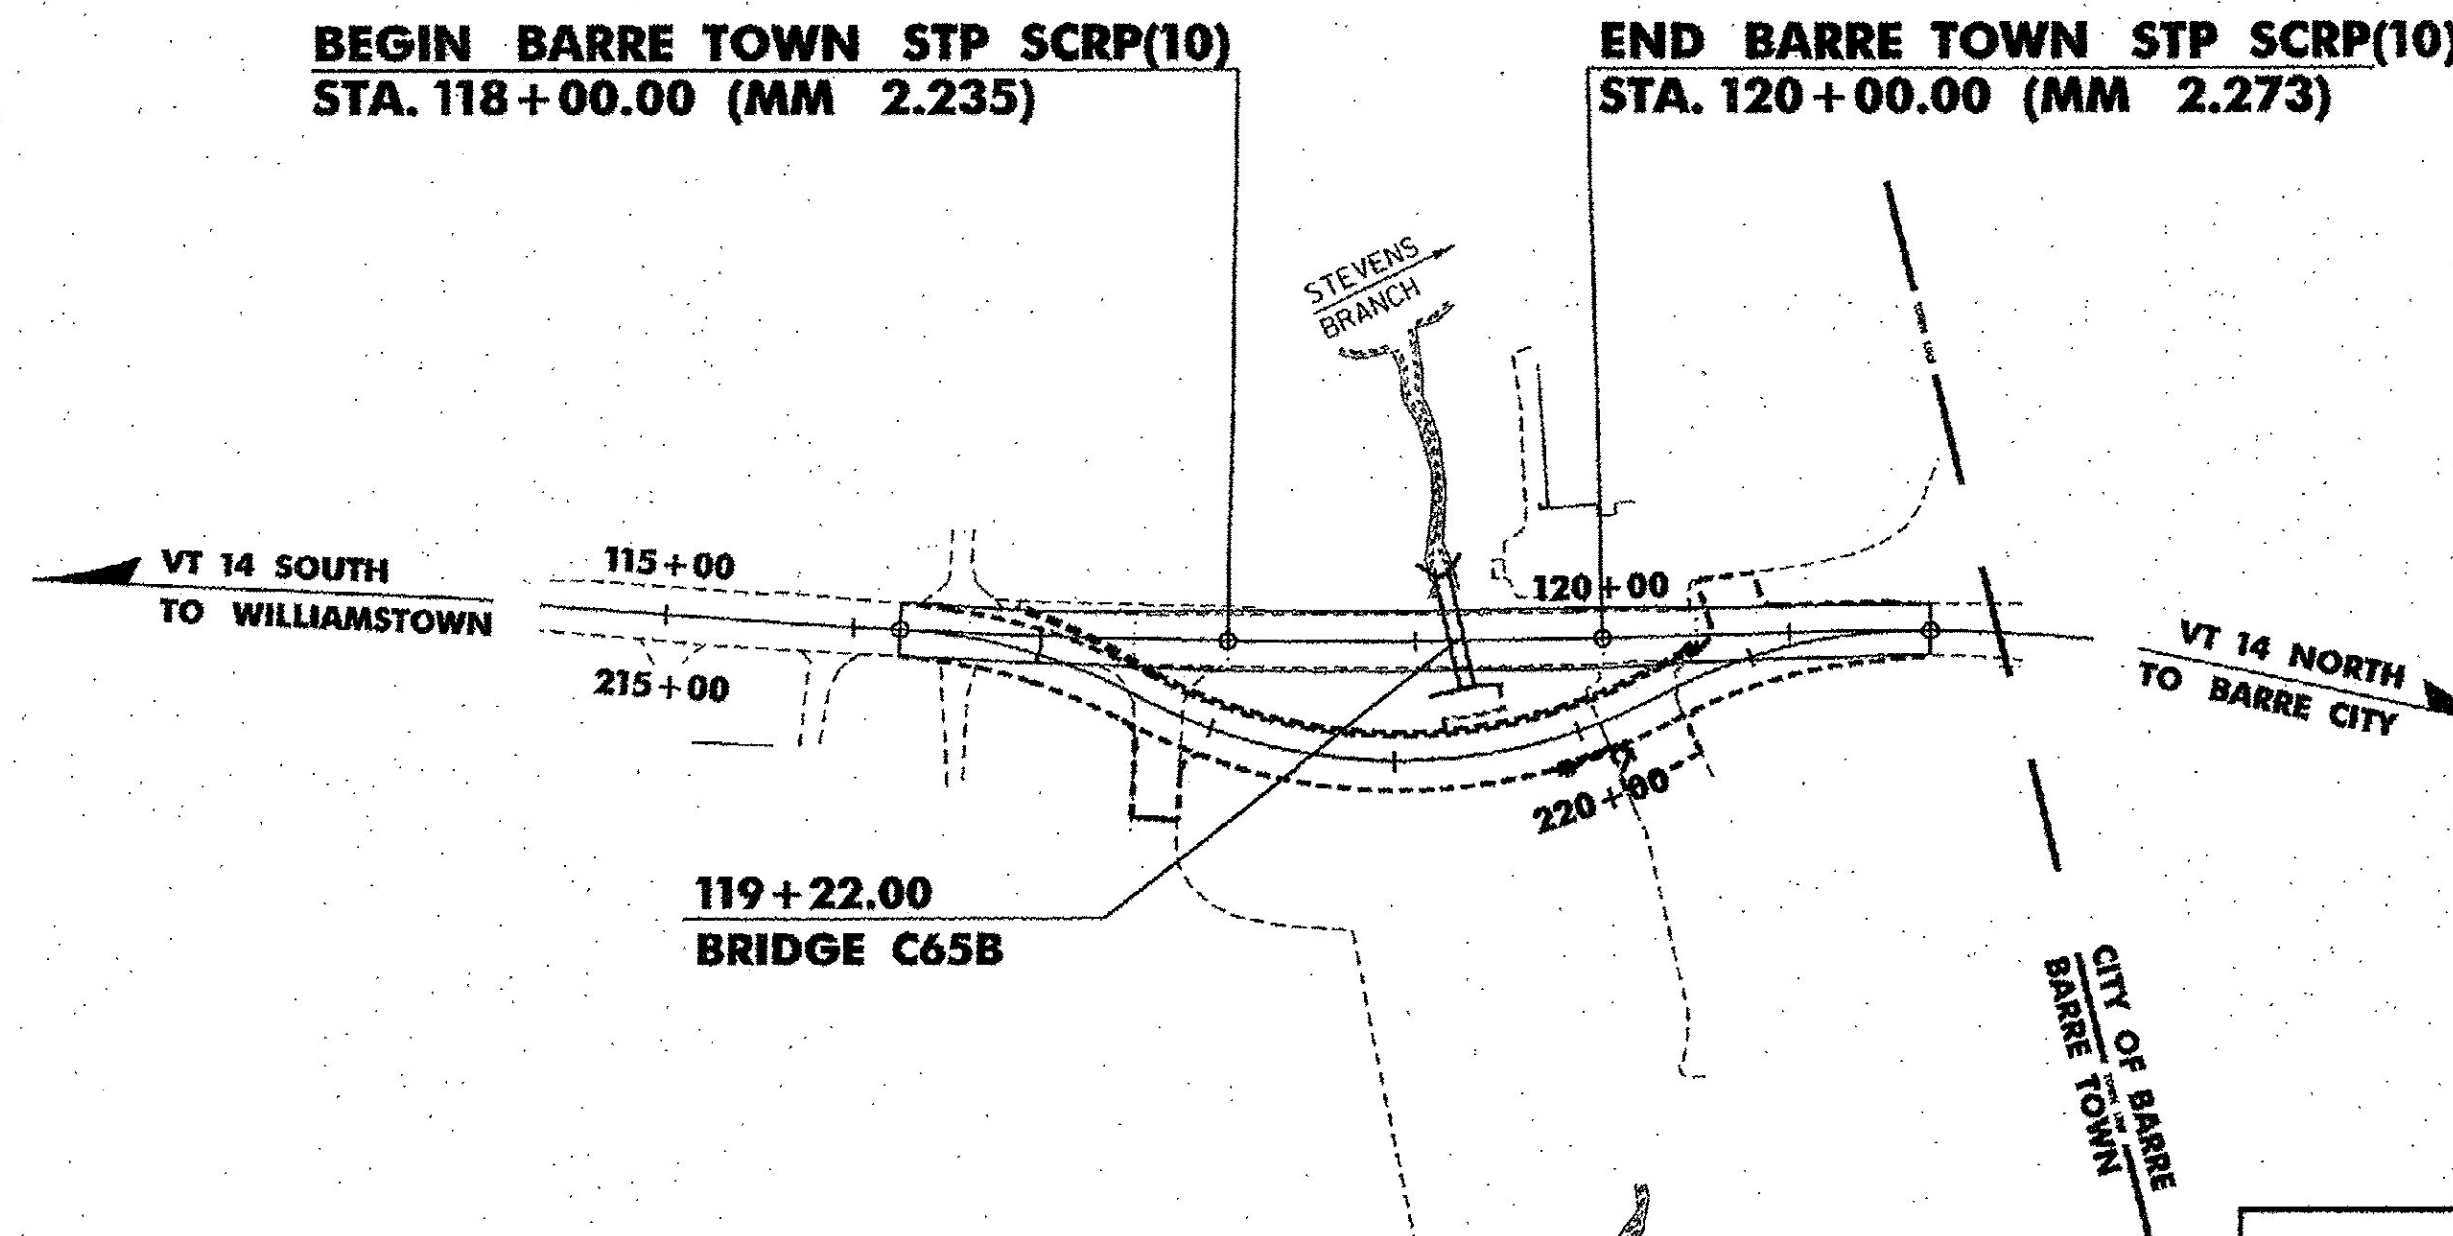

0 100 200
SCALE IN FEET

THESE PLANS ARE SUBJECT TO SUCH ENGINEERING CHANGES AS MAY BE REQUIRED BY THE FEDERAL HIGHWAY ADMINISTRATION OR THE DIRECTOR OF PROGRAM DEVELOPMENT.



CONSTRUCTION IS TO BE CARRIED ON IN ACCORDANCE WITH THESE PLANS AND THE STANDARD SPECIFICATIONS FOR CONSTRUCTION DATED 2011, AS APPROVED BY THE FEDERAL HIGHWAY ADMINISTRATION ON JULY 20, 2011 FOR USE ON THIS PROJECT, INCLUDING ALL SUBSEQUENT REVISIONS AND SUCH REVISED SPECIFICATIONS AND SPECIAL PROVISIONS AS ARE INCORPORATED IN THESE PLANS.

QUALITY ASSURANCE PROGRAM : LEVEL 2

SURVEYED BY : P. WINTERS
SURVEYED DATE : 10/11/2010

DATUM

VERTICAL NAVD88
HORIZONTAL NAD 83 (1992)

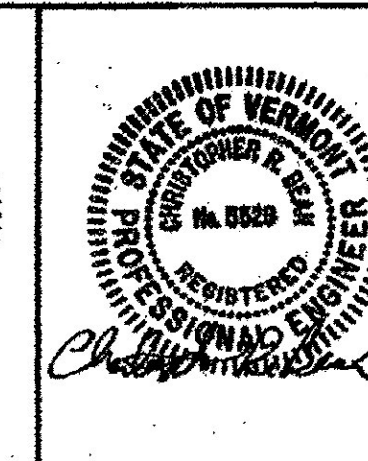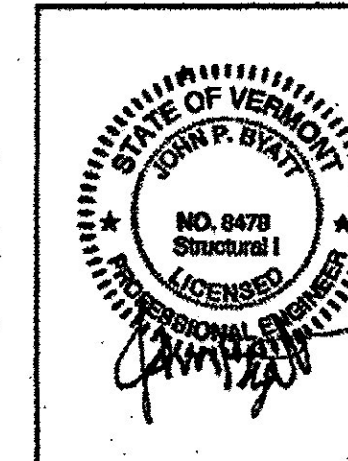

DIRECTOR OF PROGRAM DEVELOPMENT
APPROVED: *Ken Upmal* DATE: 2/12/14
PROJECT MANAGER : KEN UPMAL, P.E.
PROJECT NAME : BARRE TOWN
PROJECT NUMBER : STP SCRPI(10)
SHEET 1 OF 43 SHEETS

CLD 11-0160