


**MATERIAL TOLERANCES**


PAVEMENT (TOTAL DEPTH)	± 1/4"
SUBBASE (TOTAL DEPTH)	± 1"
SAND BORROW (TOTAL DEPTH)	± 1"

- 1 1/2" SUPERPAVE BITUMINOUS CONCRETE PAVEMENT, TYPE IVS WEARING COURSE
- 2 3/4" SUPERPAVE BITUMINOUS CONCRETE PAVEMENT, TYPE IIS INTERMEDIATE COURSE
- 2 3/4" SUPERPAVE BITUMINOUS CONCRETE PAVEMENT, TYPE IIS BASE COURSE
- 24" SUBBASE OF DENSE GRADED CRUSHED STONE
- 18" SAND BORROW

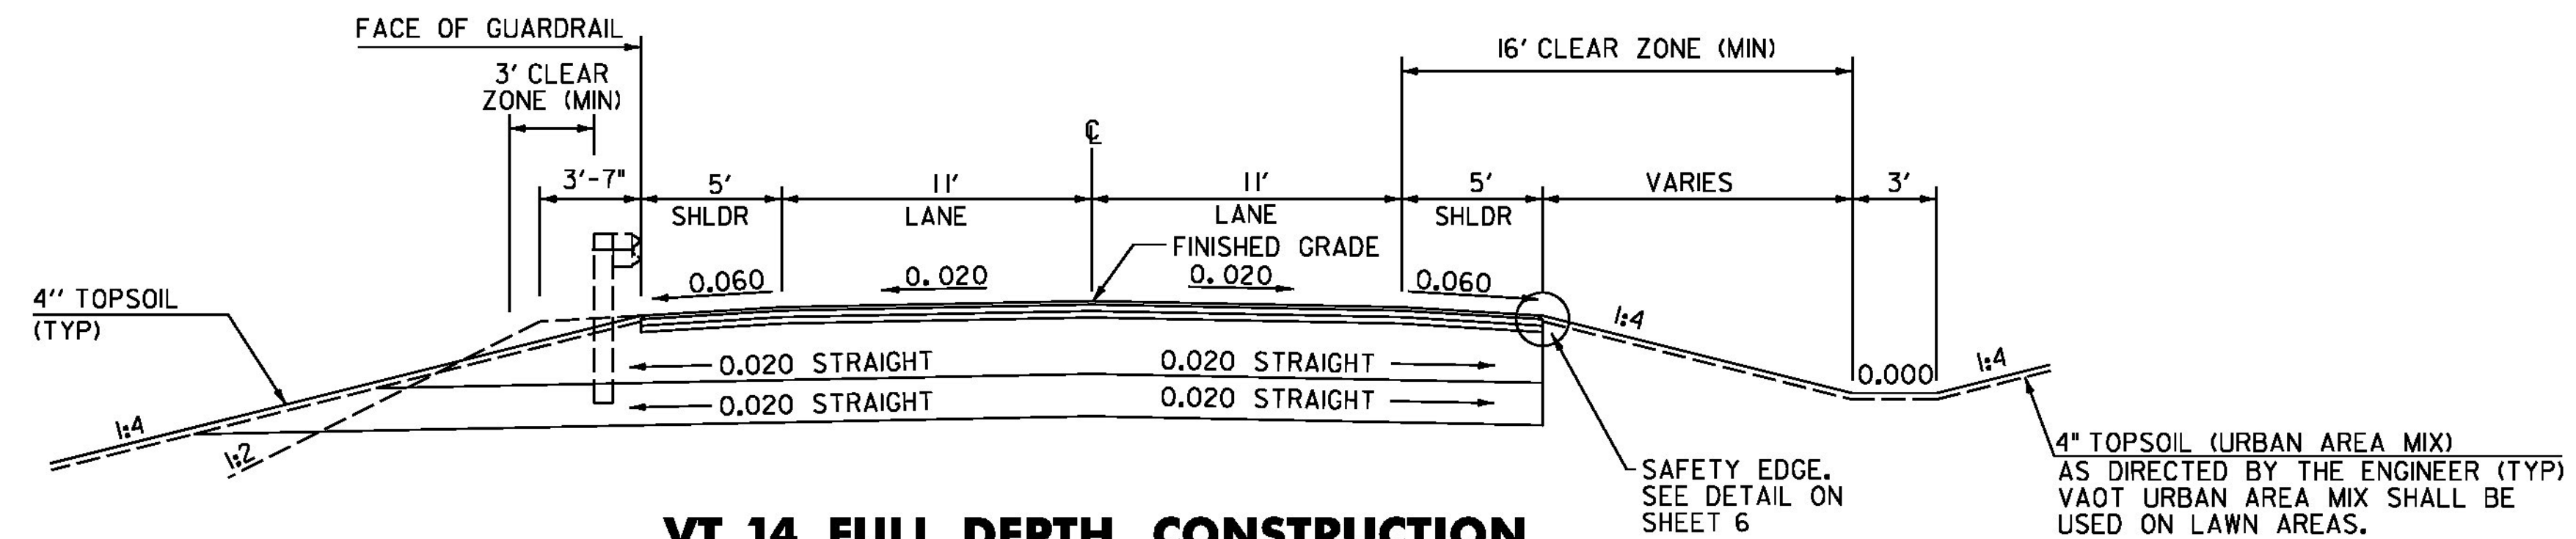


**VT 14 FULL DEPTH CONSTRUCTION**  
**STA 118+00.00 TO 120+00.00**  
 NOT TO SCALE

- 2" COLD PLANE
- 1 1/2" SUPERPAVE BITUMINOUS CONCRETE PAVEMENT, TYPE IVS WEARING COURSE
- 1 1/2" SUPERPAVE BITUMINOUS CONCRETE PAVEMENT, TYPE IVS LEVELING COURSE

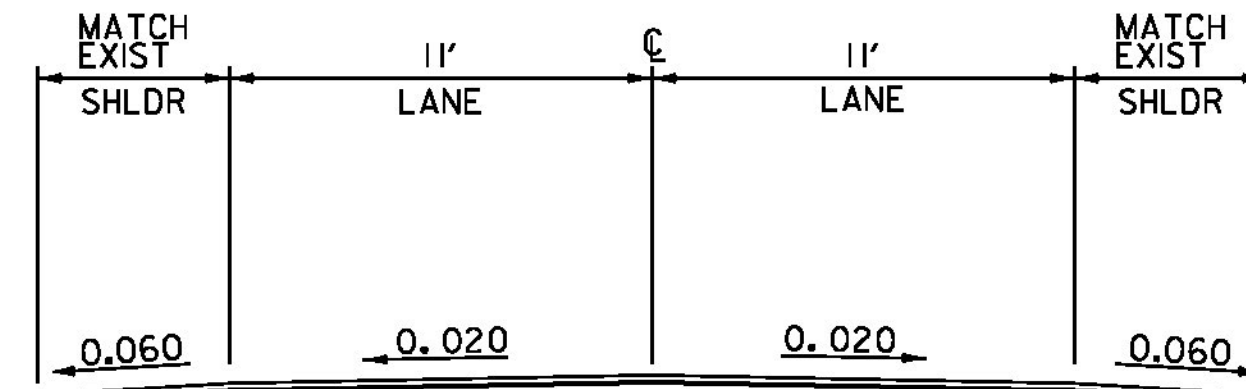

**VT 14 COLD PLANE & OVERLAY**  
**STA 116+25.00 TO 118+00.00**  
**STA 120+00.00 TO 121+75.00**  
 NOT TO SCALE

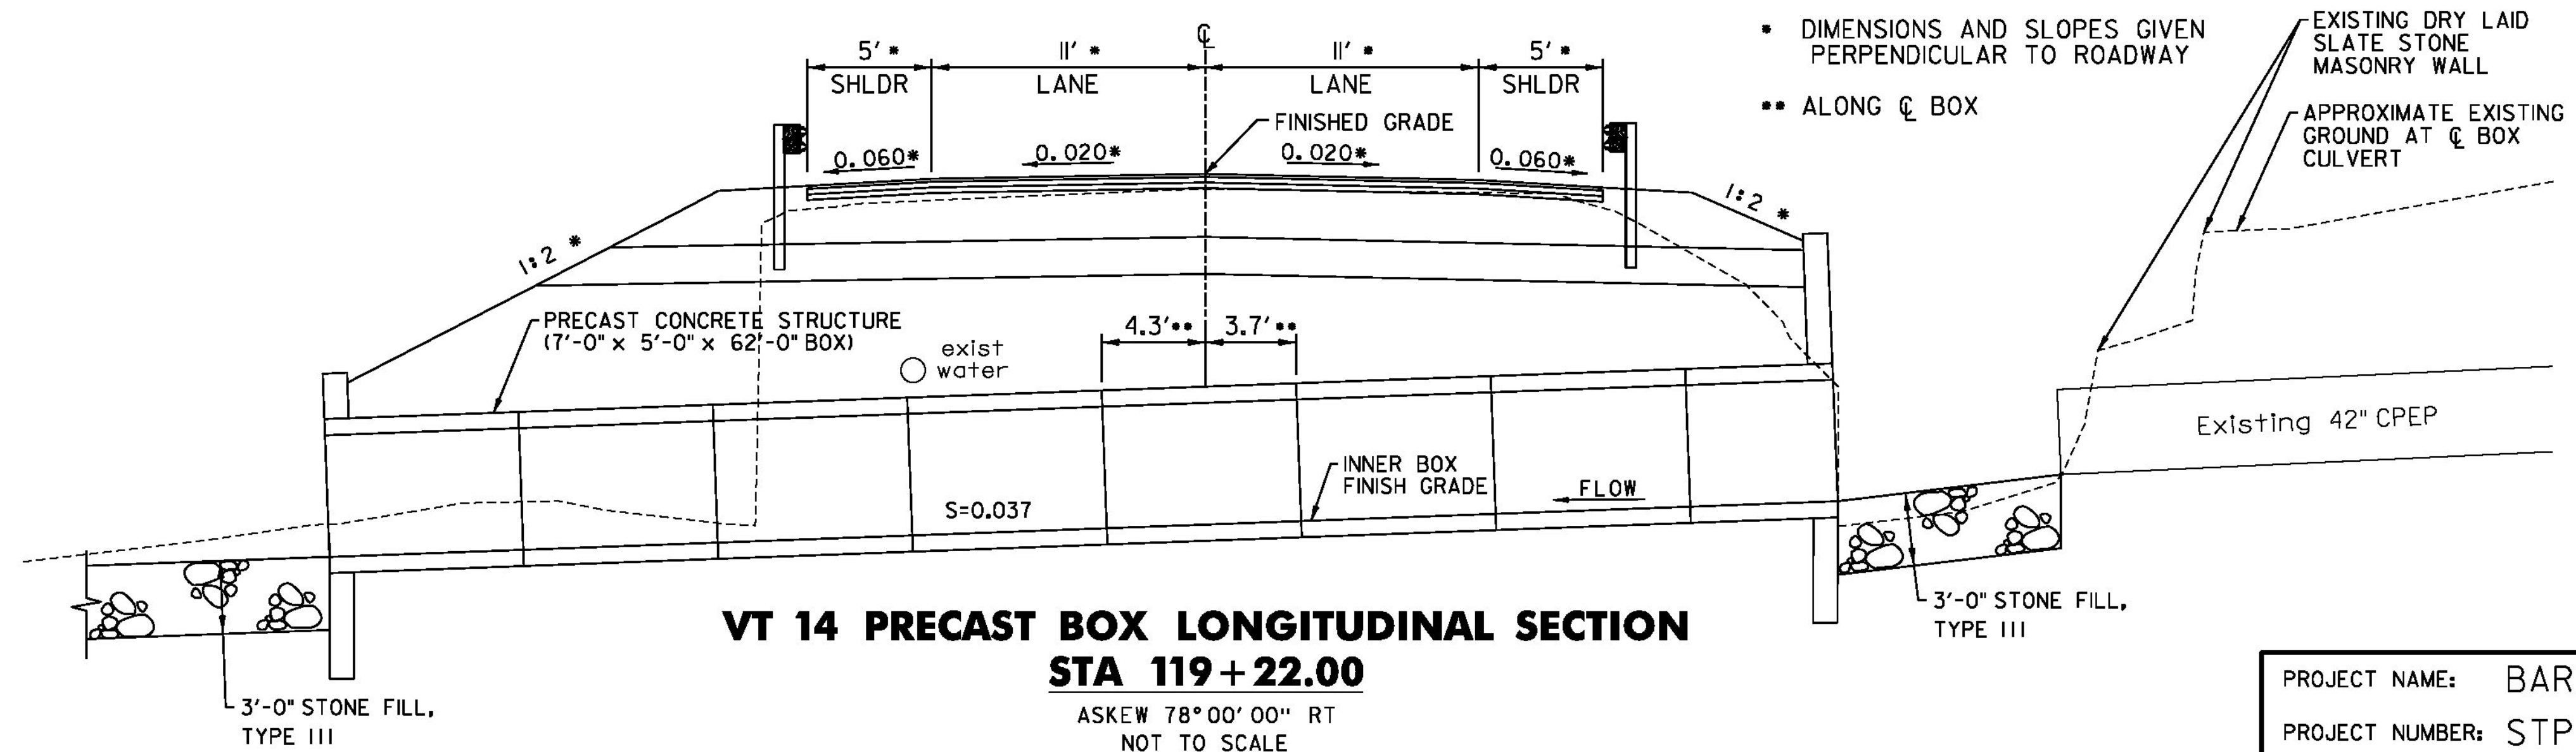

**VT 14 PRECAST BOX LONGITUDINAL SECTION**  
**STA 119+22.00**  
 ASKEW 78° 00' 00" RT  
 NOT TO SCALE

PROJECT NAME:	BARRE TOWN
PROJECT NUMBER:	STP SCR(10)
FILE NAME:	z10d202+yp.dgn
PROJECT LEADER:	K. UPMAL
DESIGNED BY:	P. SHEDD
TYPICAL SECTIONS	
PLOT DATE:	2/13/2014
DRAWN BY:	P. SHEDD
CHECKED BY:	D. MUNRO
SHEET	4 OF 43