

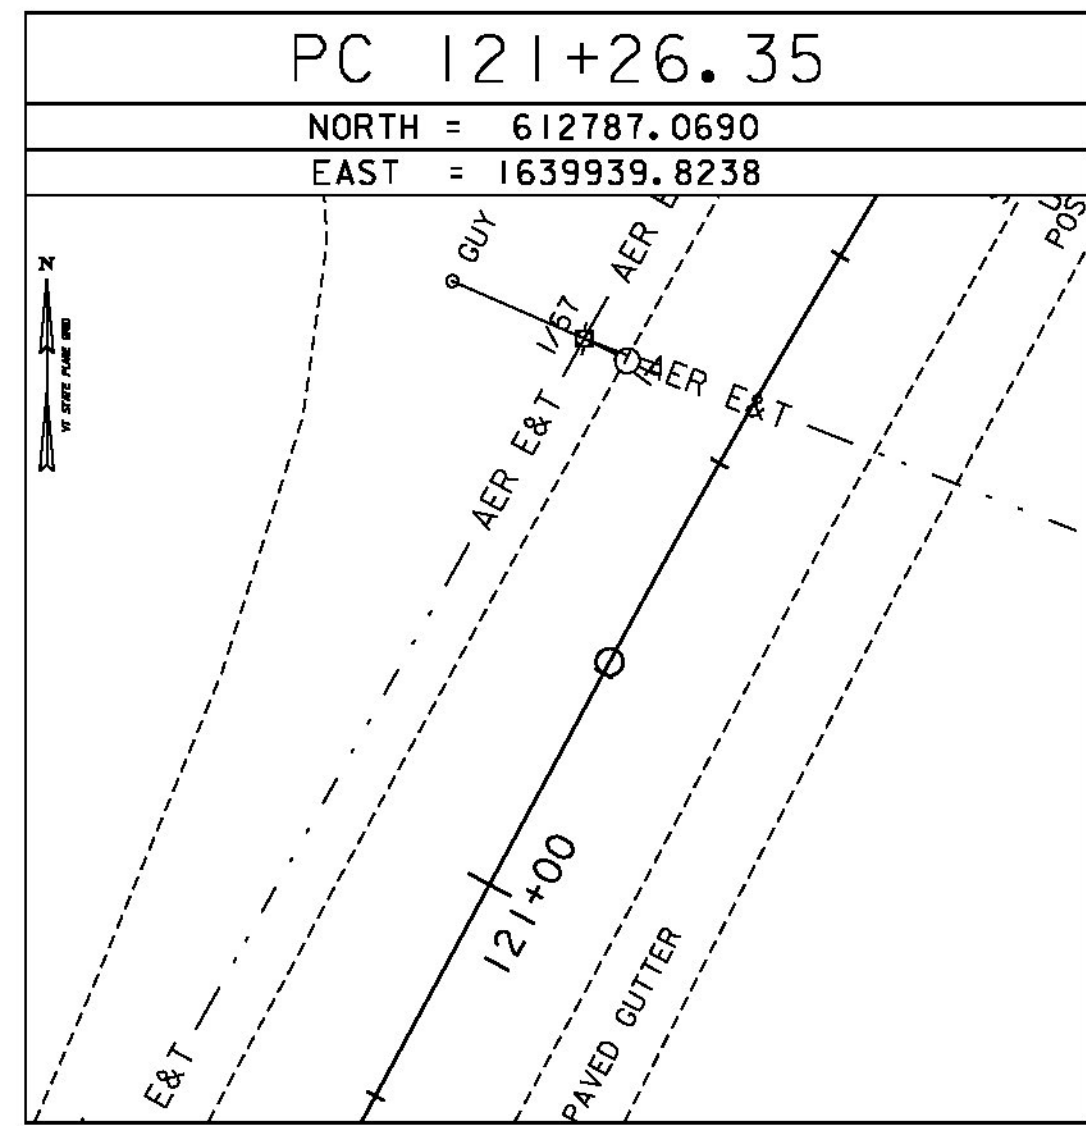
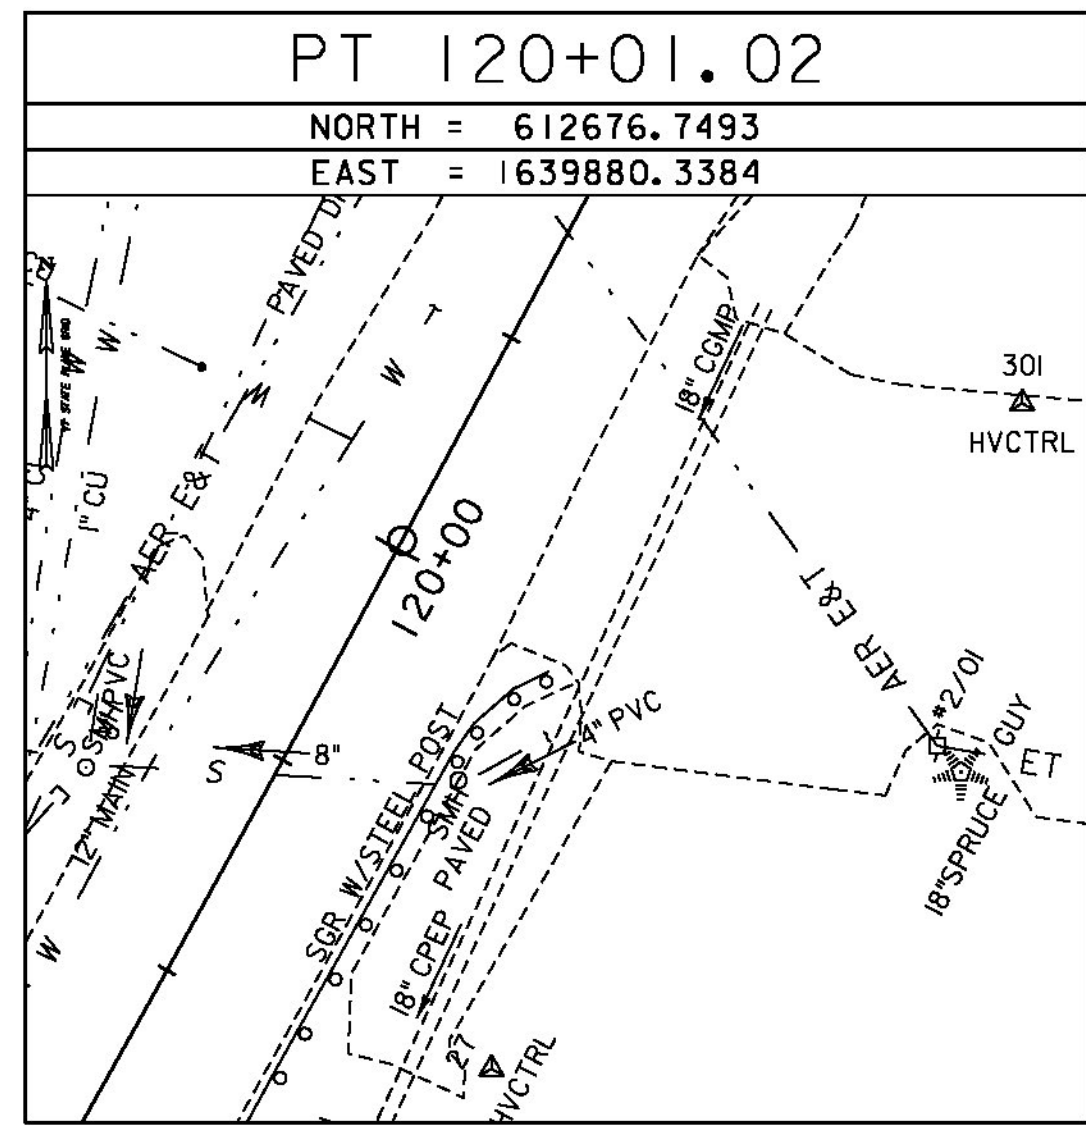
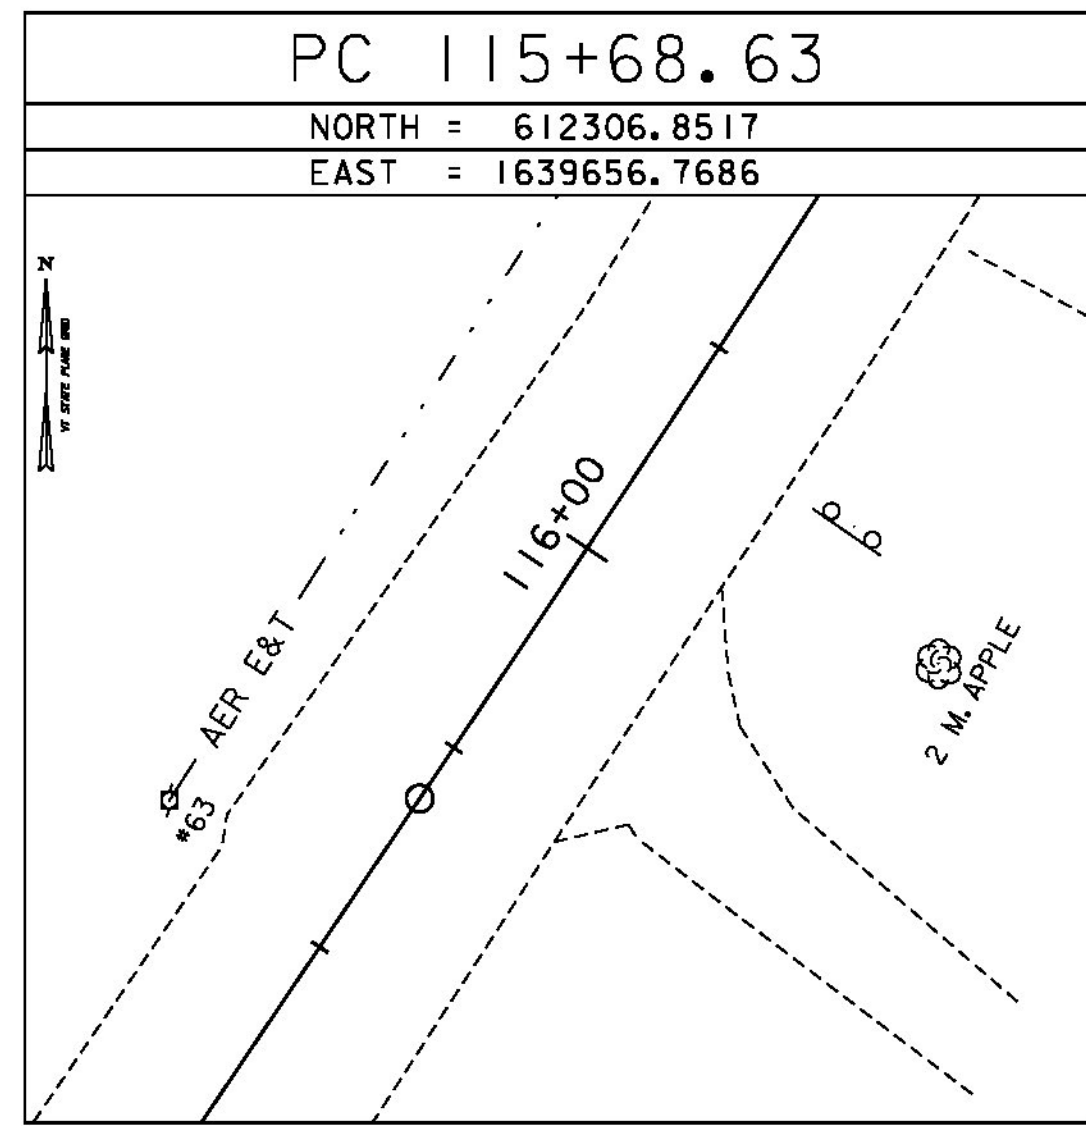
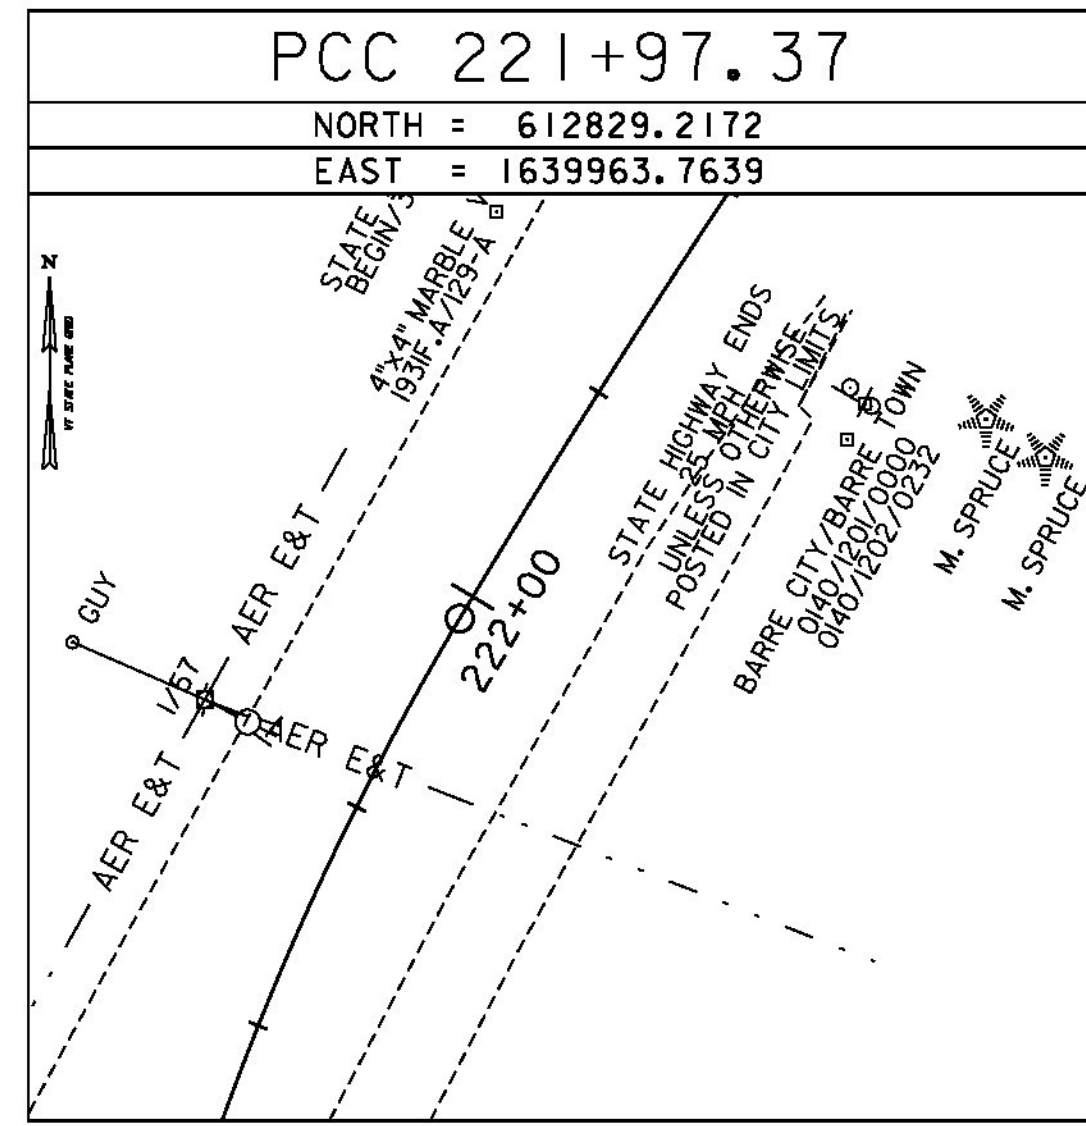
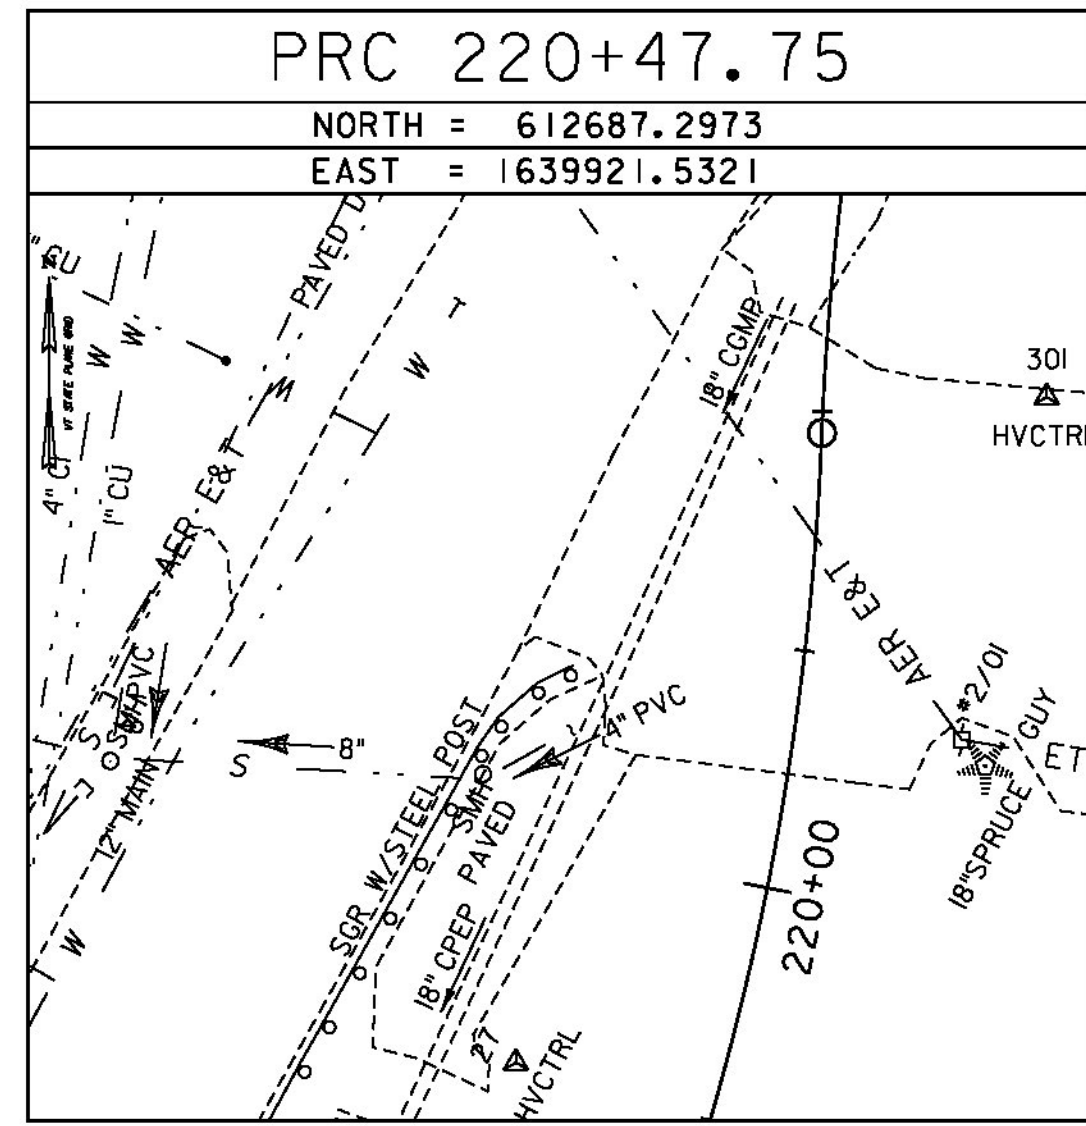


ALIGNMENT TIES

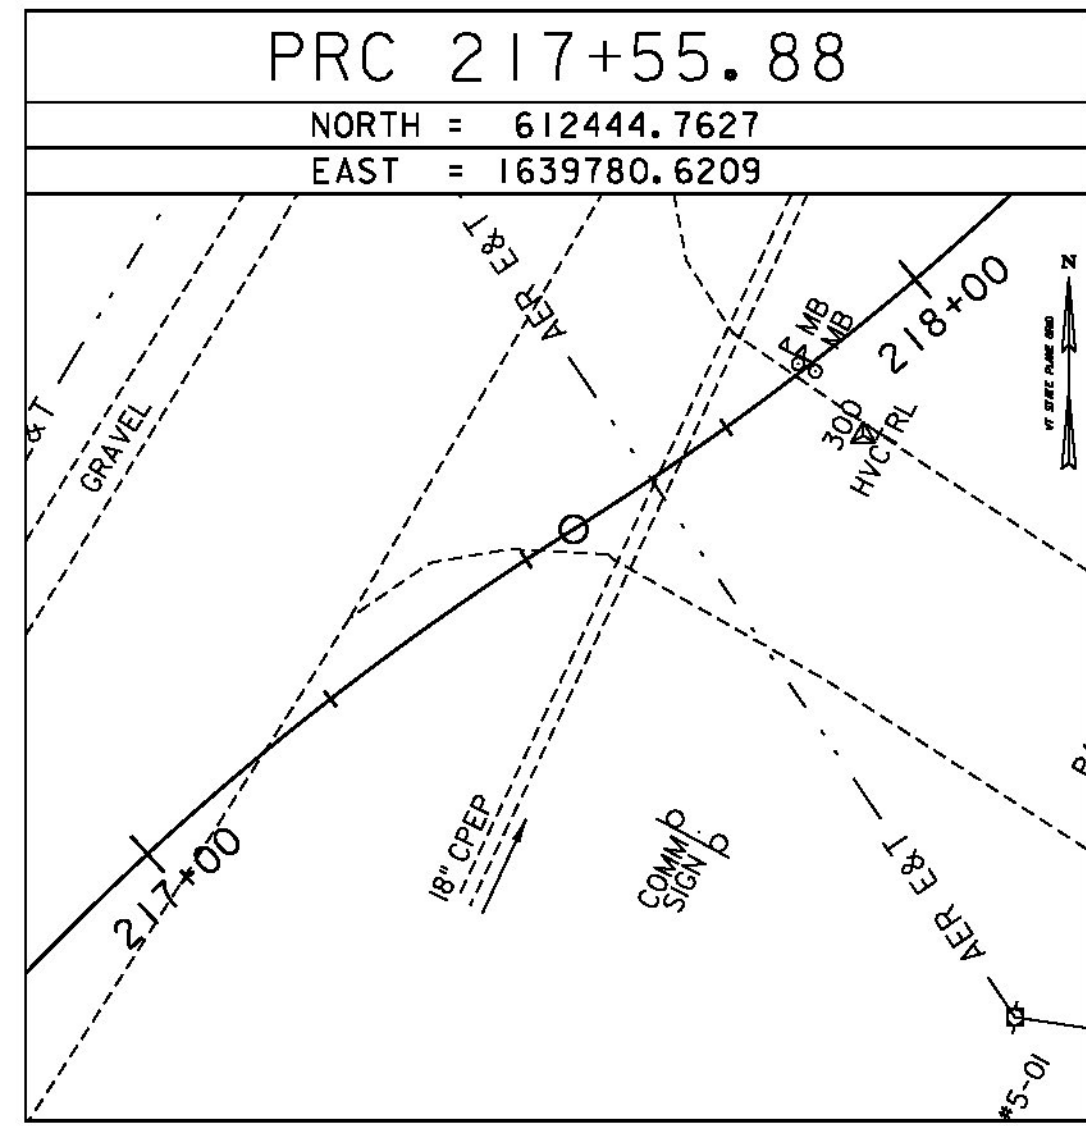

ALIGNMENT TIES

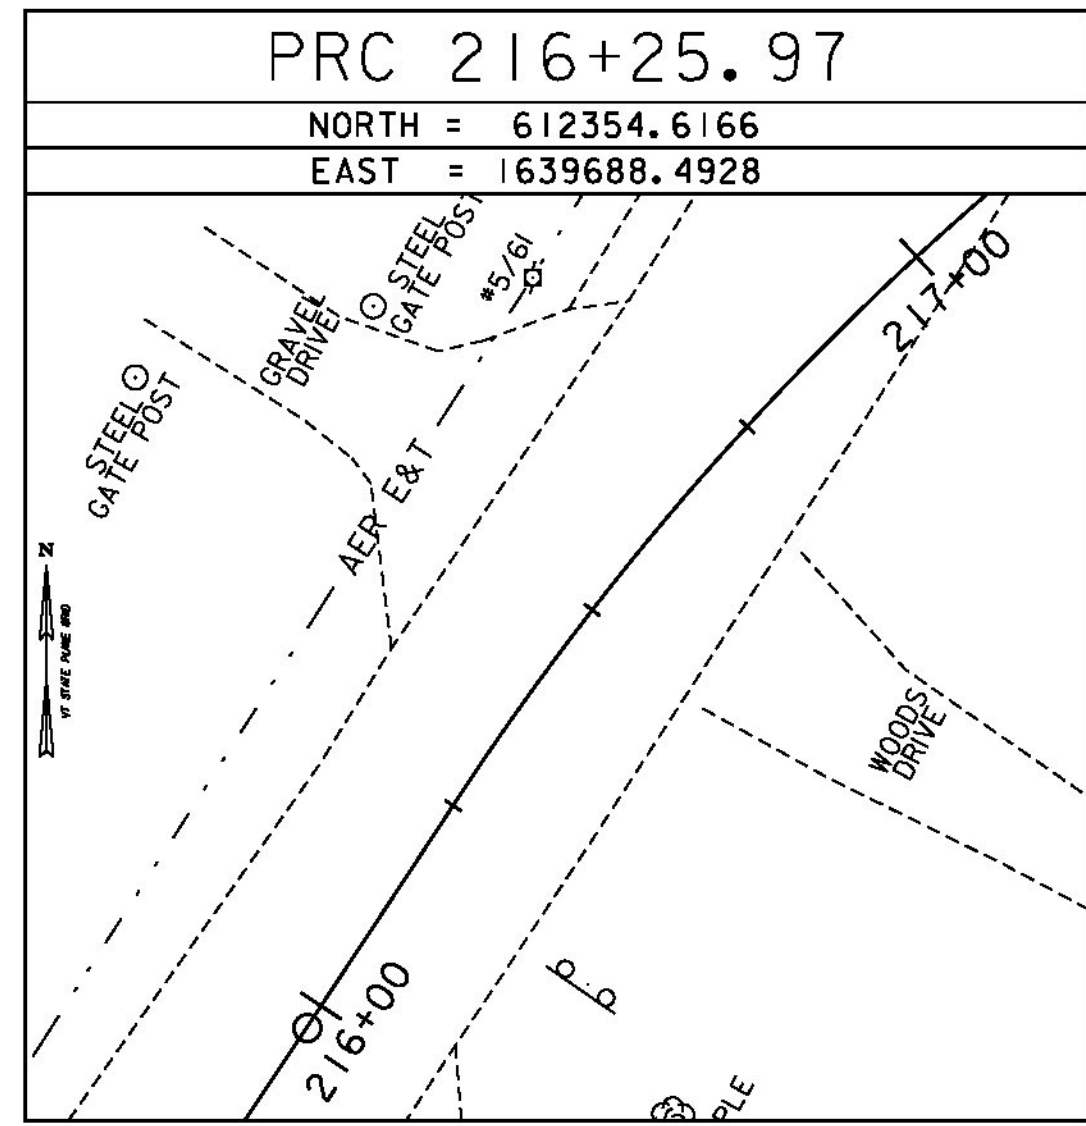

ALIGNMENT TIES

DATUM	
VERTICAL	NAVD 88
HORIZONTAL	NAD 83 (92)
ADJUSTMENT	Compass

PROJECT NAME:	BARRE TOWN
PROJECT NUMBER:	STP SCRPI0
FILE NAME:	z10d202+1.dgn
PROJECT LEADER:	K. UPMAL
DESIGNED BY:	P. SHEDD
TIE SHEET	2
PLOT DATE:	2/13/2014
DRAWN BY:	S. GOODWIN
CHECKED BY:	D. MUNRO
SHEET	8 OF 43