



121+50

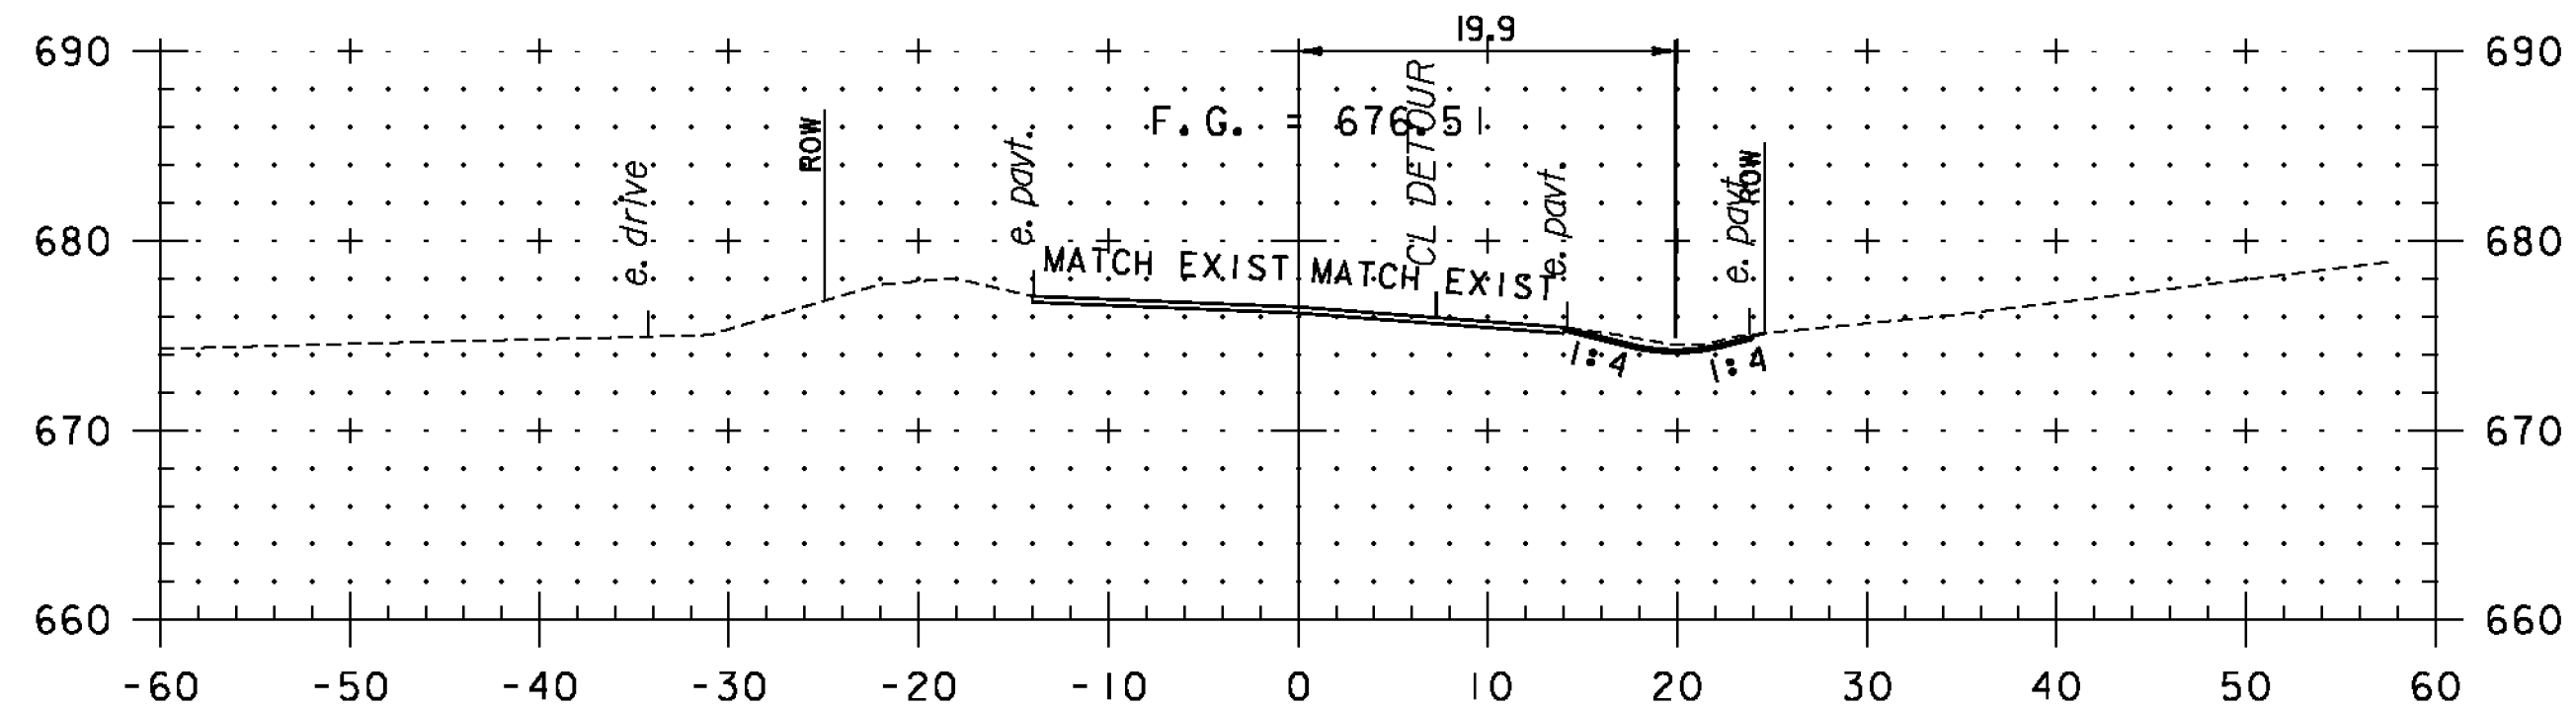


121+00

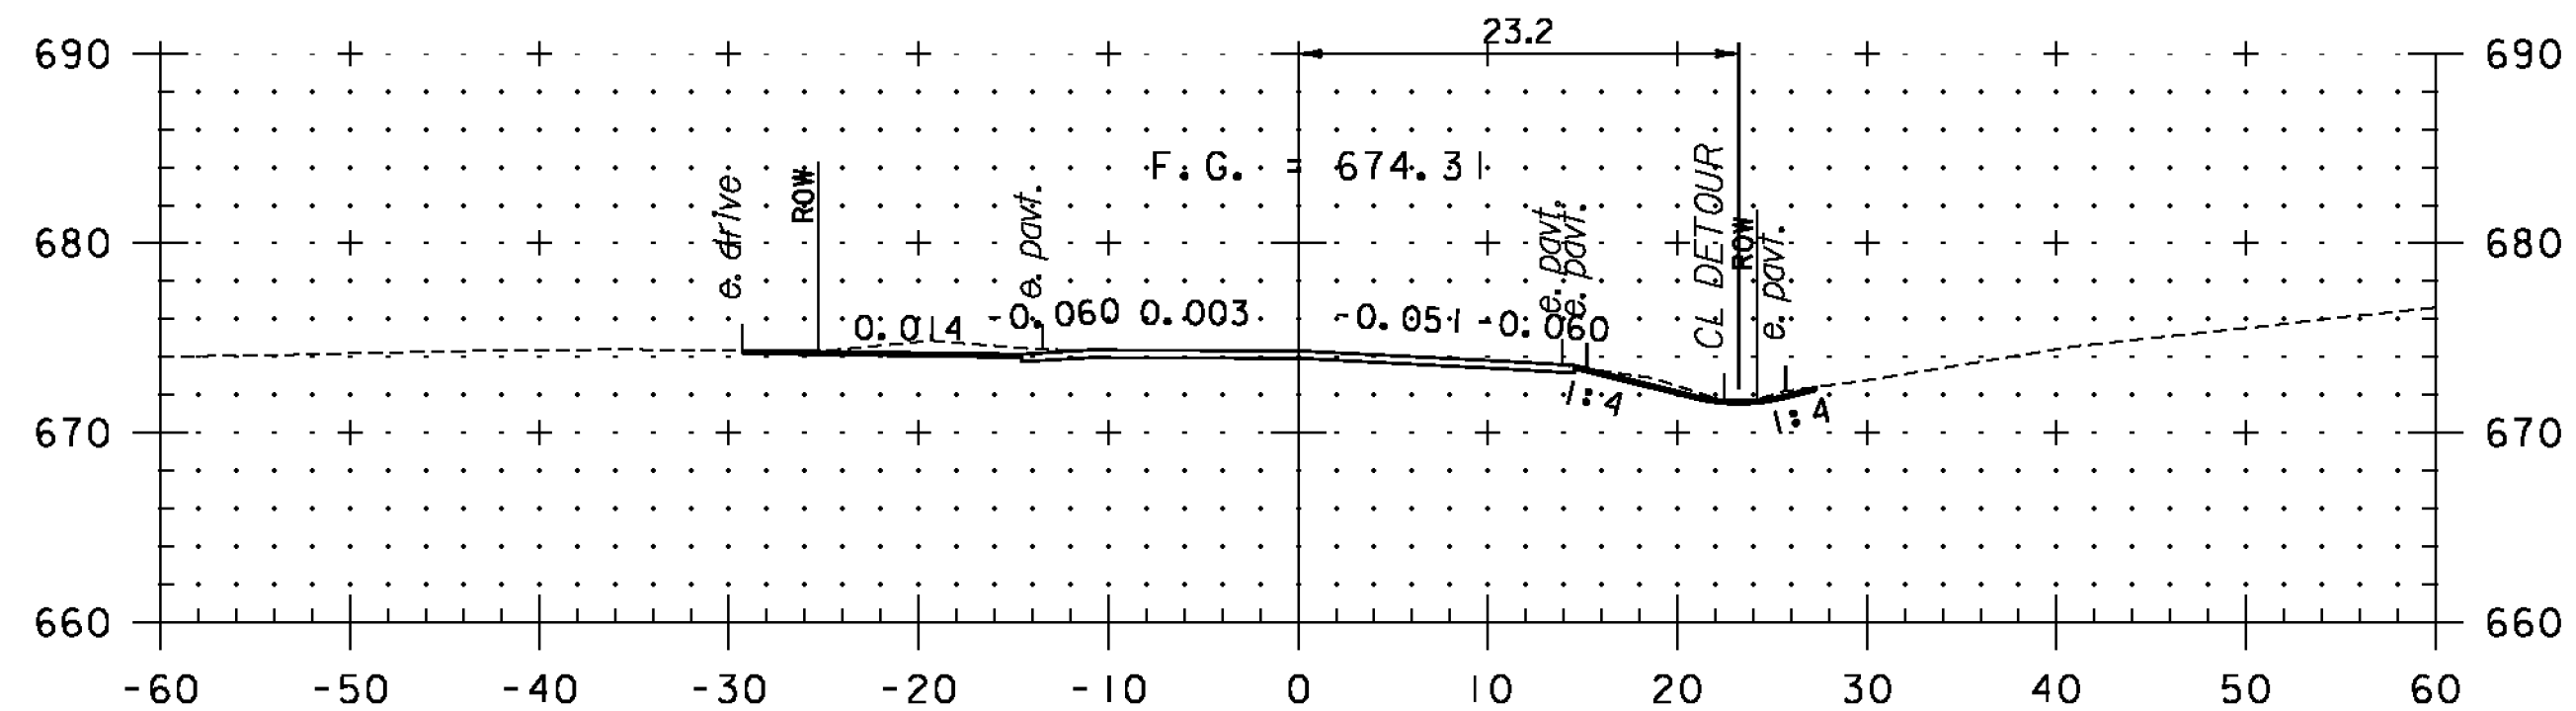


120+50


BEGIN COLD PLANE

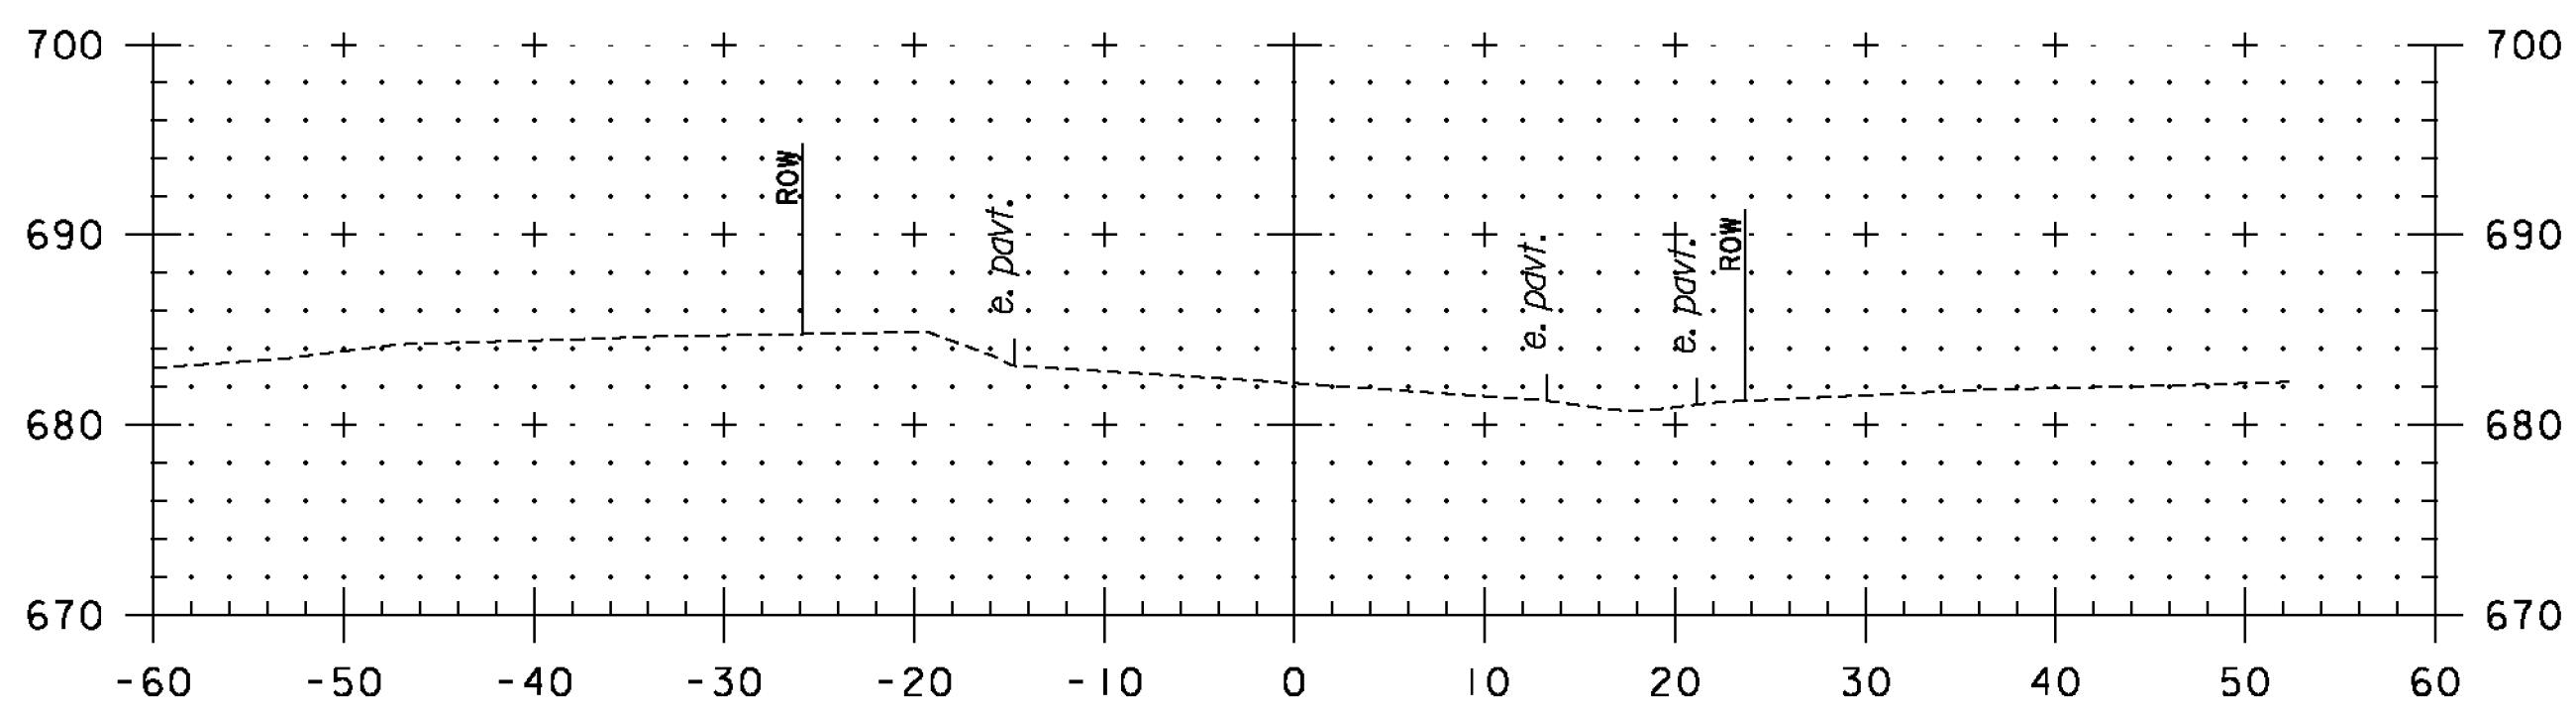

122+00

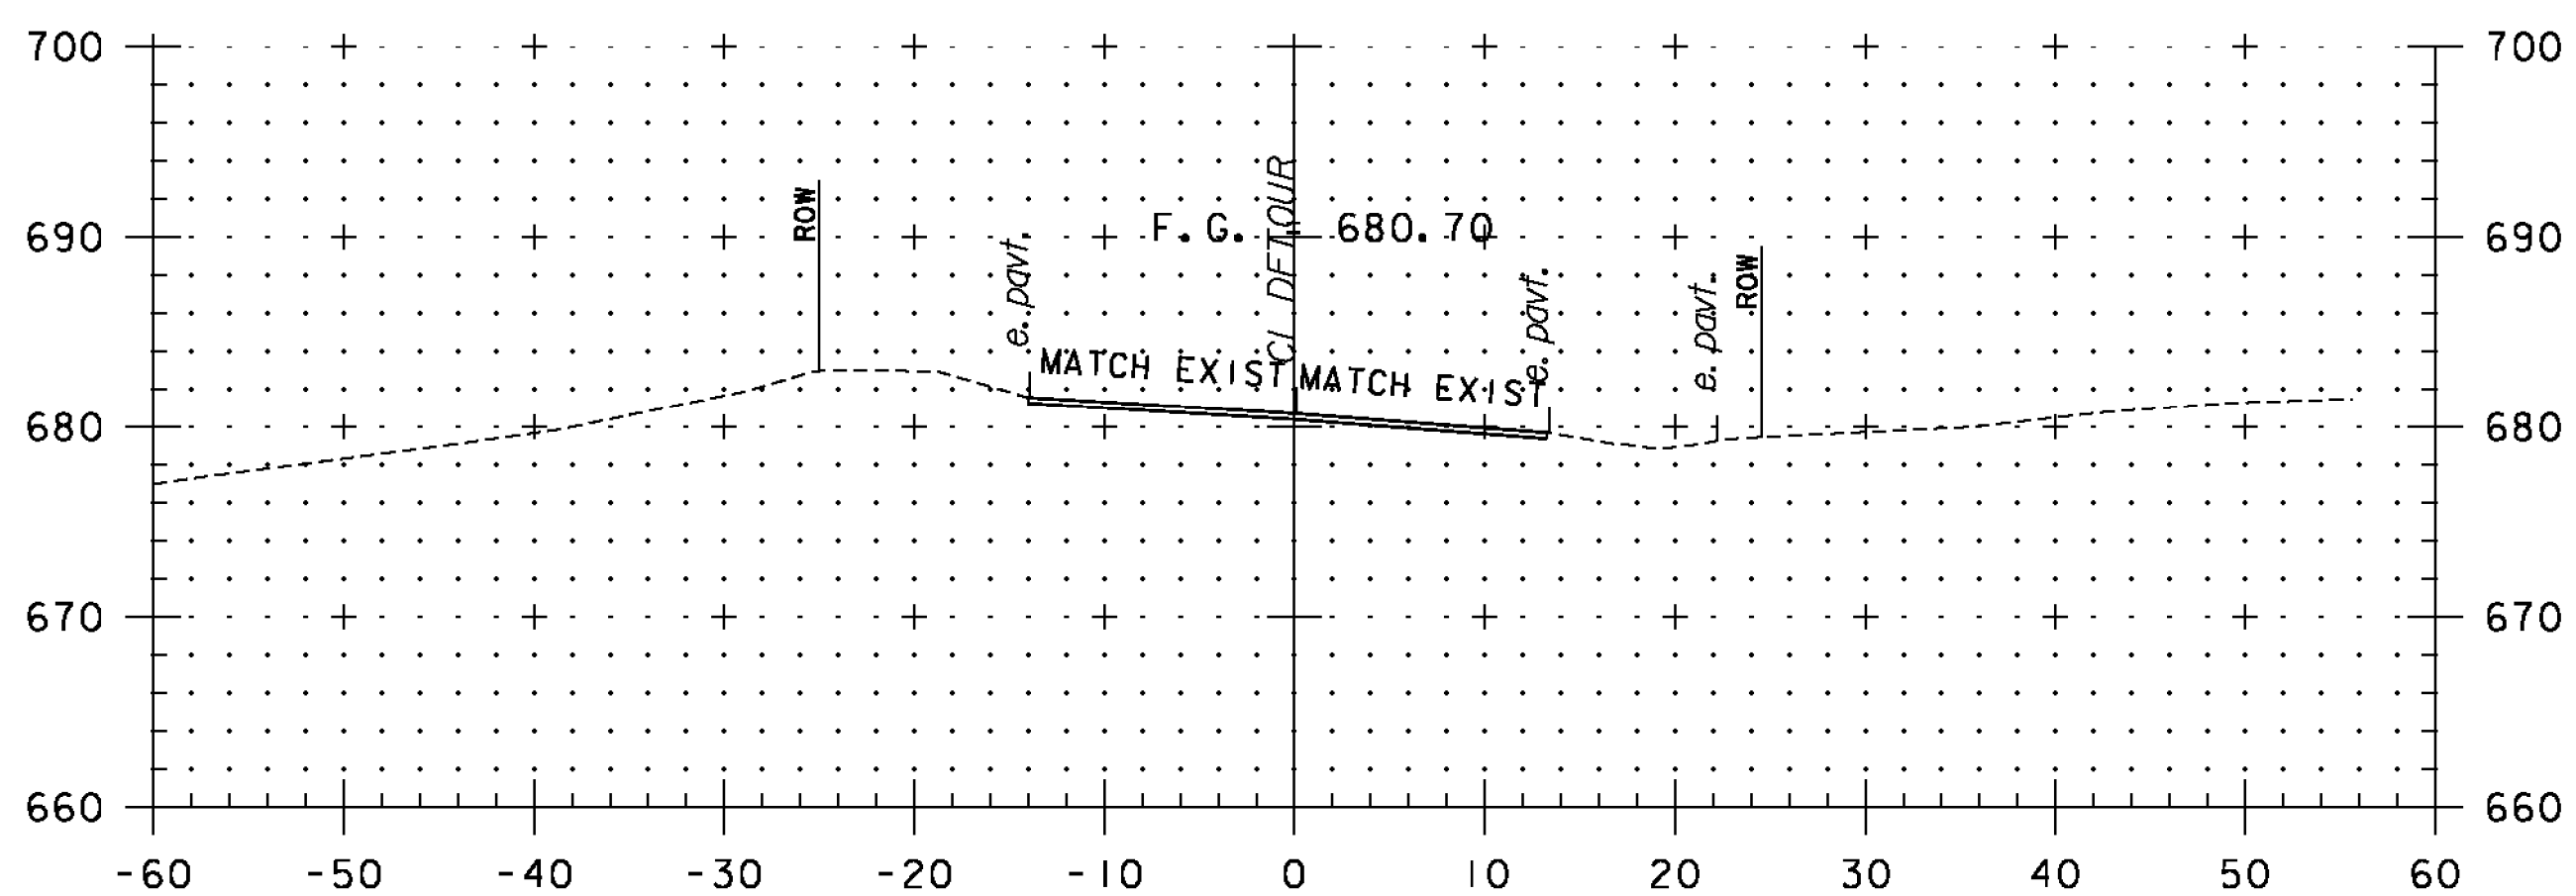

121+75.00
END APPROACH
END COLD PLANE

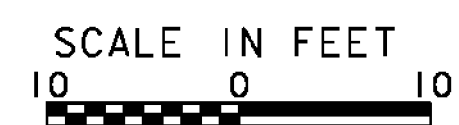

STA. 120+50 TO STA. 122+00

PROJECT NAME: BARRE TOWN
PROJECT NUMBER: STP SCR(10)

FILE NAME: z10d202xsl_VT14.dgn
PROJECT LEADER: K. UPMAL
DESIGNED BY: P. SHEDD
VT 14 CROSS SECTION SHEET 4

PLOT DATE: 2/13/2014
DRAWN BY: P. SHEDD
CHECKED BY: D. MUNRO
SHEET 32 OF 43