



319+53.65  
EXIST 18" CPEP PIPE INVERT OUT

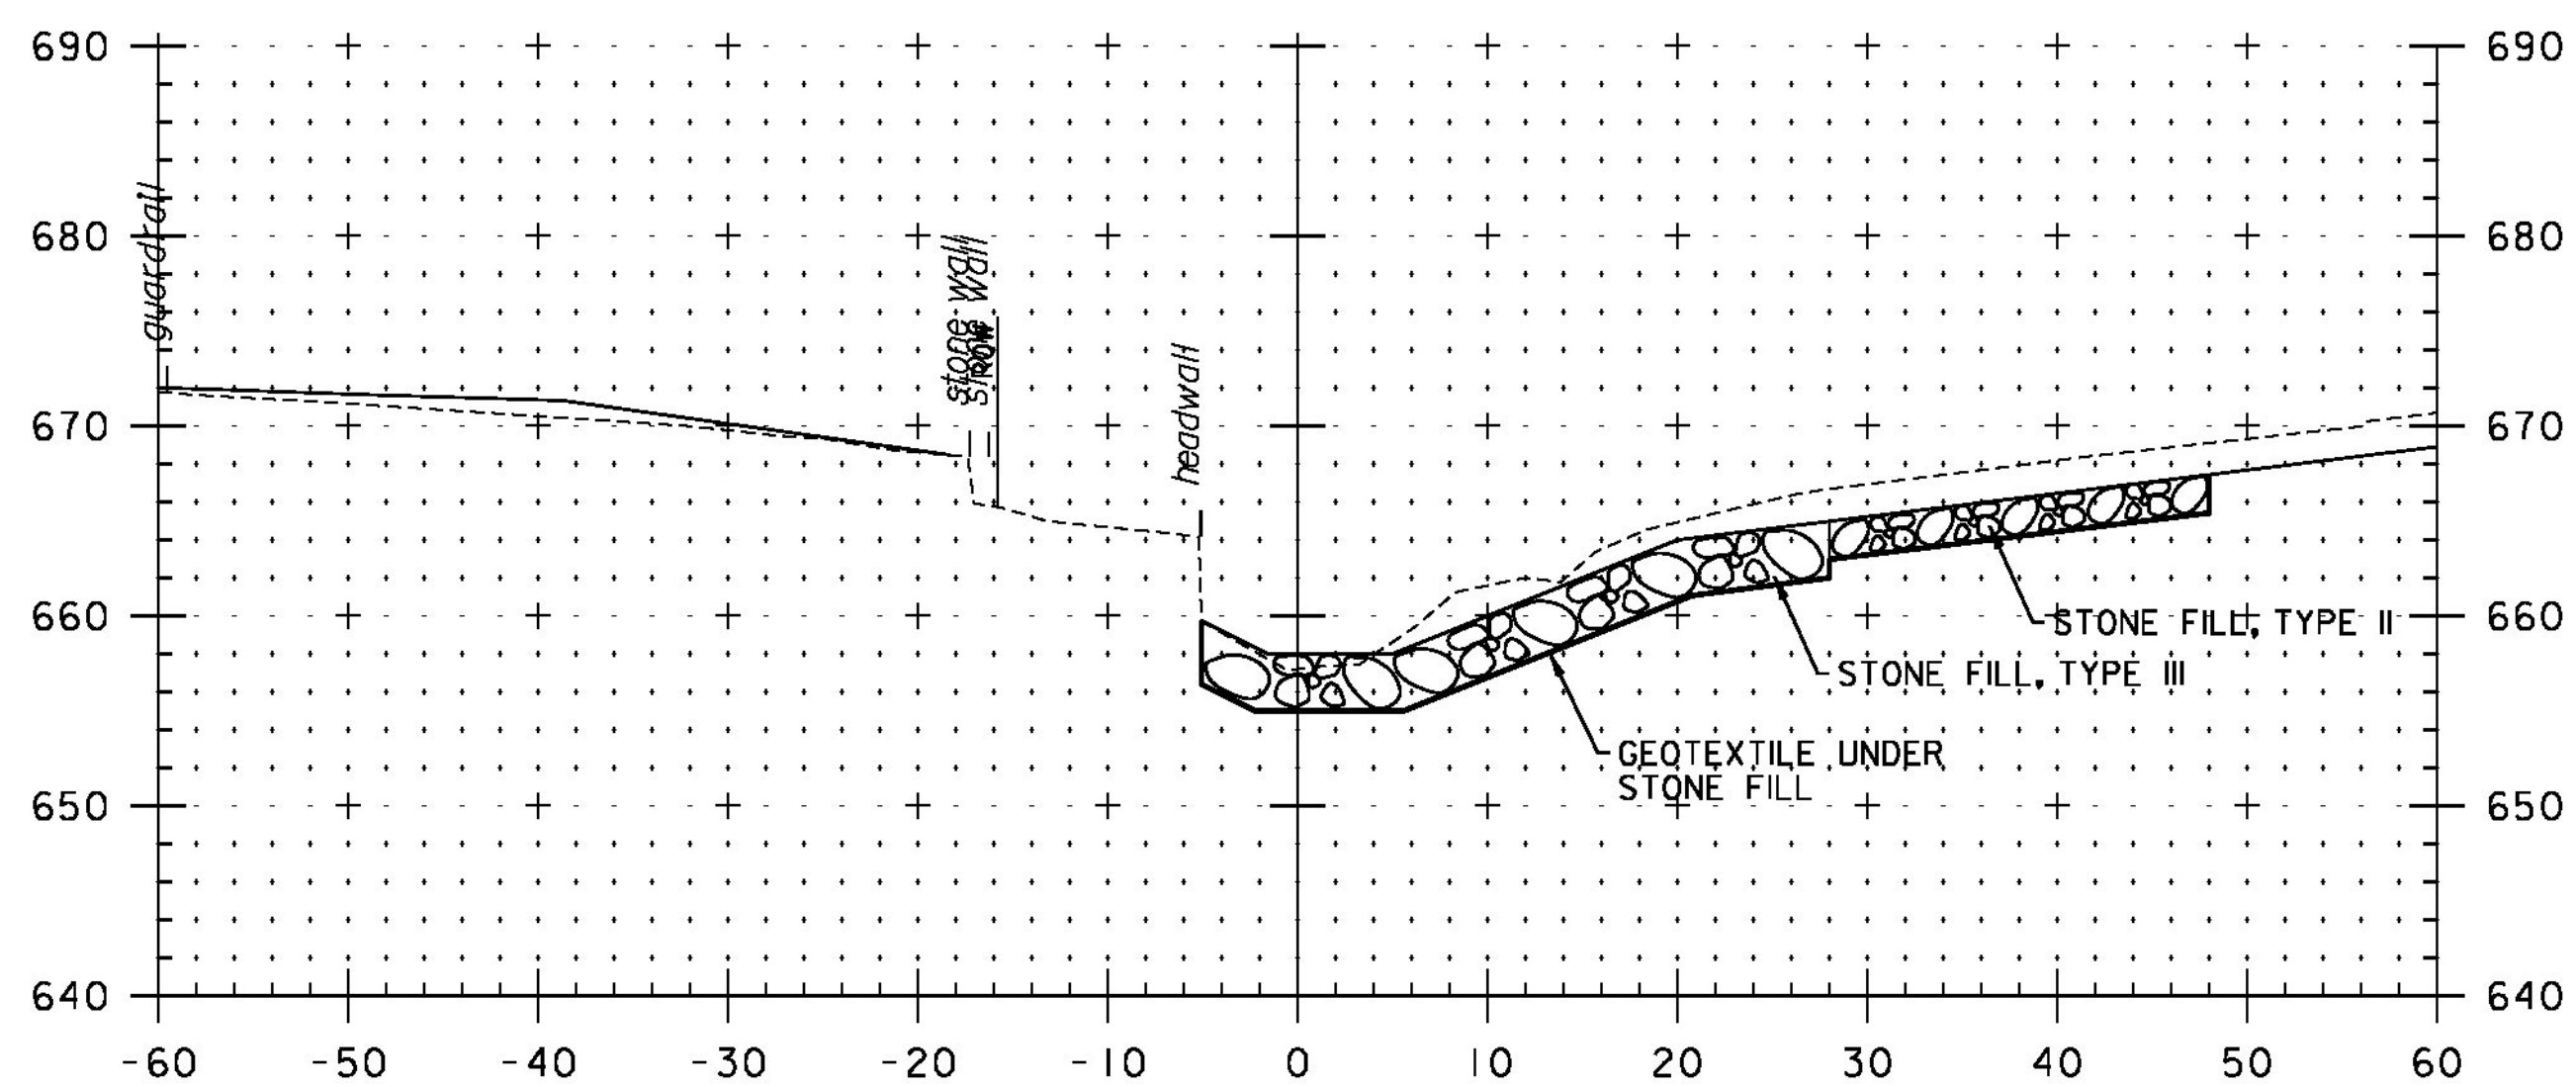

319+50

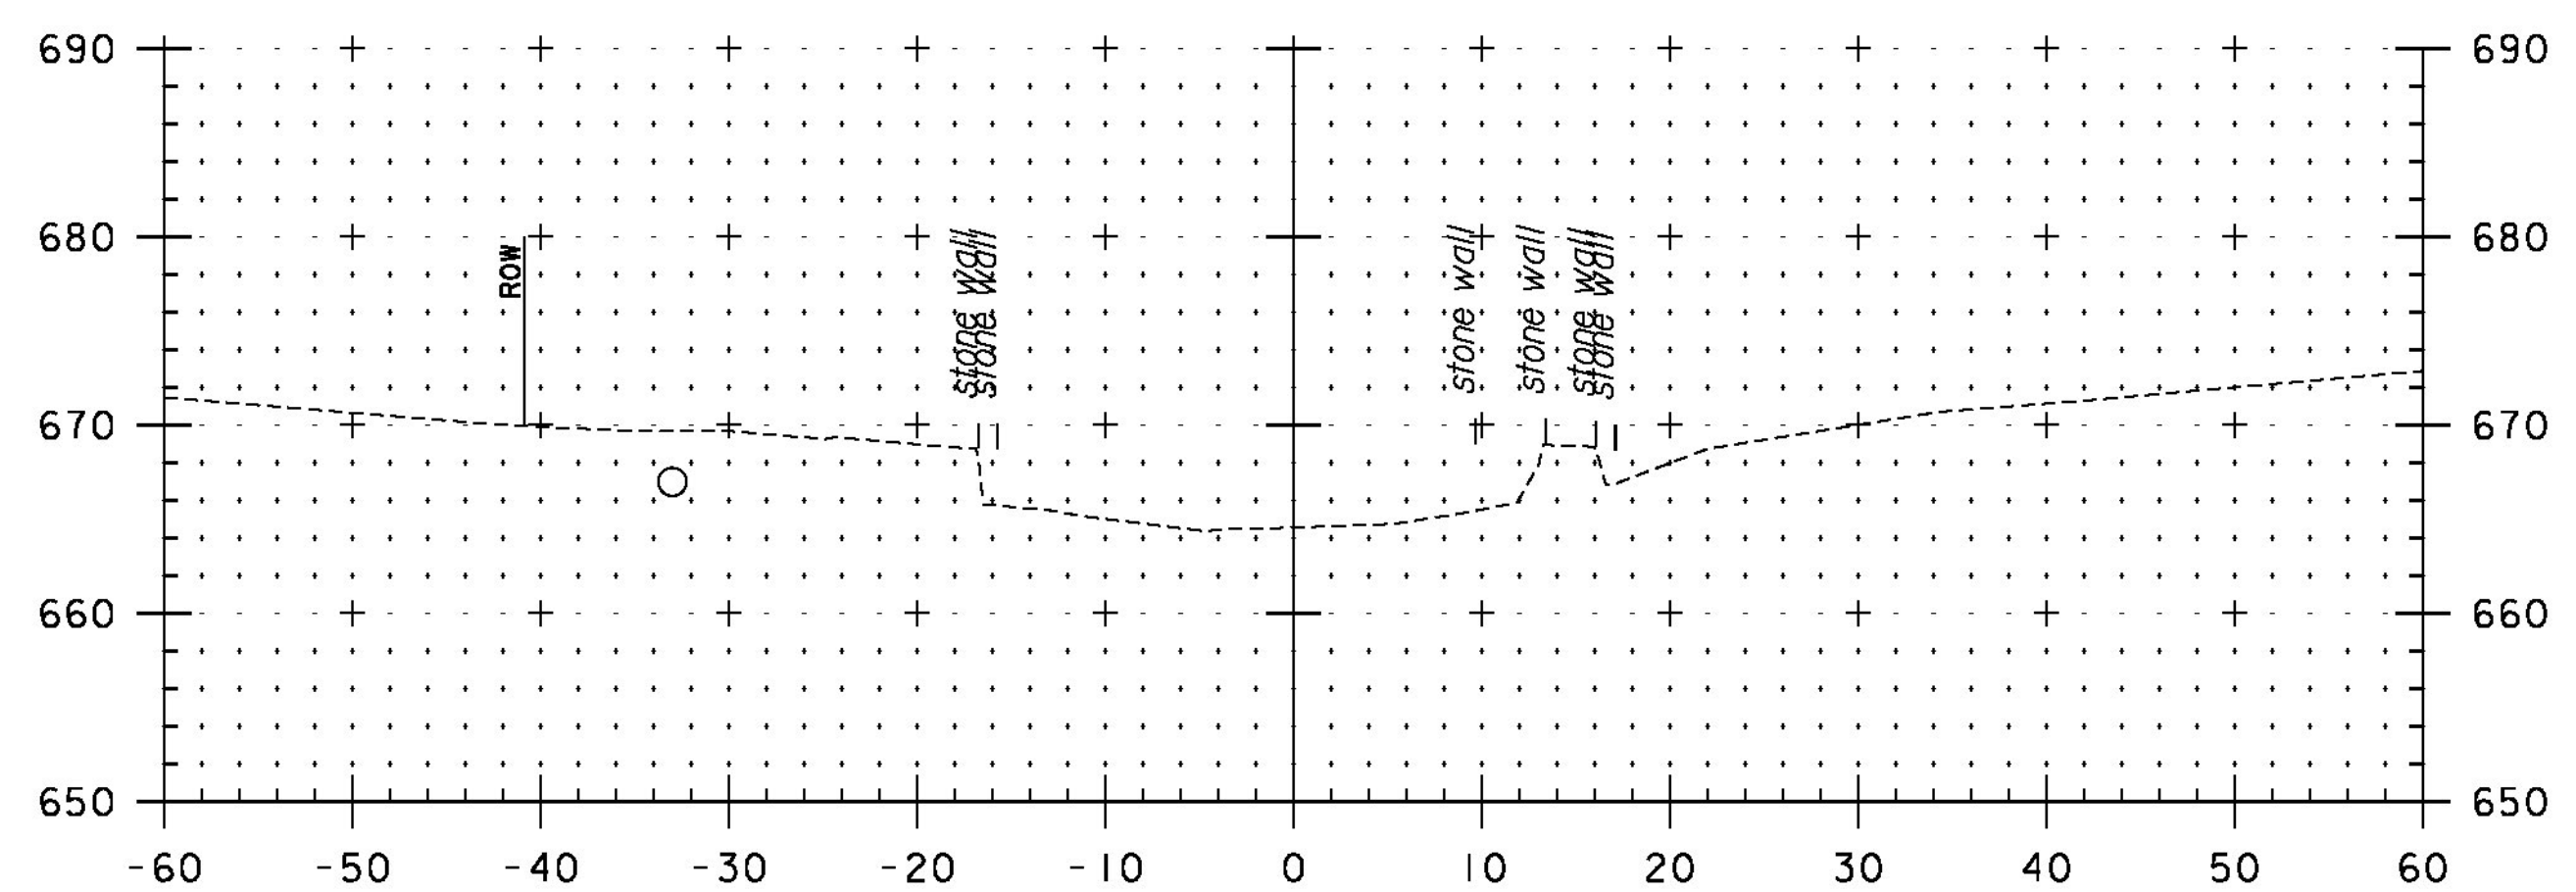

319+60

STA. 319+55.77 RT  
END COMMON EXCAVATION  
END STONE FILL, TYPE II

STA. 319+59.20 LT  
END UNCLASSIFIED CHANNEL EXCAVATION  
END GEOTEXTILE UNDER STONE FILL  
END STONE FILL, TYPE III

SCALE IN FEET  
10 0 10

STA. 319+50 TO STA. 319+60

PROJECT NAME:	BARRE TOWN	FILE NAME:	z10d202xsl_Channel.dgn	PLOT DATE:	2/13/2014
PROJECT NUMBER:	STP SCR(10)	PROJECT LEADER:	K. UPMAL	DRAWN BY:	M. SMITH
		DESIGNED BY:	S. BEAUMONT	CHECKED BY:	J. BYATT
		CHANNEL CROSS SECTION SHEET 4		SHEET	36 OF 43