




216+50

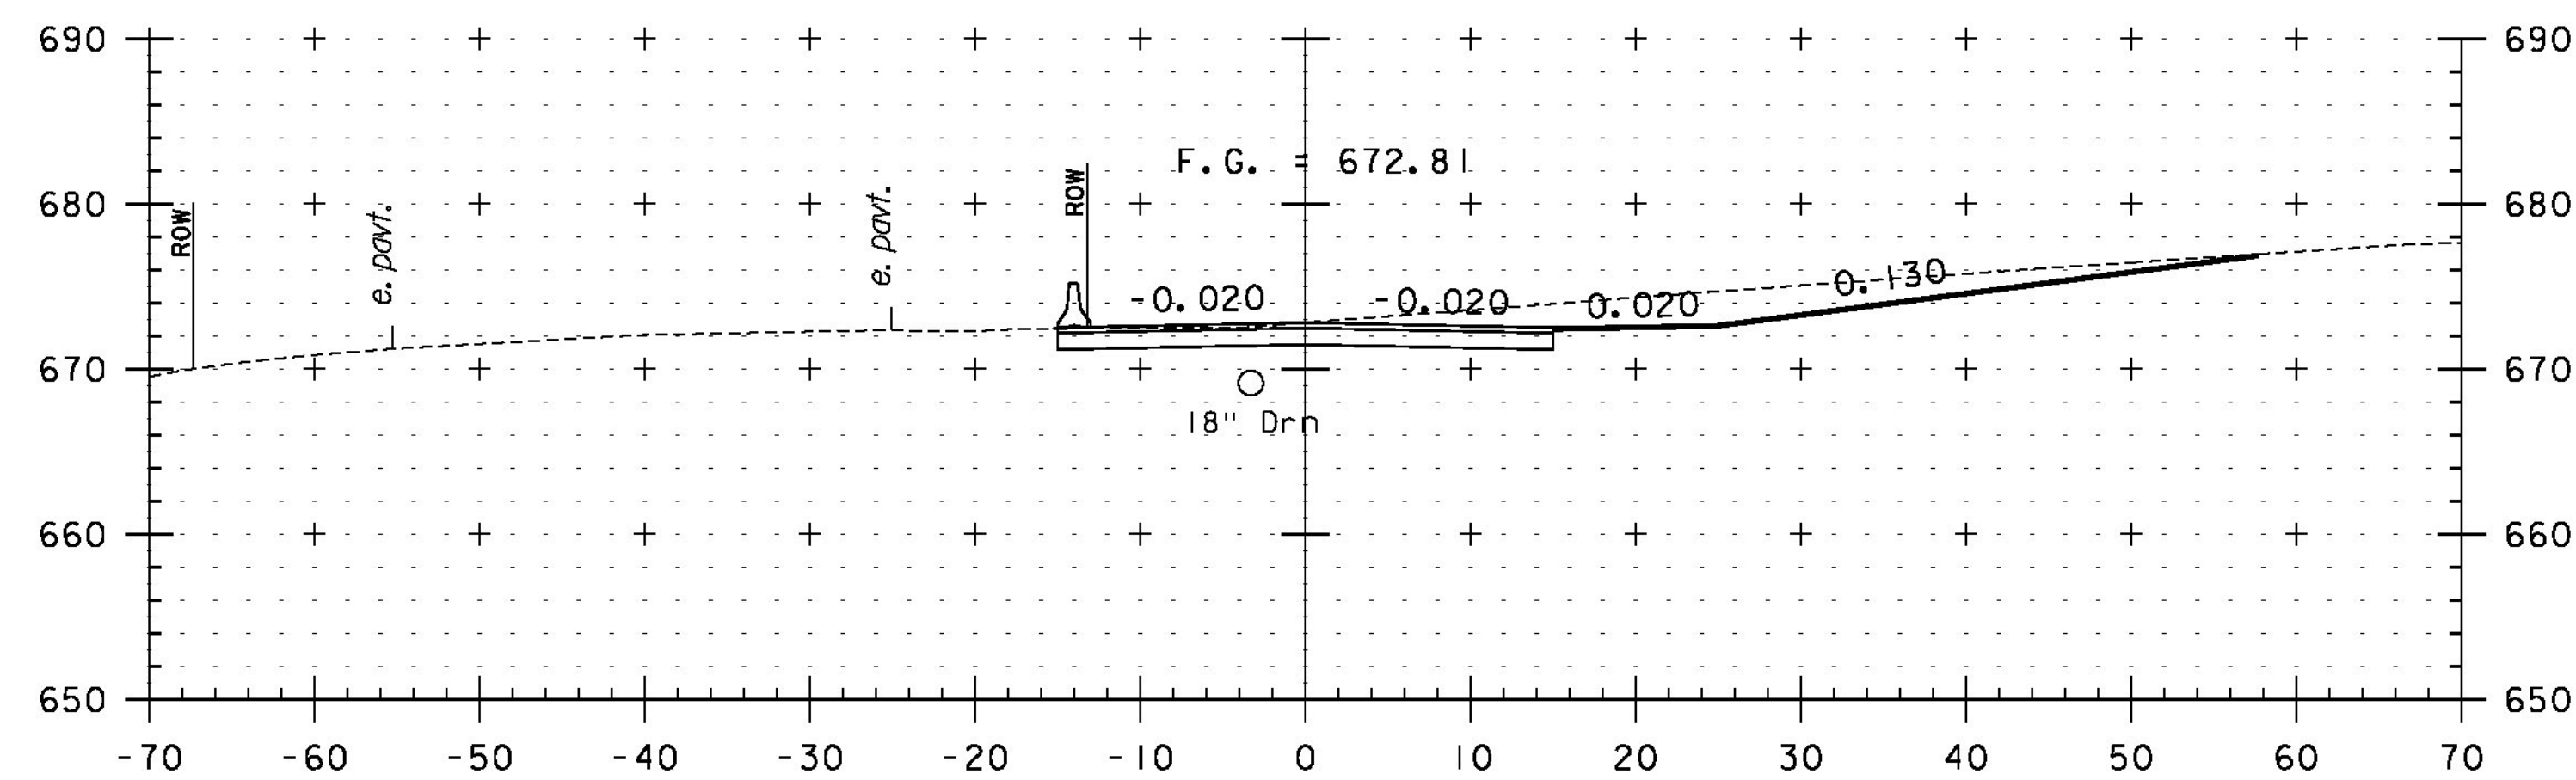


217+74.0
DRIVE RT

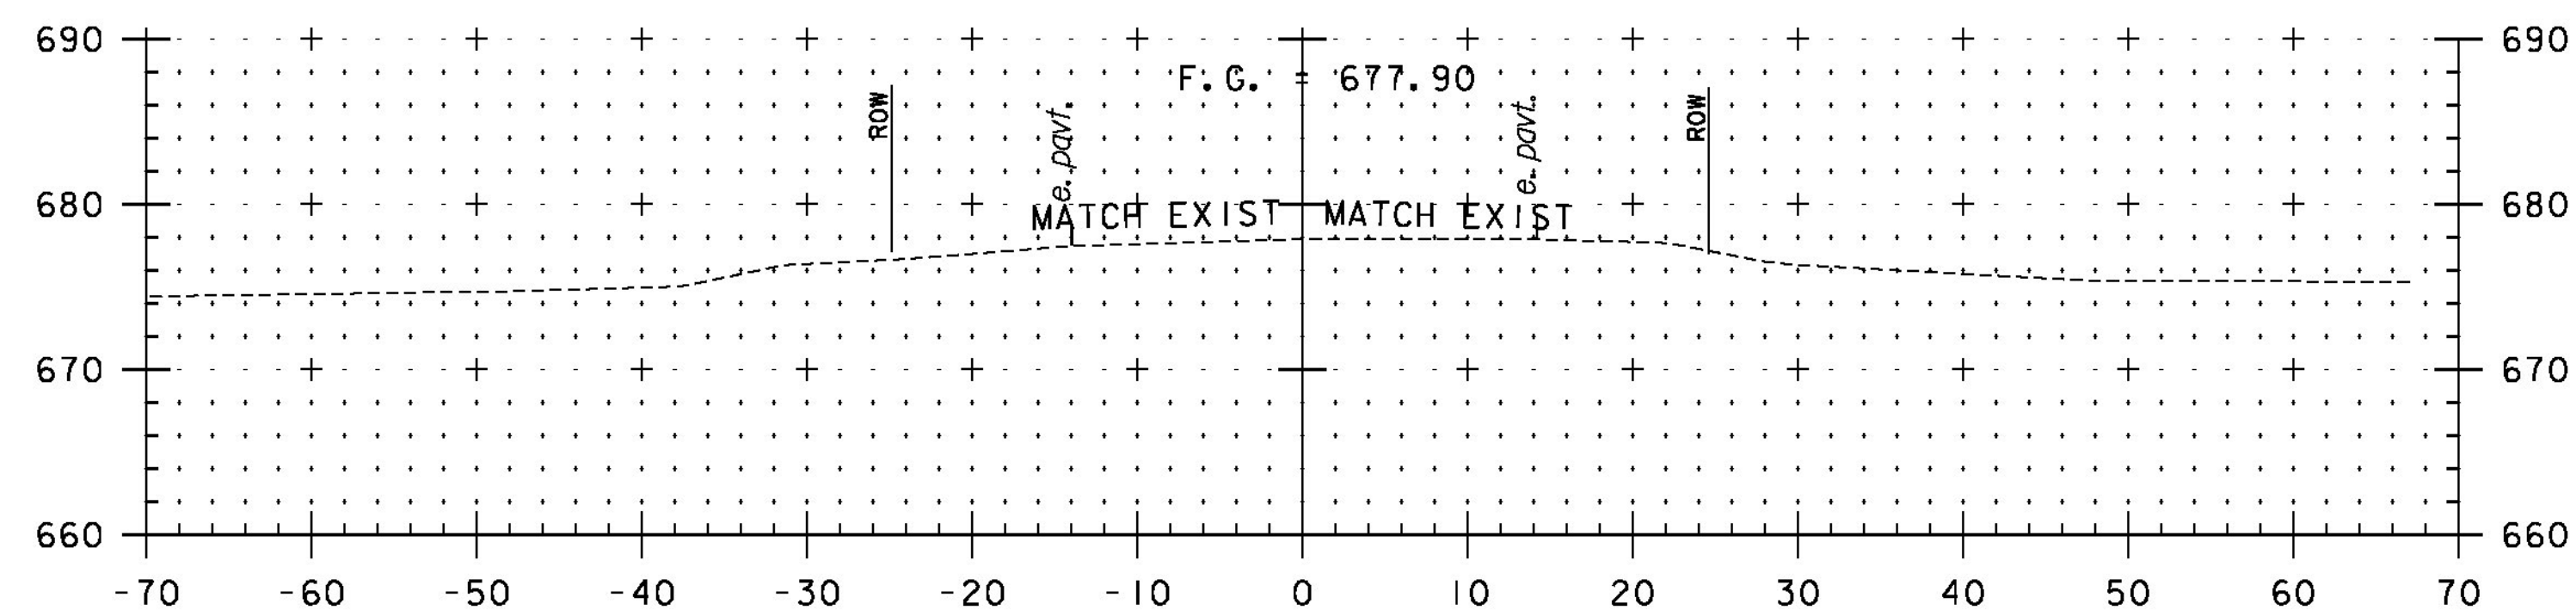


216+25.00
BEGIN DETOUR

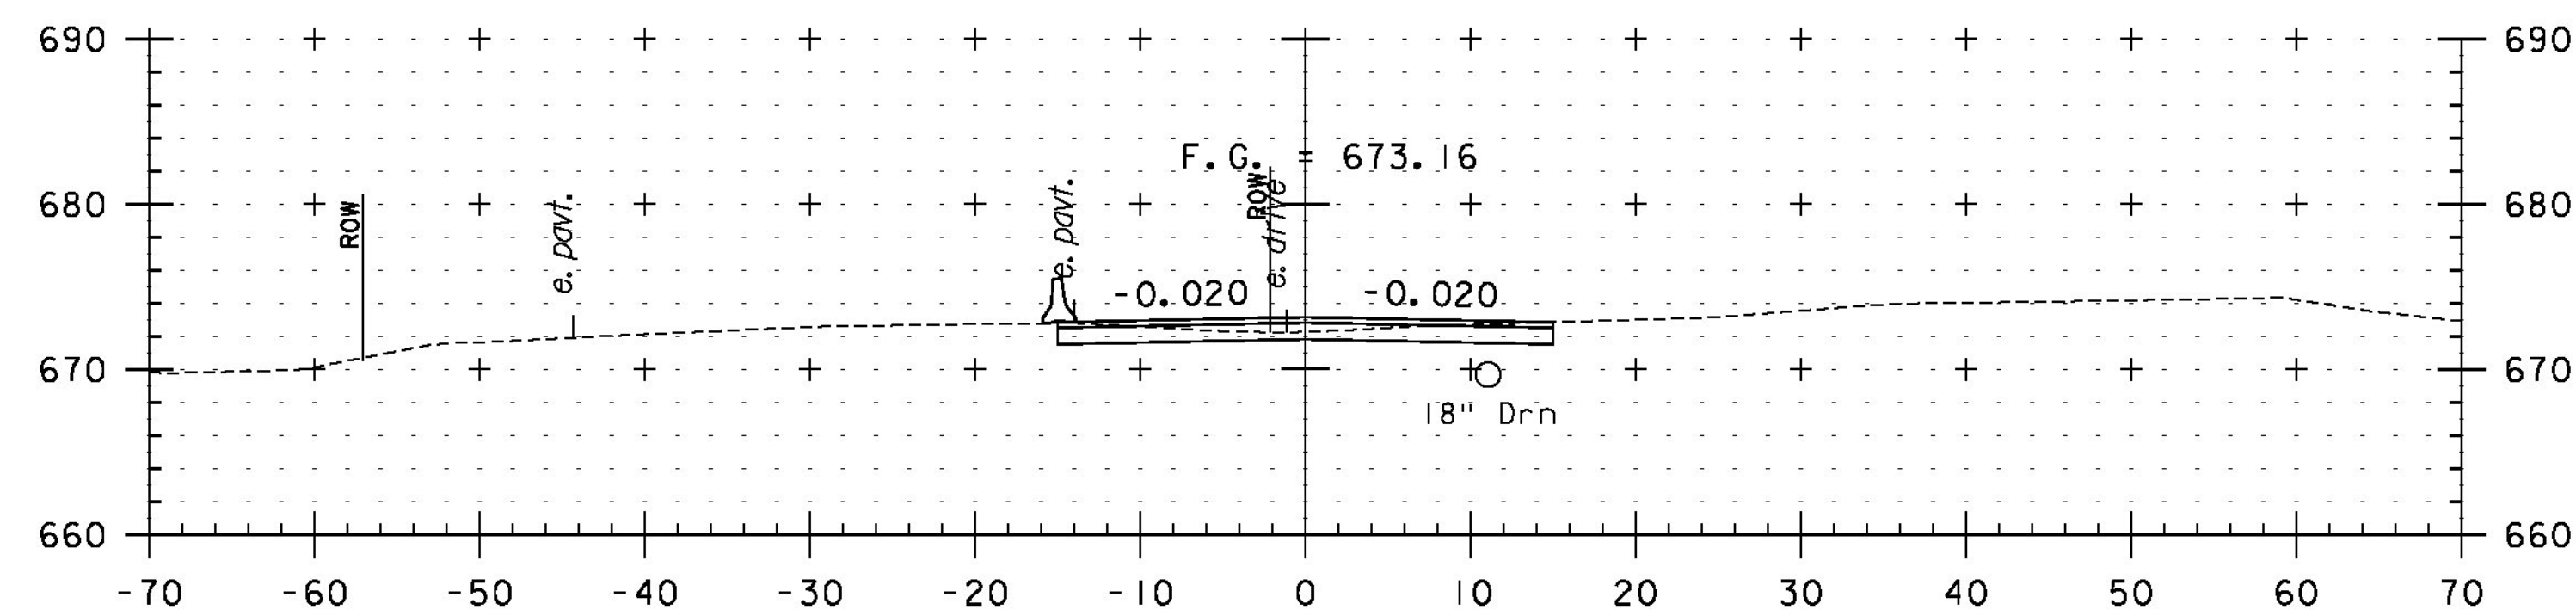

217+50

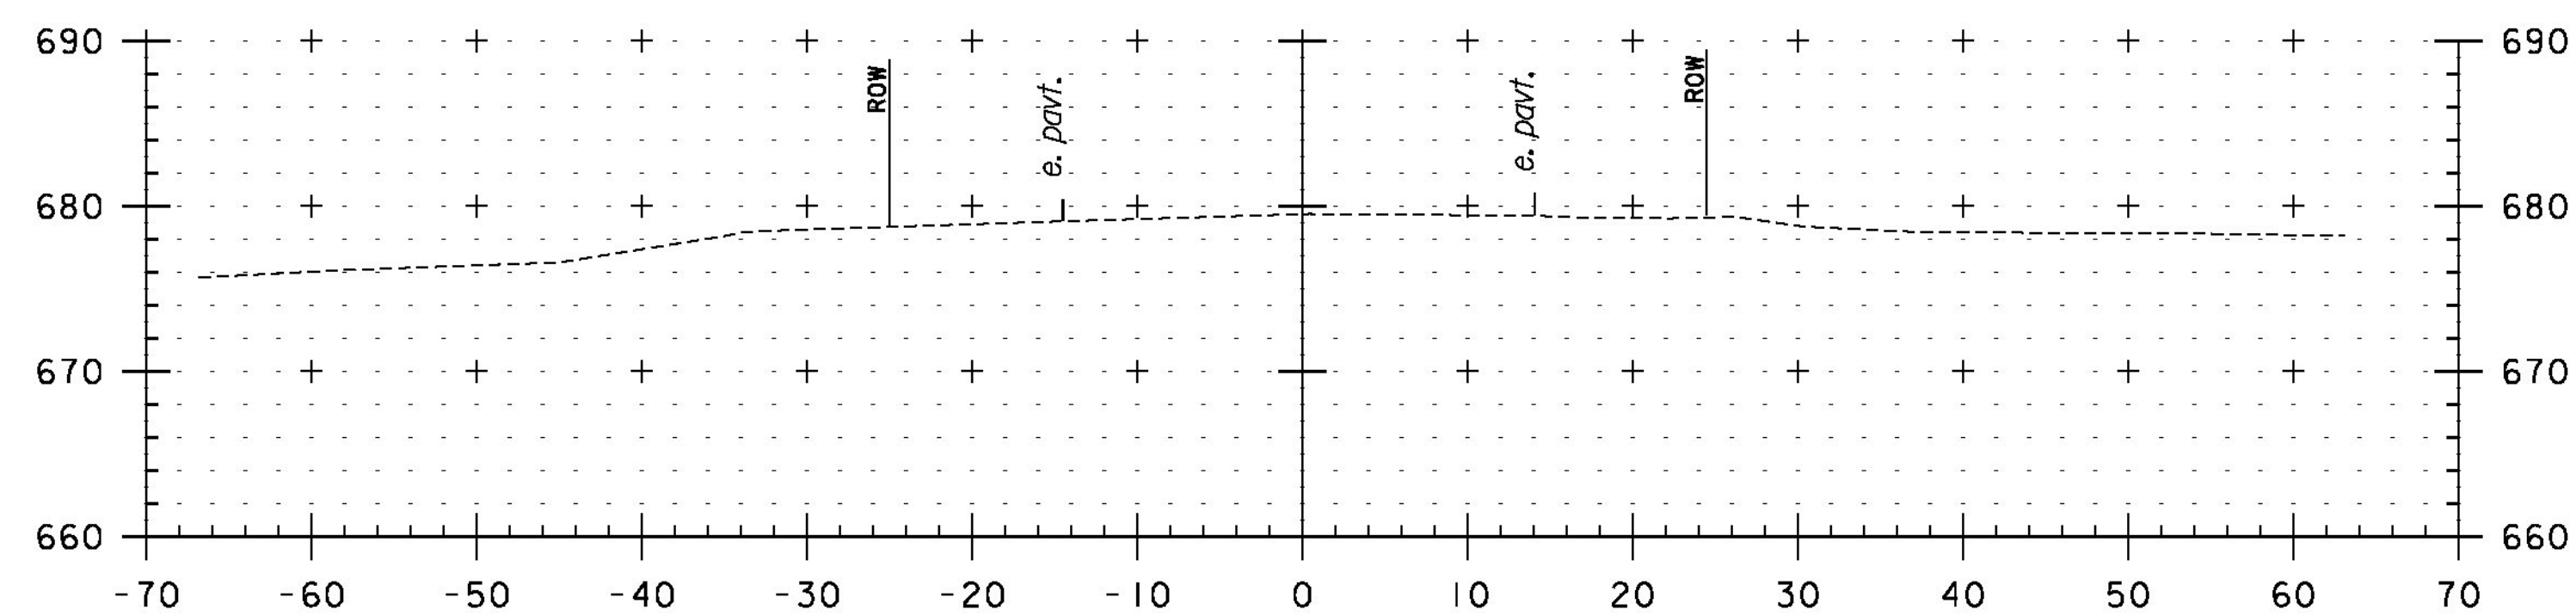


216+00

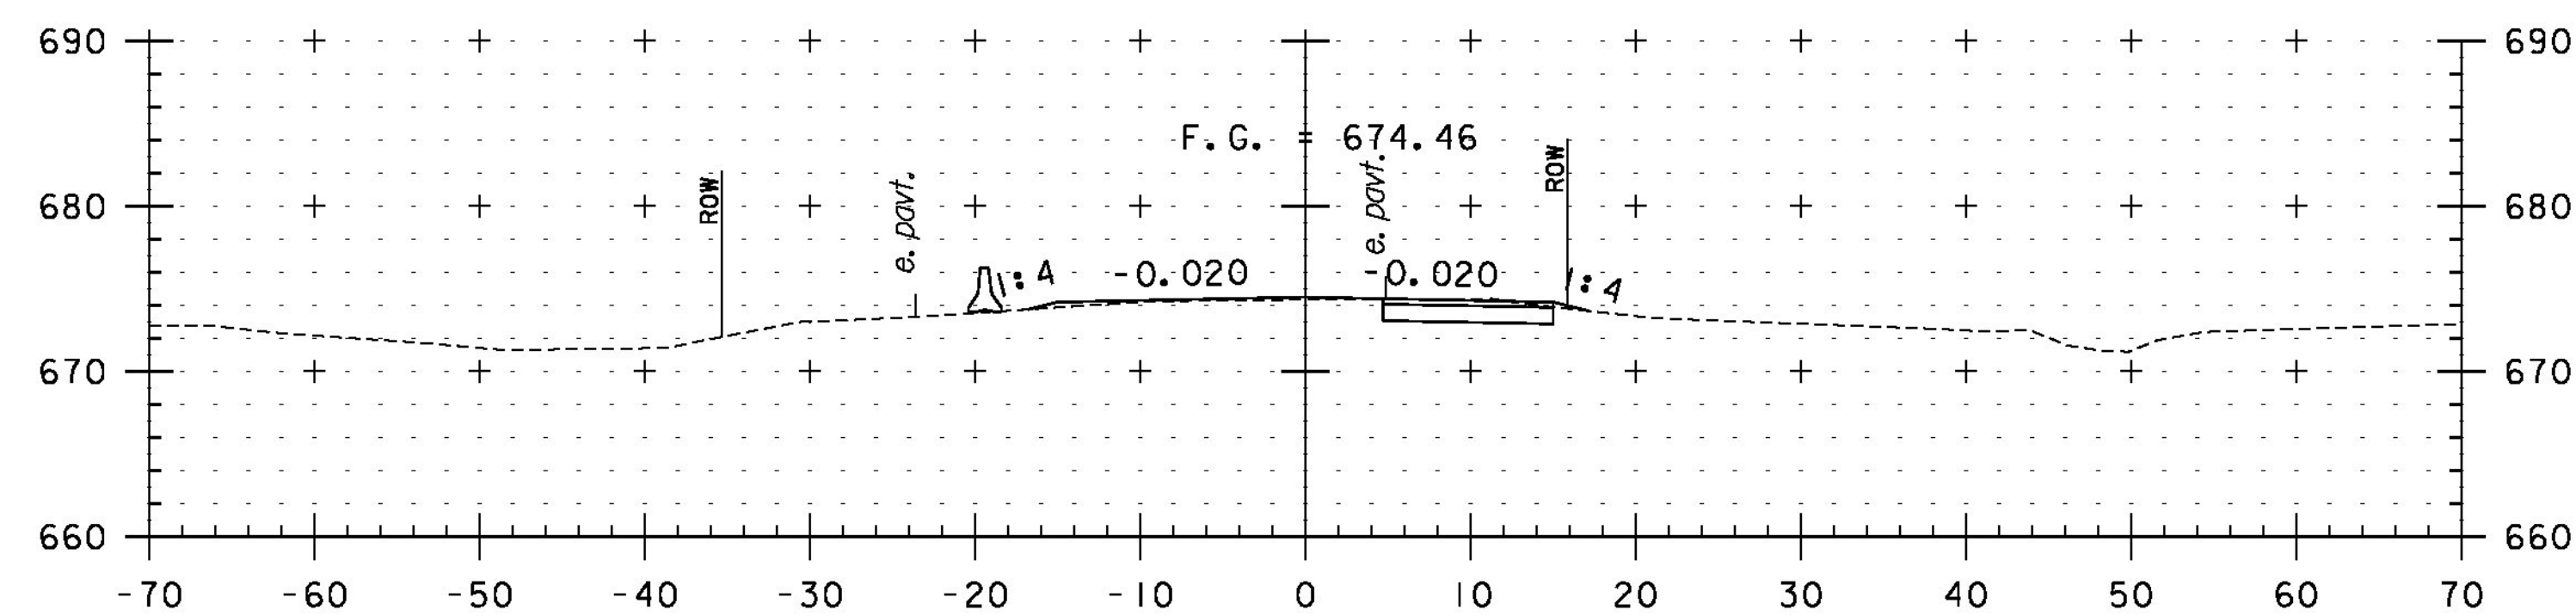

217+00

CLD 11-0160

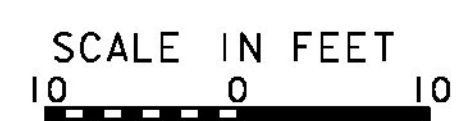

STA. 216+00 TO STA. 217+74.0

PROJECT NAME: BARRE TOWN	
PROJECT NUMBER: STP SCR(10)	
FILE NAME: z10d202xsl_Detour.dgn	PLOT DATE: 2/13/2014
PROJECT LEADER: K. UPMAL	DRAWN BY: P. SHEDD
DESIGNED BY: P. SHEDD	CHECKED BY: D. MUNRO
TRAFFIC CONTROL CROSS SECTION SHEET 1	SHEET 40 OF 43