




219+00

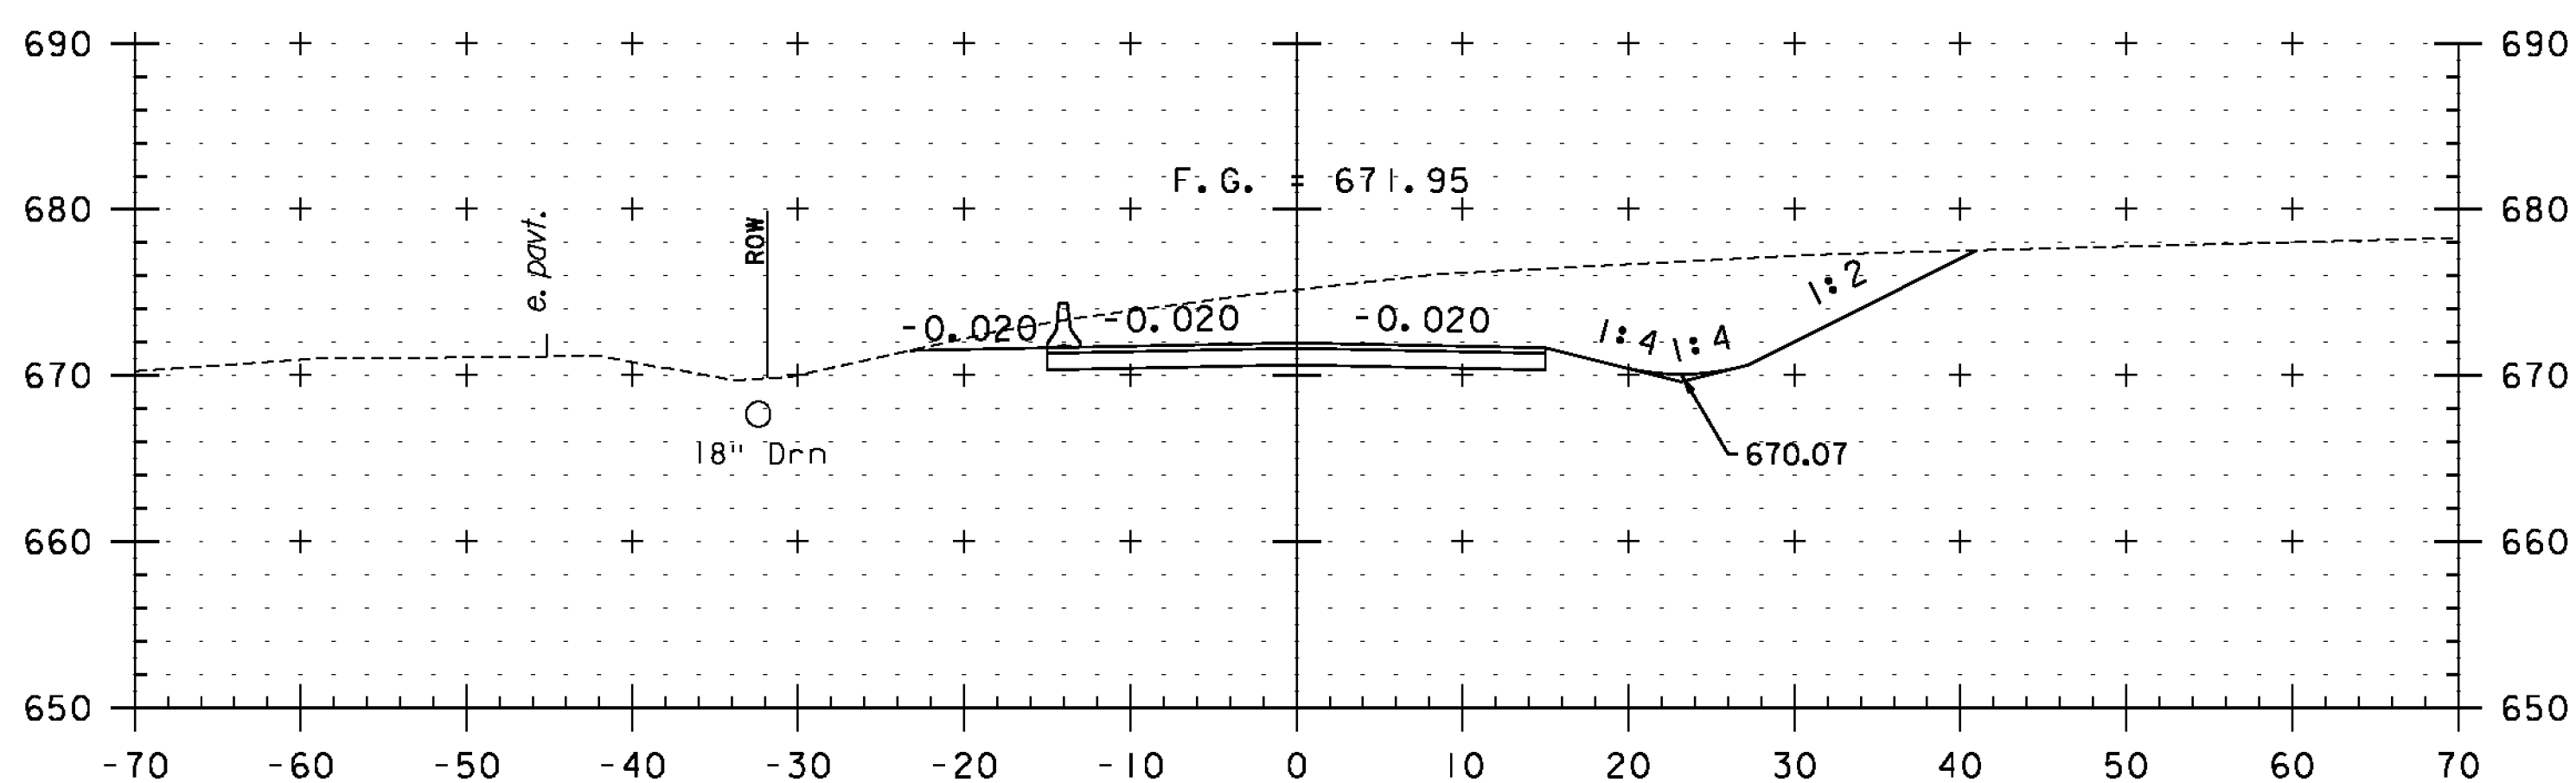


218+50

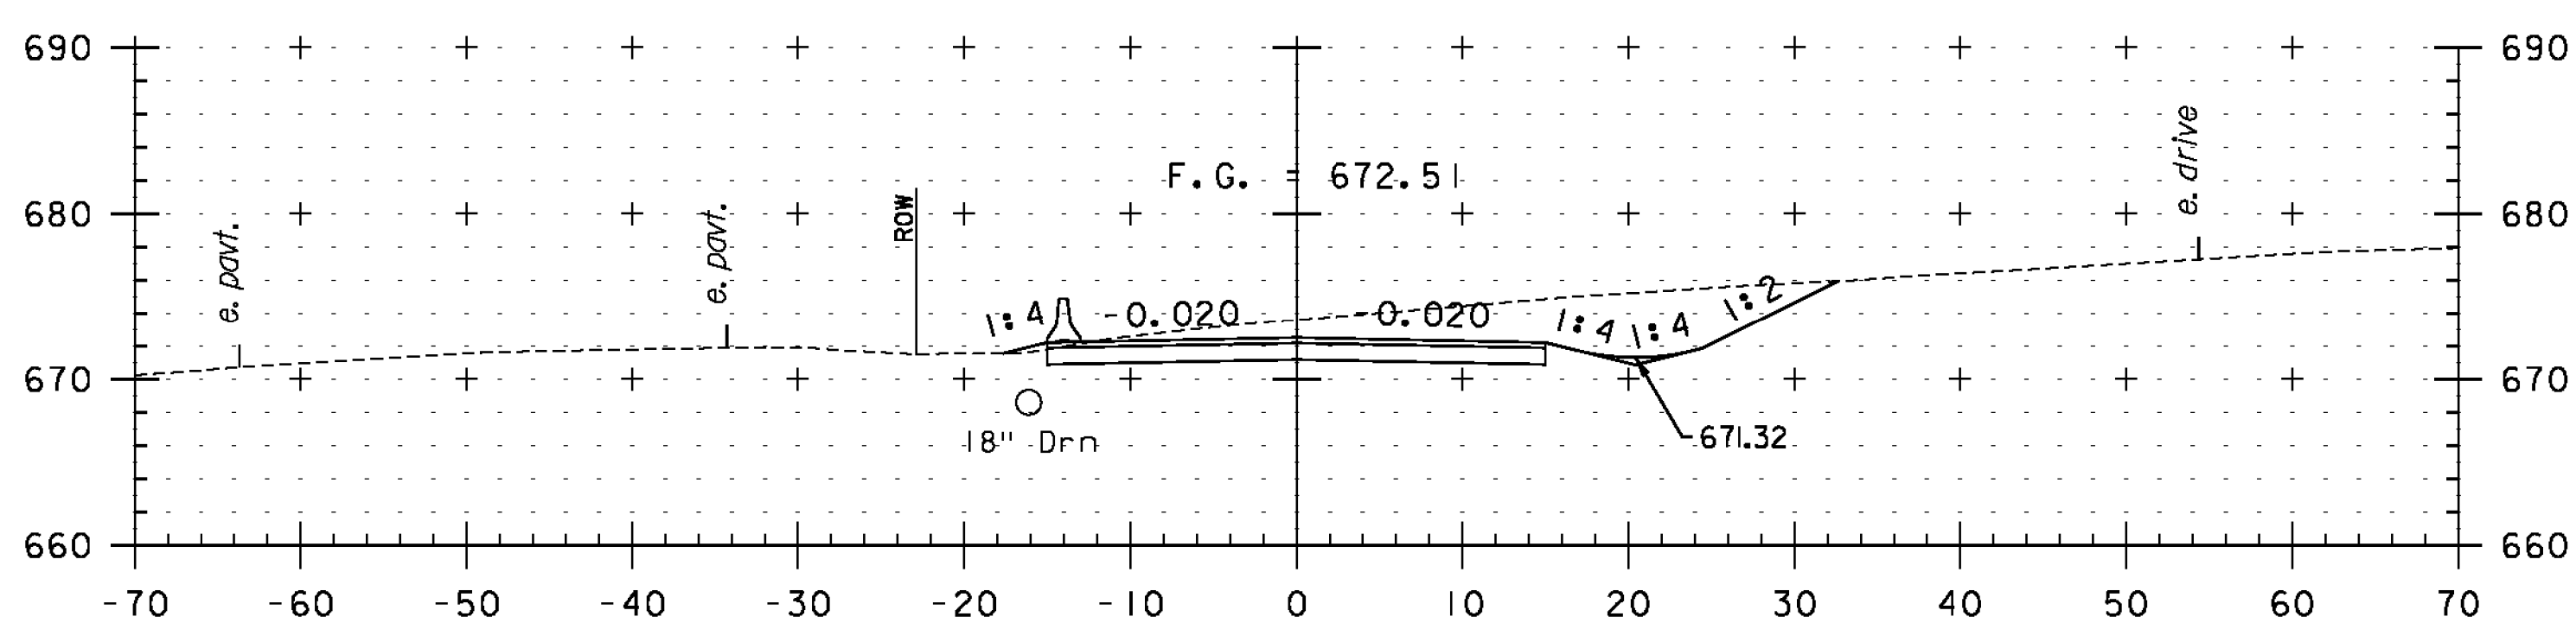


218+00

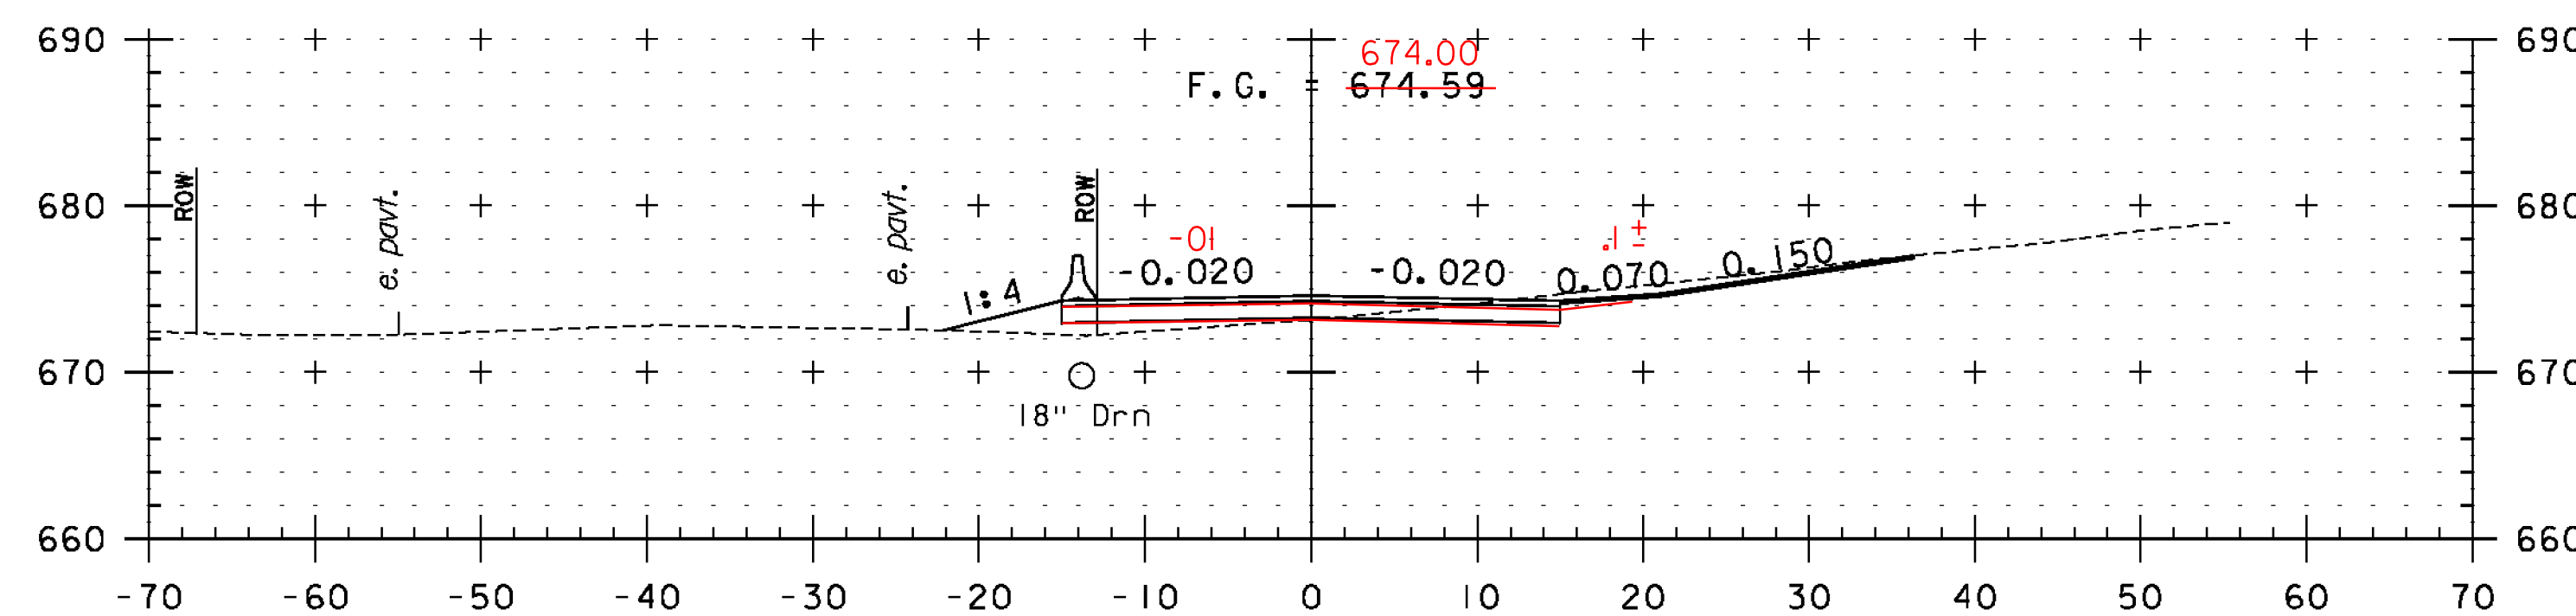

220+37.0  
DRIVE RT

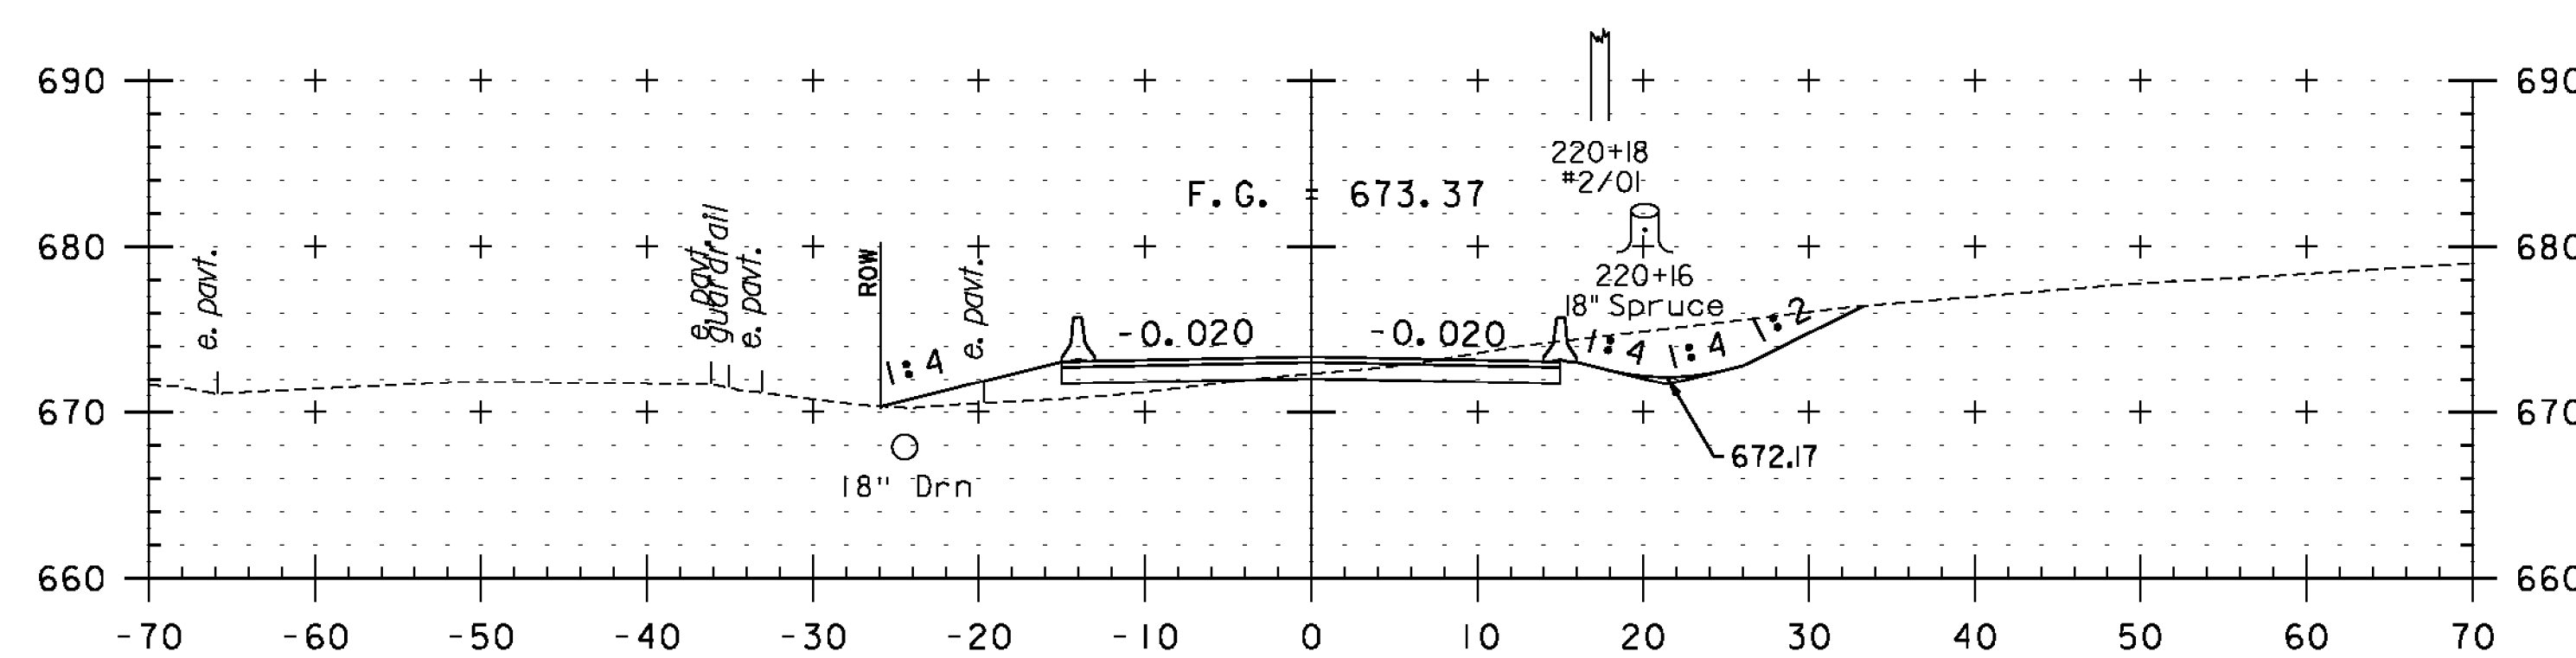

220+00

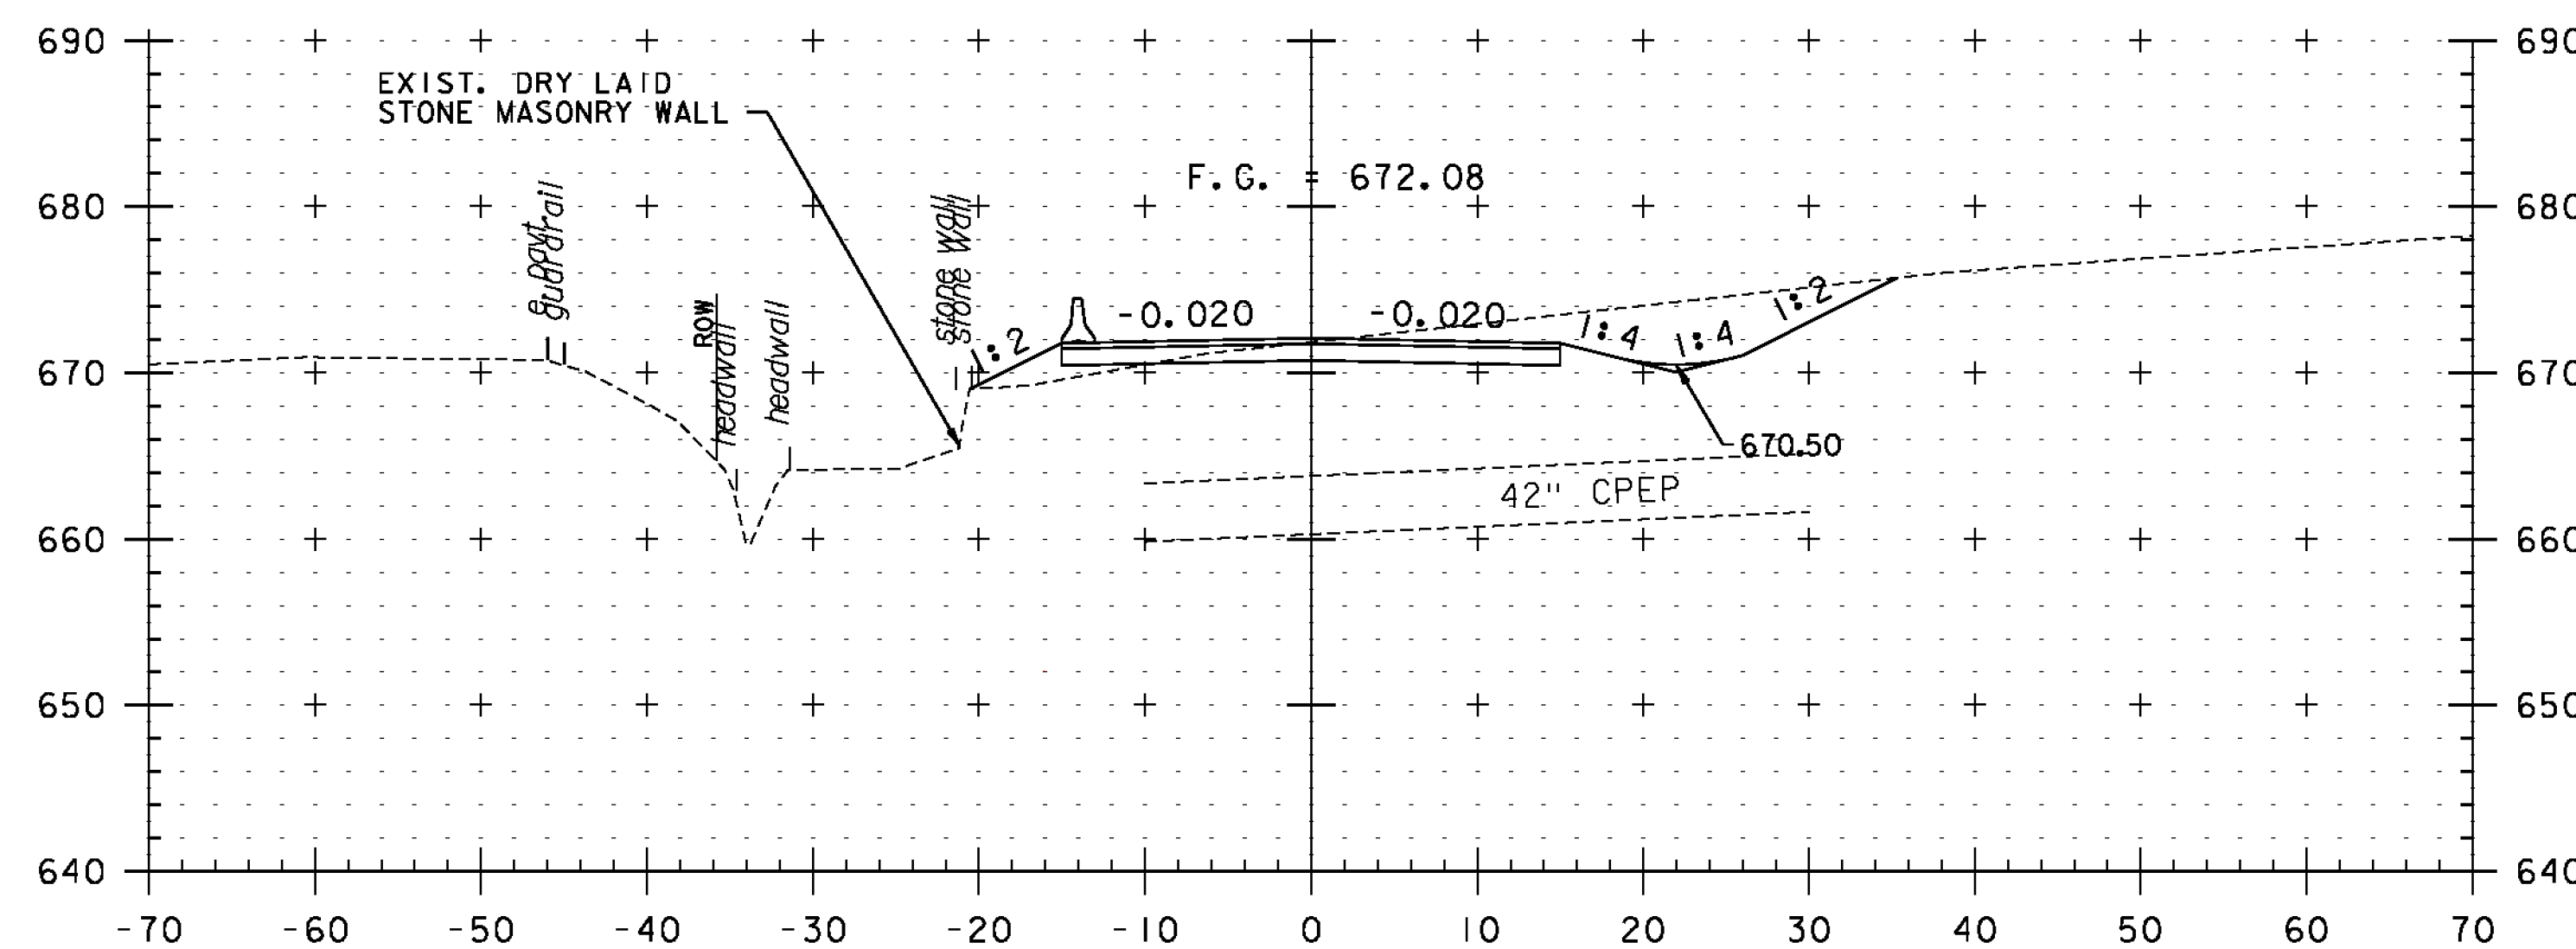

219+50

CLD 11-0160



STA. 218+00 TO STA. 220+37.0

|                                       |                      |
|---------------------------------------|----------------------|
| PROJECT NAME: BARRE TOWN              | PLOT DATE: 2/13/2014 |
| PROJECT NUMBER: STP SCRP(10)          | DRAWN BY: P. SHEDD   |
| FILE NAME: z10d202xsl_Detour.dgn      | CHECKED BY: D. MUNRO |
| PROJECT LEADER: K. UPMAL              | SHEET 41 OF 43       |
| DESIGNED BY: P. SHEDD                 |                      |
| TRAFFIC CONTROL CROSS SECTION SHEET 2 |                      |