



221+75  
MATCH EXISTING


+0.06      -0.08

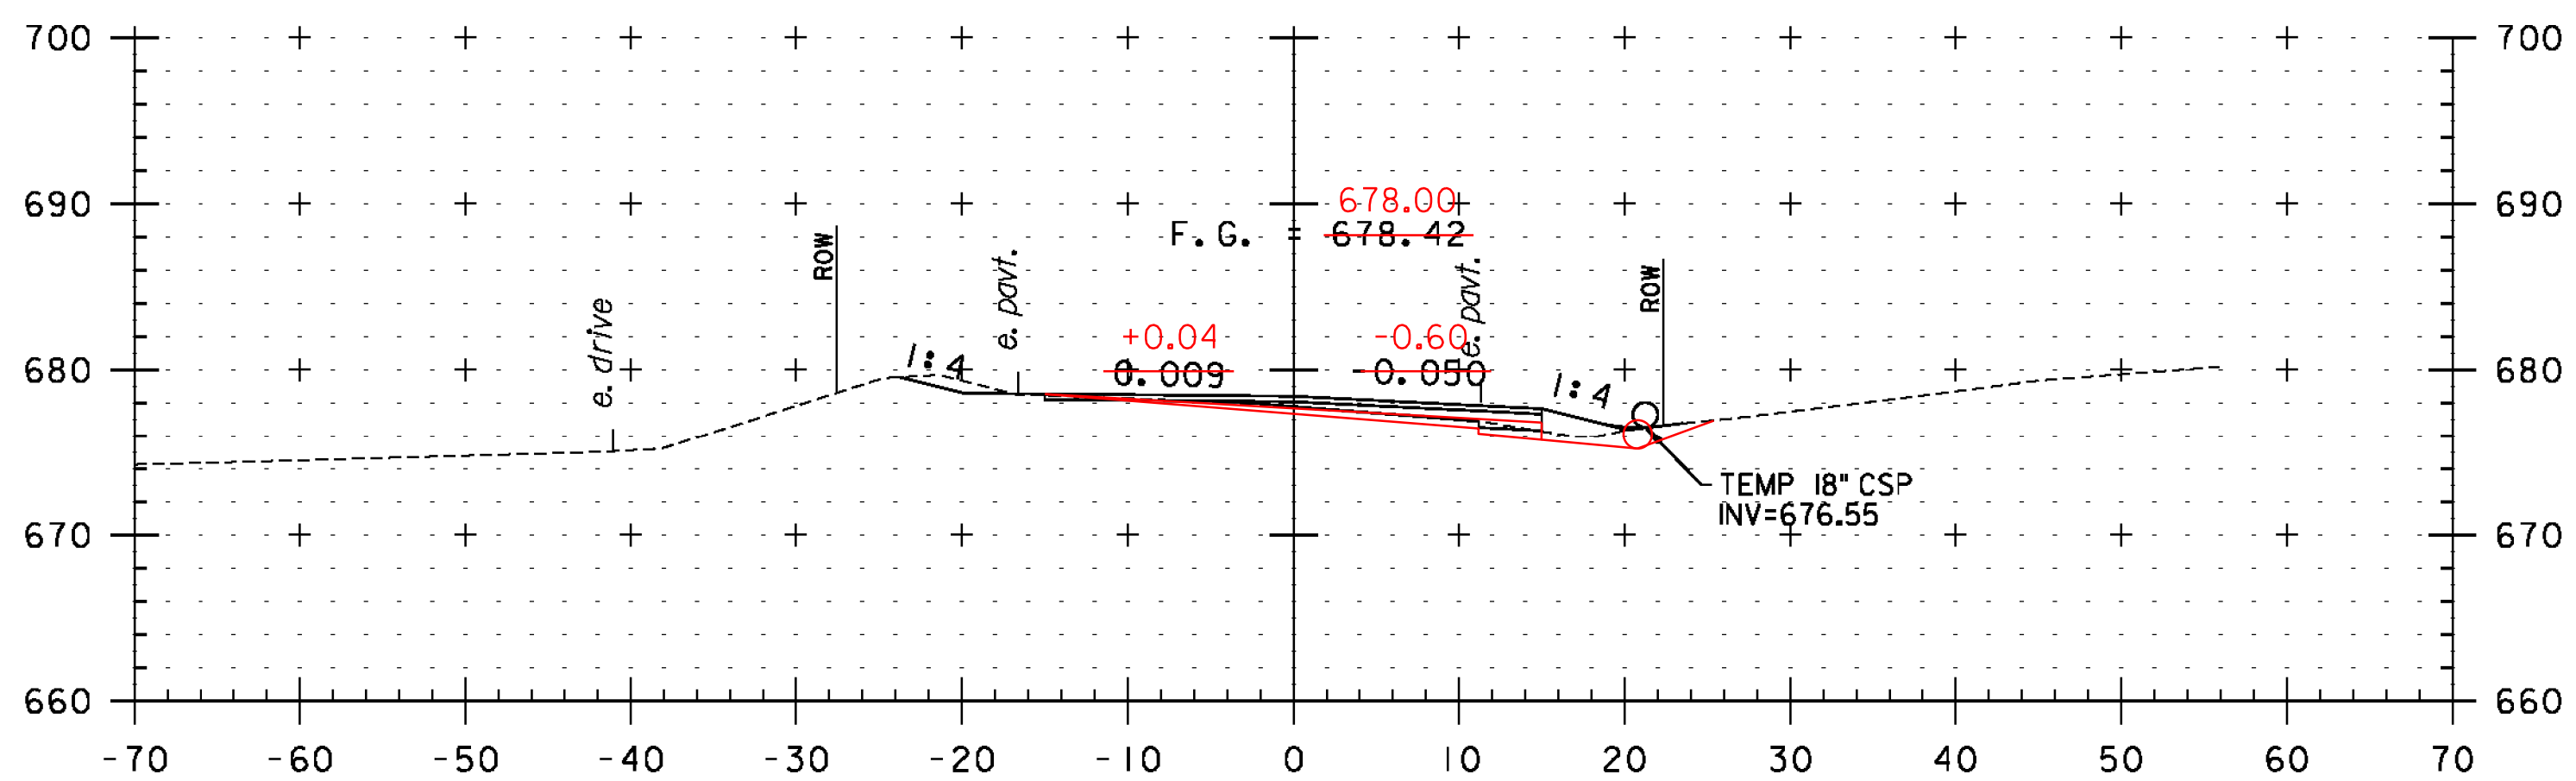


221+50

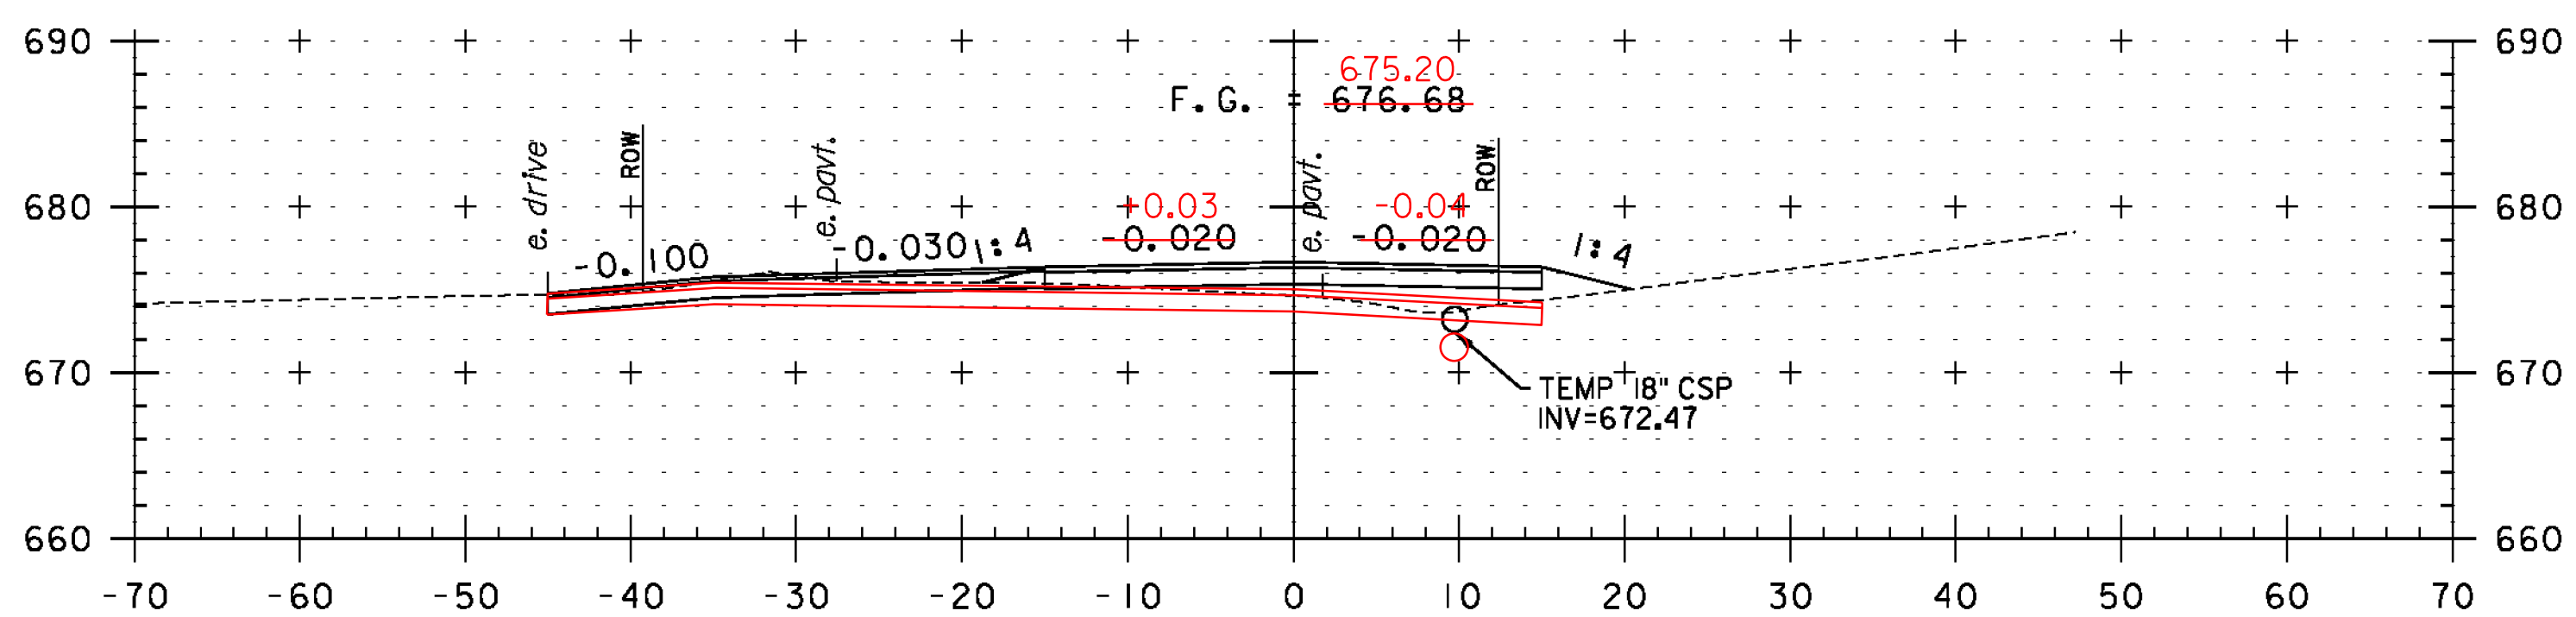


221+00.00  
DRIVE LT

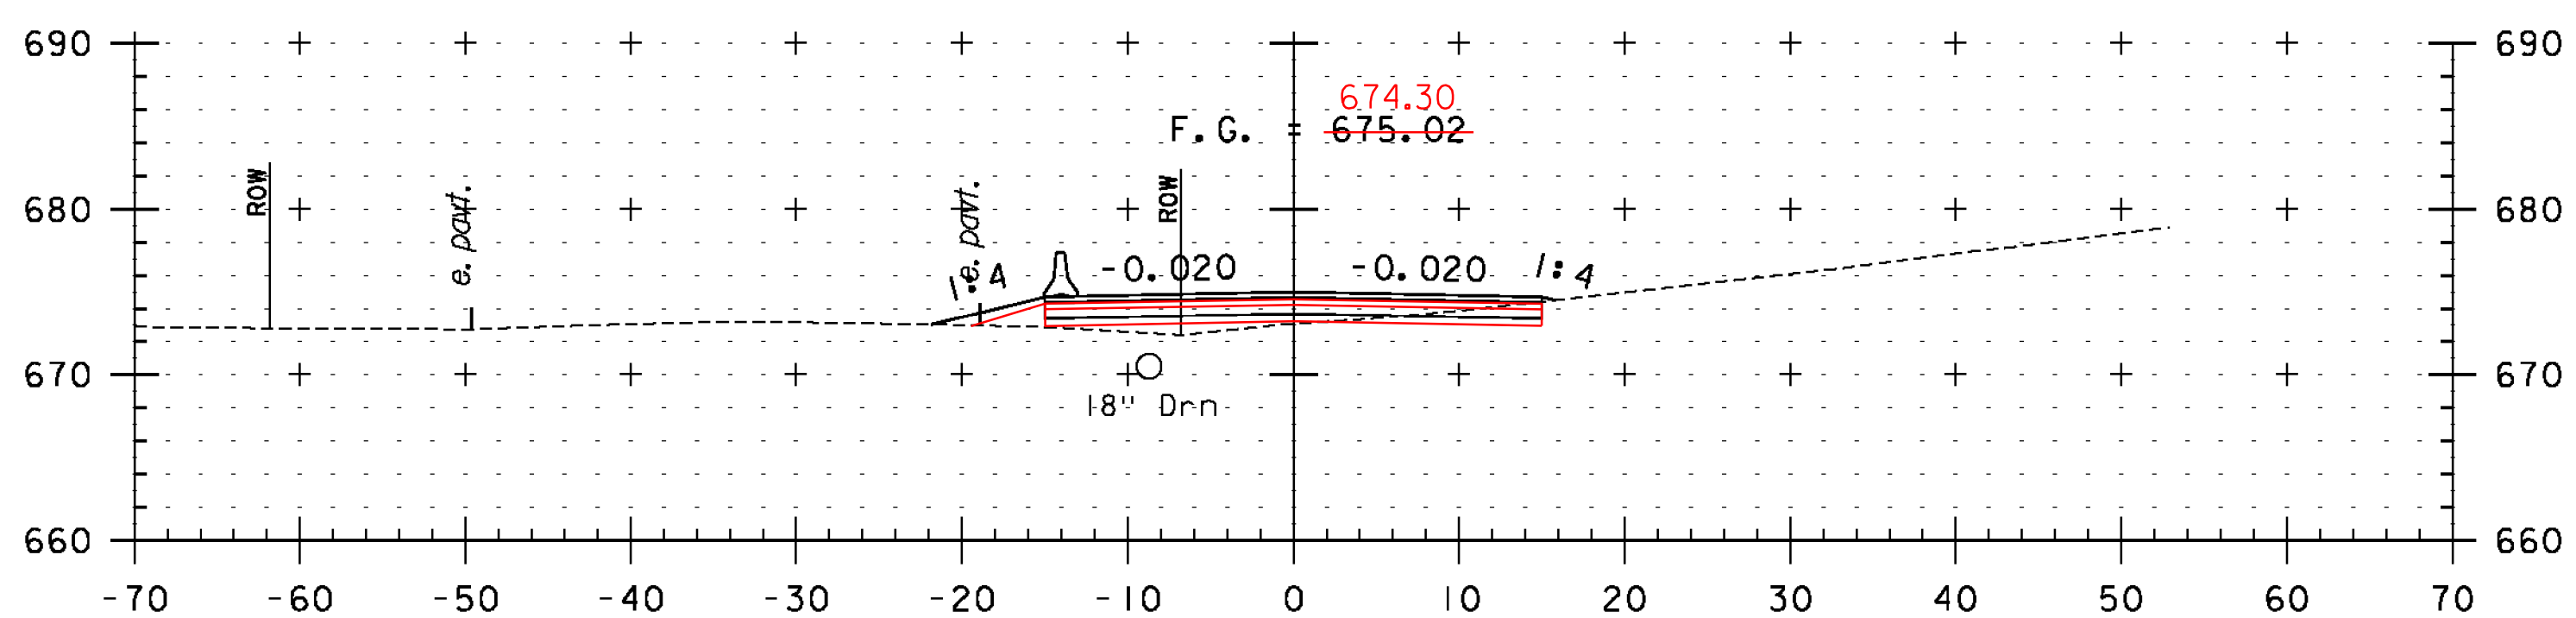

220+50

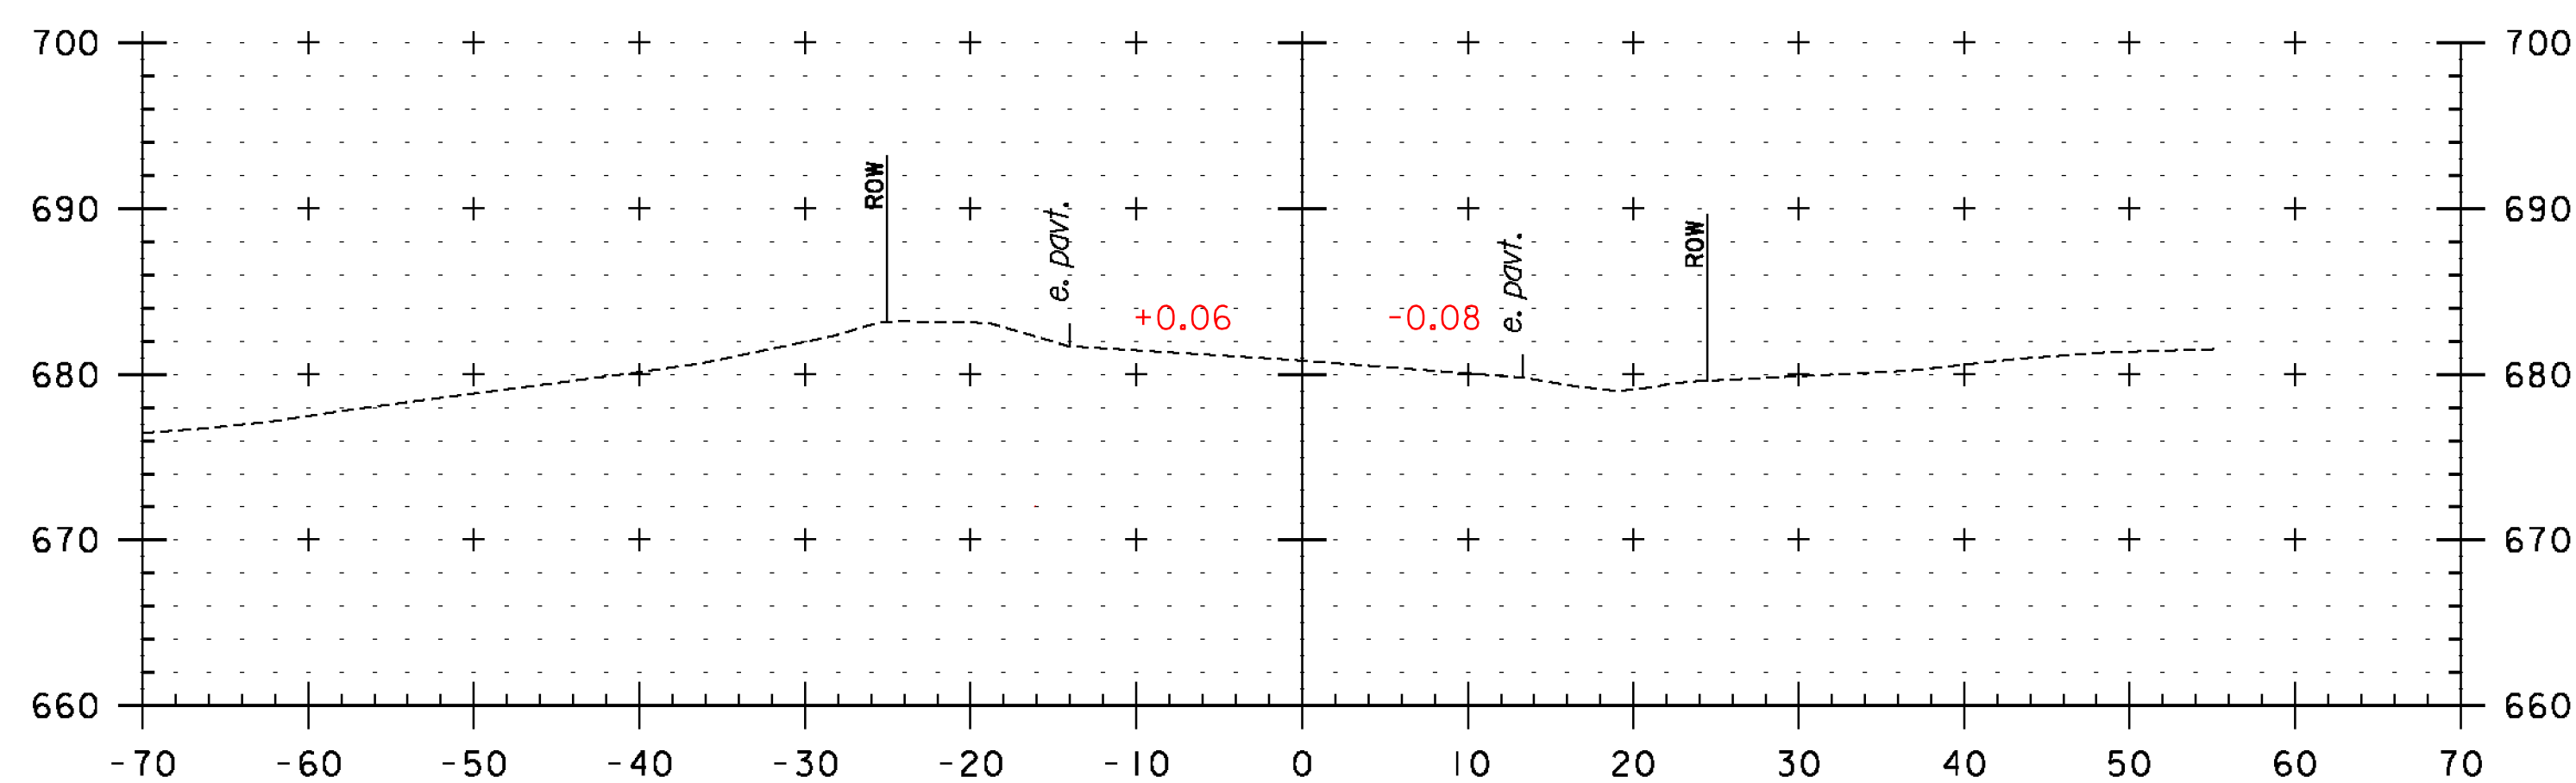

222+00

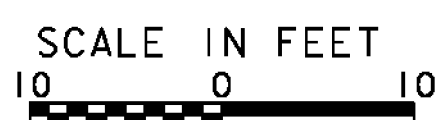

STA. 220+50 TO STA. 222+00

PROJECT NAME: BARRE TOWN	PLOT DATE: 2/13/2014
PROJECT NUMBER: STP SCRP(10)	DRAWN BY: P. SHEDD
FILE NAME: z10d202xsl_Detour.dgn	CHECKED BY: D. MUNRO
PROJECT LEADER: K. UPMAL	TRAFFIC CONTROL CROSS SECTION SHEET 3
DESIGNED BY: P. SHEDD	SHEET 42 OF 43