

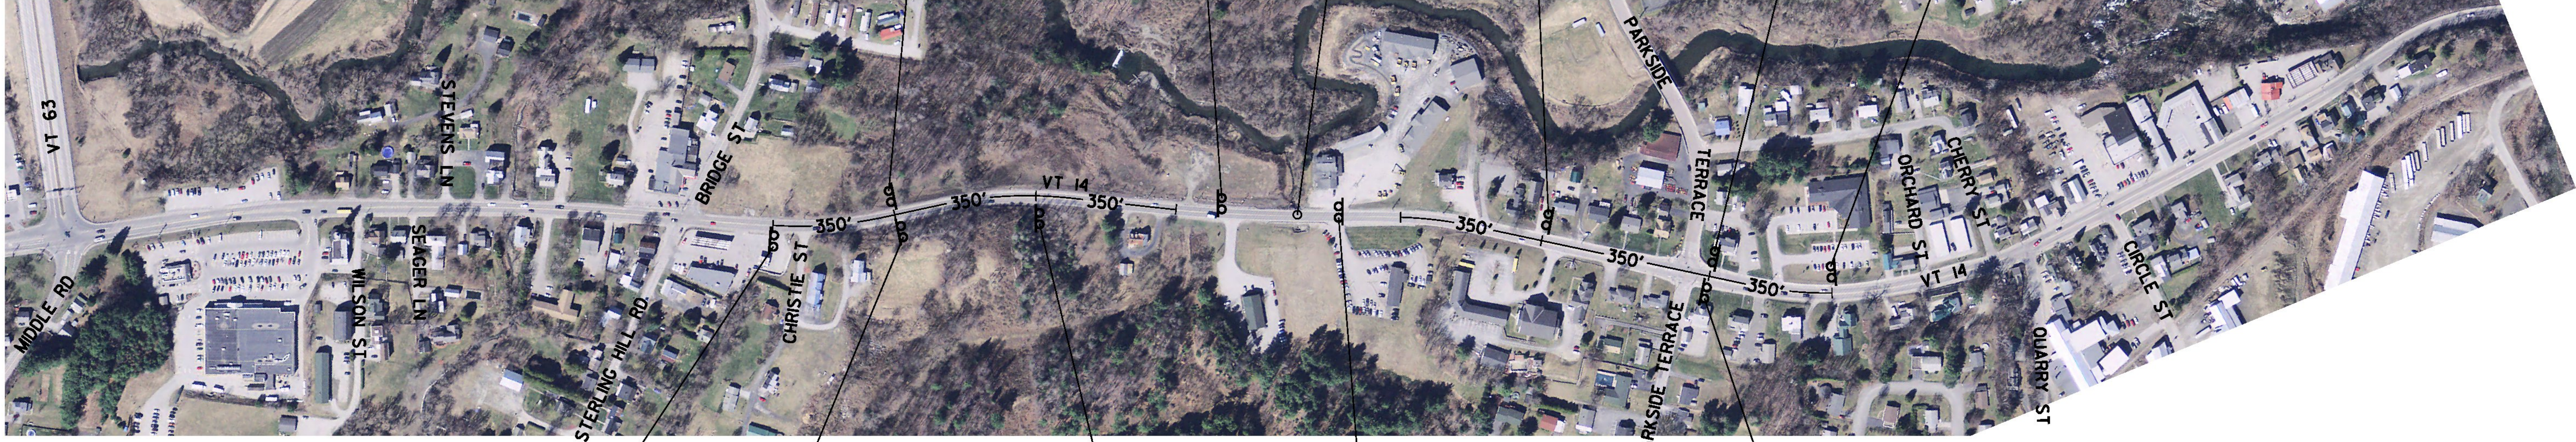



VT 14 STA 119+22.00 =
 BOX CULVERT STA. 319+22.00
 ASKEW ANGLE = 78°00'00" RT

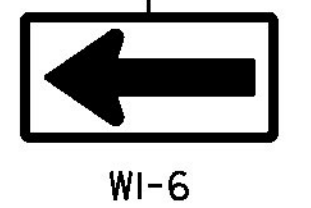

G20-2
 END
 ROAD WORK

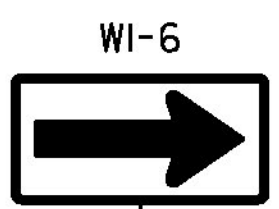

END
 ROAD WORK
 G20-2

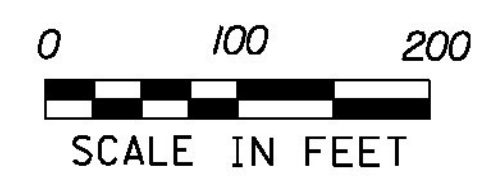

PROJECT NAME: BARRE TOWN	PLOT DATE: 2/13/2014
PROJECT NUMBER: STP SCR(10)	DRAWN BY: M. HALEY
FILE NAME: z10d202+cp.dgn	CHECKED BY: P. SHEDD
PROJECT LEADER: K. UPMAL	SHEET 43 OF 43
DESIGNED BY: M. HALEY	
TRAFFIC CONTROL SIGN PLAN	

CLD II-0160