


QUANTITY SHEET 3

SUMMARY OF ESTIMATED QUANTITIES							TOTALS		DESCRIPTIONS				DETAILED SUMMARY OF QUANTITIES		
	ROADWAY	EROSION CONTROL	UTILITIES	BRIDGE	FULL C.E.	WATERLINE	GRAND TOTAL	FINAL	UNIT	ITEMS	ITEM NUMBER	ROUND	QUANTITIES	UNIT	ITEMS
		1					1		LS	EPSC PLAN	652.10				
		80					80		HR	MONITORING EPSC PLAN	652.20				
		1					1		LU	MAINTENANCE OF EPSC PLAN (N.A.B.I.)	652.30				
		12					12		SY	TEMPORARY EROSION MATTING	653.20				
		30					30		CY	VEHICLE TRACKING PAD	653.35				
		7					7		EACH	INLET PROTECTION DEVICE, TYPE I	653.40				
		1					1		EACH	FILTER BAG	653.45				
		355					355		LF	BARRIER FENCE	653.50				
	29						29		SF	TRAFFIC SIGNS, TYPE A	675.20				
	75						75		LF	SQUARE TUBE SIGN POST AND ANCHOR	675.341				
	9						9		EACH	REMOVING SIGNS	675.50				
	1						1		EACH	ERECTING SALVAGED SIGNS	675.60				
			1500				1500		LF	ELECTRICAL CONDUIT (4")(PVC)	678.21				
			300				300		LF	WIRED CONDUIT (2")(PVC)	678.23				
			4				4		EACH	JUNCTION BOX	678.26				
			175				175		LF	ELECTRICAL CONDUIT SLEEVE (6")(PVC)	678.30				
				4			4		EACH	REMOVING AND RESETTNG LIGHT POLE	679.25				
				4			4		EACH	LUMINAIRE	679.50				
				1			1		EACH	POWER DROP STANCHION, STREET LIGHTING	679.55				
	1						1		LU	PRICE ADJUSTMENT, FUEL (N.A.B.I.)	690.50				
		15					15		CY	SPECIAL PROVISION (STONE FILL, STREAM BED MATERIAL)(TYPE III)	900.608				
	174720						174720		DL	SPECIAL PROVISION (INCENTIVE/DISINCENTIVE)(N.A.B.I.)	900.615				
				6			6		EACH	SPECIAL PROVISION (CPM SCHEDULE)	900.620				
				4			4		EACH	SPECIAL PROVISION (GUARDRAIL APPROACH SECTION, GALVANIZED 2 RAIL BOX BEAM)(COATED BLACK)	900.620				
				220			220		LF	SPECIAL PROVISION (BRIDGE RAILING, GALVANIZED STEEL TUBING/CONCRETE COMBINATION)(COATED BLACK)	900.640				
	160						160		LF	SPECIAL PROVISION (DURABLE CROSSWALK MARKING, IMPRINTED/COLORIZED)	900.640				
				1			1		LS	SPECIAL PROVISION (METALLIZING STRUCTURAL STEEL) (INCLUDES VE STRUCT. STEEL)	900.645				
	1						1		LS	SPECIAL PROVISION (TRAFFIC CONTROL, ALL-INCLUSIVE)	900.645				
						1	1		LS	SPECIAL PROVISION (WATER MAIN ON BRIDGE)(8")	900.645				
	1						1		LU	SPECIAL PROVISION (MAT DENSITY PAY ADJUSTMENT, SMALL QUANTITY)(N.A.B.I.)	900.650				
	1						1		LU	SPECIAL PROVISION (MIXTURE PAY ADJUSTMENT)(N.A.B.I.)	900.650				
				3450			3450		SF	SPECIAL PROVISION (CONCRETE BRIDGE DECK SURFACE PREPARATION)	900.670				
				39			39		CY	SP HP RAPID-SET CONCRETE (F) (PILE CAVITIES/BACKWALL) (FPQ) (VE MODIFIED QUANTITY)	900.608				
				5			5		CY	SP ULTRA HP CONCRETE (F) - APPROACH SLABS- NO MOCKUP (VE MODIFIED QUANTITY)	900.608				
	660						660		TON	SPECIAL PROVISION (BITUMINOUS CONCRETE PAVEMENT, SMALL QUANTITY)	900.680				

CALDERWOOD ENGINEERING, ETC.
STRUCTURAL ENGINEERING • DETAILING SERVICES
222 RIVER RD. RICHMOND, ME 04357 PH/FX (207)737-2007/(207) 737-2008
PREPARED FOR:
COLD RIVER BRIDGES, LLC
01-CS-LUDLOW

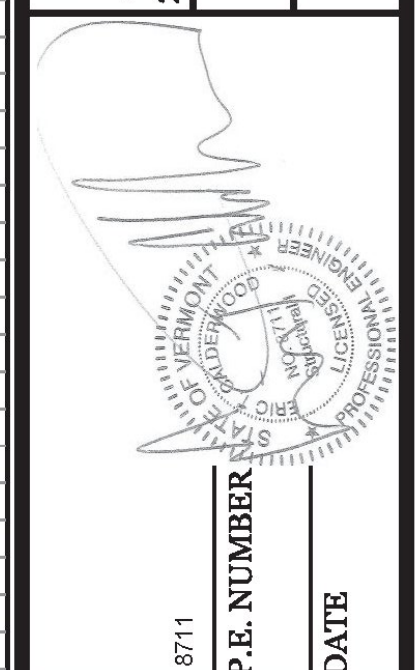

DESIGN-REVIEWED	TDC	DATE	JAN 2017
CHECKED-REVIEWED	TDC	BY	TDC
REVISIONS 1		P.E. NUMBER	8711
REVISIONS 2		DATE	MAR 2017
REVISIONS 3			
REVISIONS 4			
FIELD CHANGES			

VE SUPER DESIGN
LUDLOW VT. BR# 025-1(42)
QUANTITY SHEET (3 OF 3)

SHEET NUMBER
10
of 73

