


WATERLINE - PLAN

SCALE 1" = 10'-0"
 10 0 10

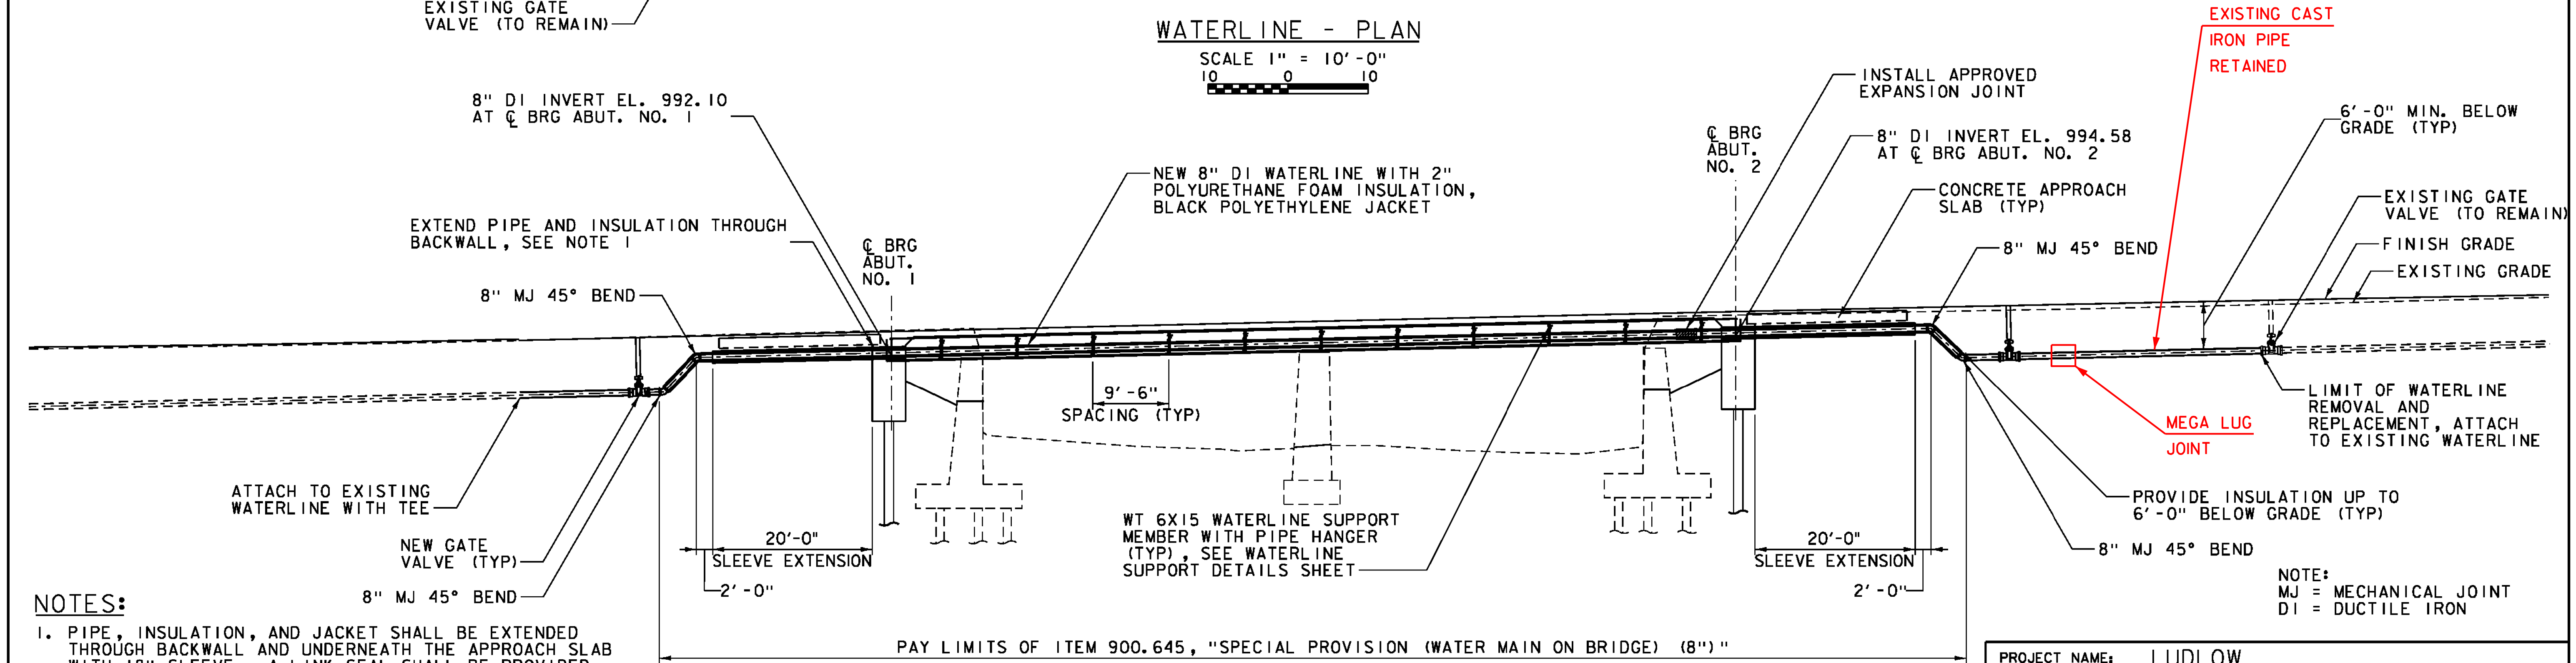

WATERLINE - ELEVATION

SCALE 1" = 10'-0"
 10 0 10

- NOTES:**
- PIPE, INSULATION, AND JACKET SHALL BE EXTENDED THROUGH BACKWALL AND UNDERNEATH THE APPROACH SLAB WITH 18" SLEEVE. A LINK-SEAL SHALL BE PROVIDED BETWEEN THE PIPE AND SLEEVE AT EXPOSED FACE OF ABUTMENT. PIPE SUPPORTS SHALL BE PROVIDED IN SLEEVE AND THE END OF SLEEVE SHALL BE SEALED.
 - PROVIDE THRUST BLOCKS AT ALL BENDS IN THE WATERLINE, 22.5 DEGREES AND GREATER, SEE WATERLINE NOTES AND DETAILS SHEET.

PROJECT NAME:	LUDLOW	FILE NAME:	z10j068watpe.dgn	PLOT DATE:	8/23/2016
PROJECT NUMBER:	BRF 025-1(42)	PROJECT LEADER:	A.P. GUYETTE	DRAWN BY:	R.H. BARNES
		DESIGNED BY:	R.H. BARNES	CHECKED BY:	A.P. GUYETTE
		WATERLINE PLAN AND ELEVATION			SHEET 25 OF 73

