


PLAN
SCALE 1" = 10'-0"
10 0 10

ROADWAY POT STA. 102+94.95 =
CHANNEL POT STA. 11+50.00

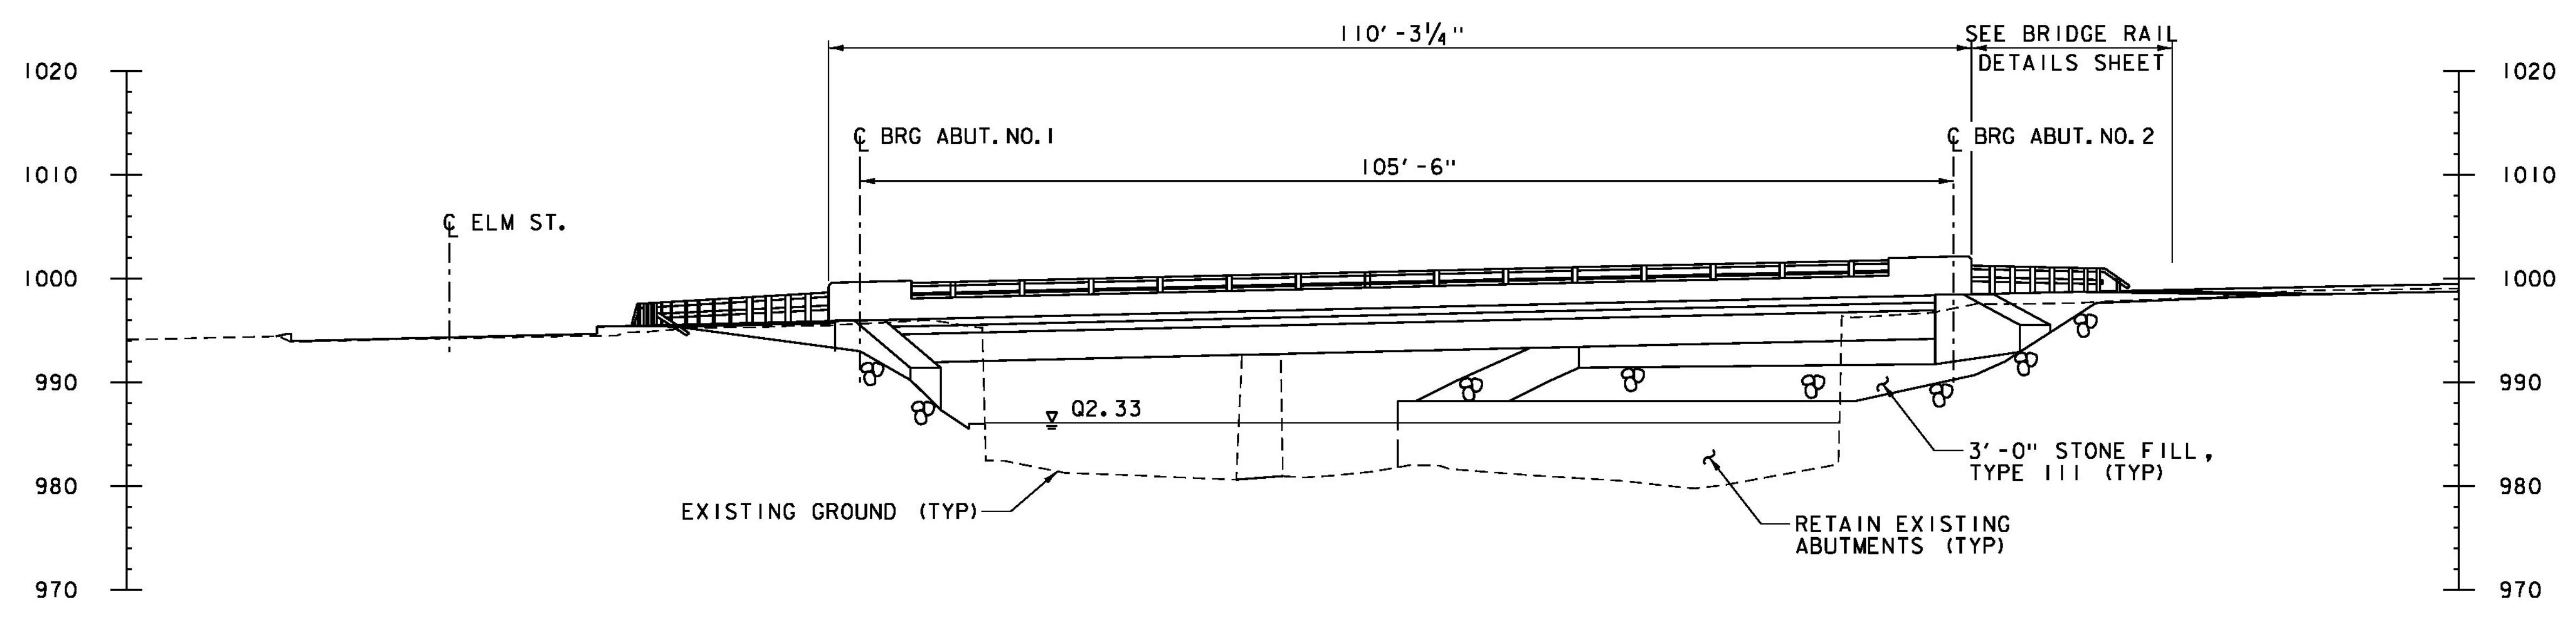

ELEVATION
SCALE 1" = 10'-0"
10 0 10

PROJECT NAME:	LUDLOW	PLOT DATE:	8/23/2016
PROJECT NUMBER:	BHF 025-(42)	DRAWN BY:	E.F. LAWES
FILE NAME:	z10J068p.dgn	DESIGNED BY:	E.F. LAWES
PROJECT LEADER:	A.P. GUYETTE	CHECKED BY:	A.P. GUYETTE
DESIGNED BY:	E.F. LAWES	PLAN AND ELEVATION	SHEET 35 OF 73

