


ABUTMENT NO. 1 PLAN
SCALE 3/8" = 1'-0"

GIRDER TABLE ELEVATION	
GIRDER	ELEVATION
G1	990.65
G2	990.80
G3	990.92
G4	991.06
G5	991.18
G6	991.32
G7	991.38
G8	991.36
G9	991.34
G10	991.32
G11	991.31
G12	991.29

ALL ELEVATIONS ARE AT BOTTOM OF BOTTOM FLANGE.

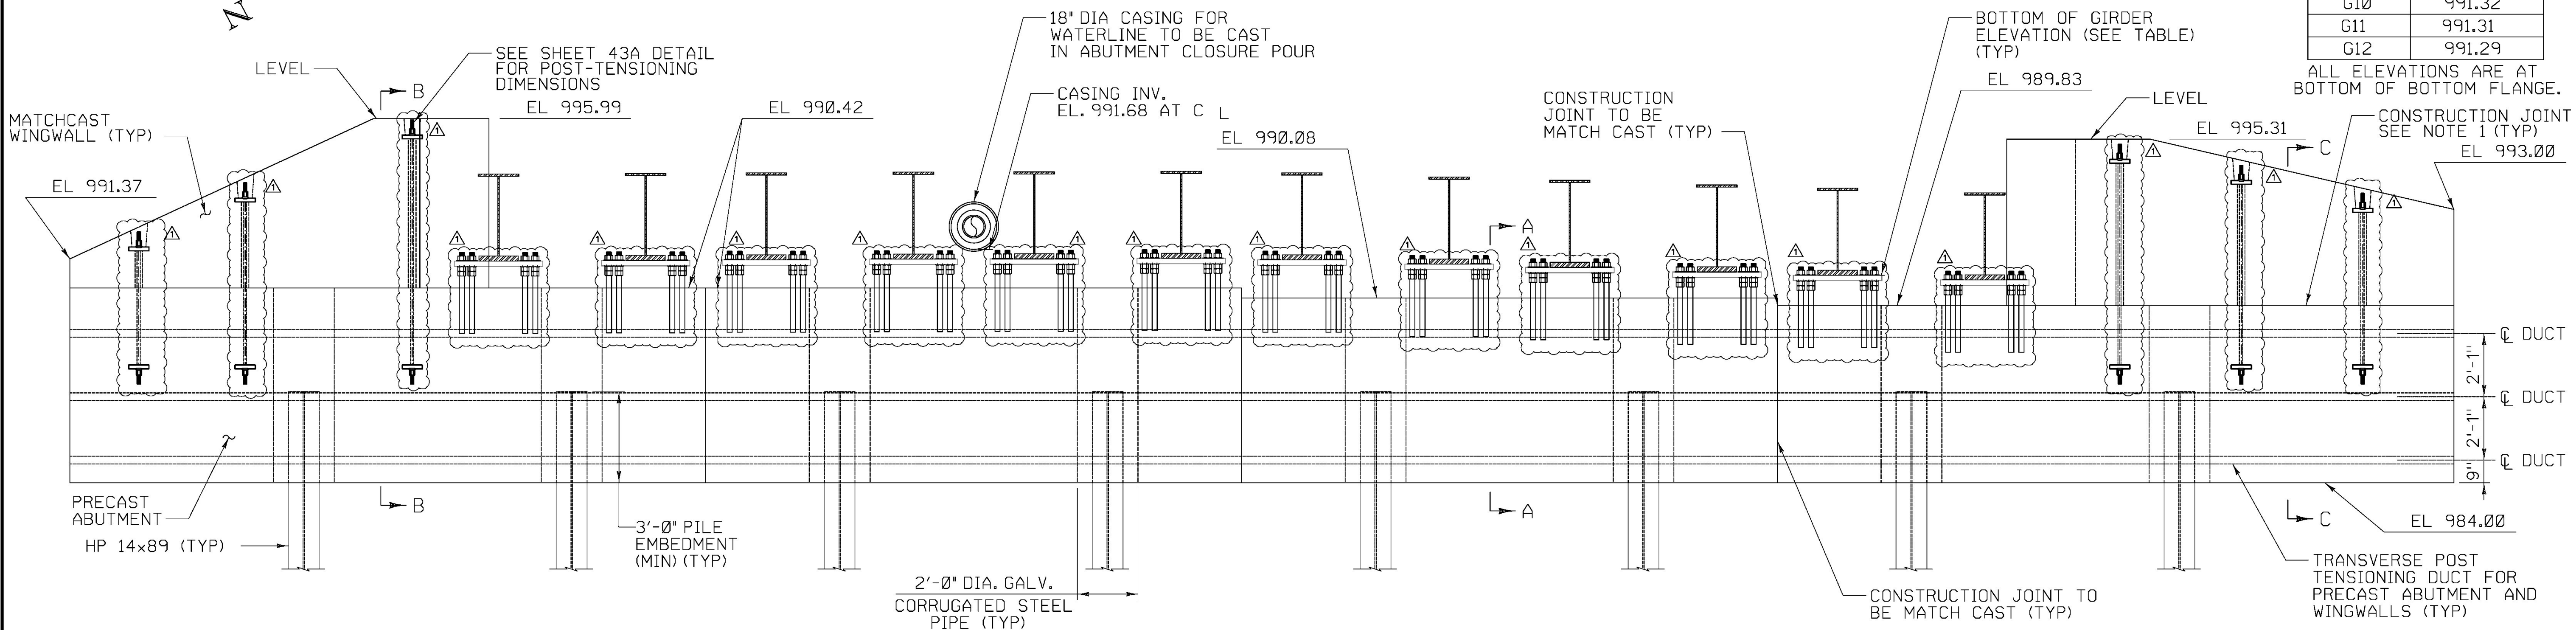


ABUTMENT NO. 1 ELEVATION
SCALE 3/8" = 1'-0"

- NOTES:
- ABUTMENT TO BE PRECAST AS SHOWN, ONCE ABUTMENTS ARE POST-TENSIONED AND PILE VOIDS FILLED (RSC), THE TOP PORTION OF THE WINGWALLS ARE TO BE INSTALLED.
 - USE 24" GALVANIZED CORRUGATED STEEL PIPE FOR PILE POCKETS CONFORMING TO SUBSECTION 711.01.

SEE ABUTMENT SECTIONS SHEET FOR SECTIONS A-A AND B-B.

CALDERWOOD ENGINEERING, ETC.
STRUCTURAL ENGINEERING • DETAILING SERVICES
222 RIVER RD. RICHMOND, ME 04357 PH/FX (207) 737-2007/(207) 737-2008
PREPARED FOR:
COLD RIVER BRIDGES, LLC
CEE 16-16-COLD RIVER BRIDGES
01-CS-LUDLOW

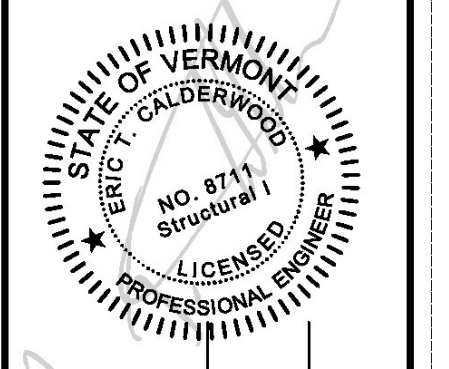

DATE	BY	DESIGN-DETAILED	CHECKED-REVIEWED	REVISIONS 1	REVISIONS 2	REVISIONS 3	REVISIONS 4	FIELD CHANGES
JUN 2017	TDC							
MAR 2017	TDC							

P.L. NUMBER: 8711
DATE:

VE SUPER DESIGN
LUDLOW VT. BR. 025-1(42)
ABUTMENT #1 PLAN AND ELEVATION

SHEET NUMBER

42

of 73

