


ROADWAY CROSS SECTIONS
STA. 103+50 - 104.75

CALDERWOOD ENGINEERING, ETC.
STRUCTURAL ENGINEERING • DETAILING SERVICES
222 RIVER RD. RICHMOND, ME 04857 PH/FX (207) 737-2007/207 737-2008
PREPARED FOR:
COLD RIVER BRIDGES, LLC
CEE 16-16-COLD RIVER BRIDGES
01-CS-LUDLOW

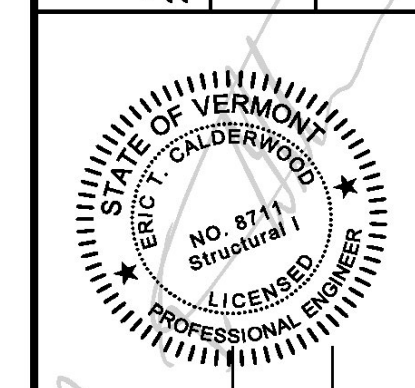

DATE: 8/11
P.E. NUMBER: 8741
DATE:

DATE	MAR 2017
BY	TDC
DESIGN-DETAILED	
CHECKED-REVIEWED	
REVISIONS 1	
REVISIONS 2	
REVISIONS 3	
REVISIONS 4	
FIELD CHANGES	

VE SUPER DESIGN
LUDLOW VT. BR# 025-1(42)
ROADWAY CROSS-SECTIONS (3 OF 4)

SHEET NUMBER

57

of 73

