




10+25

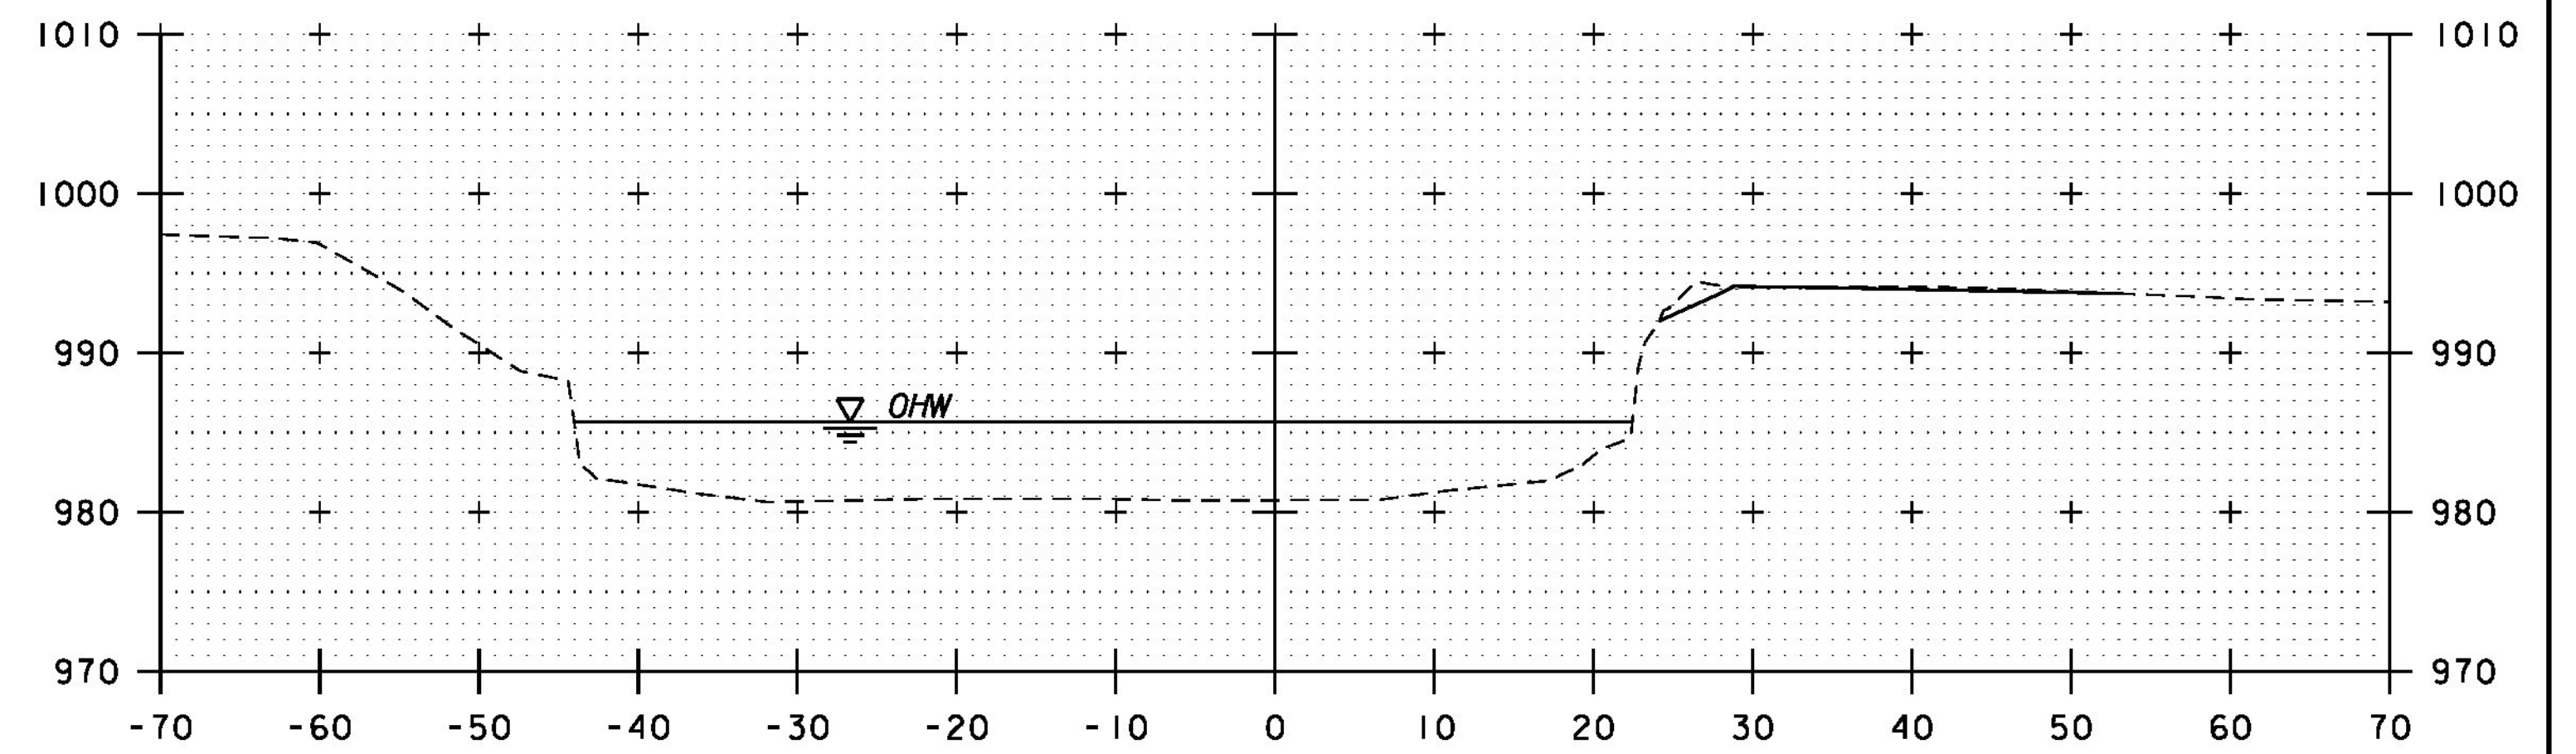

10+75

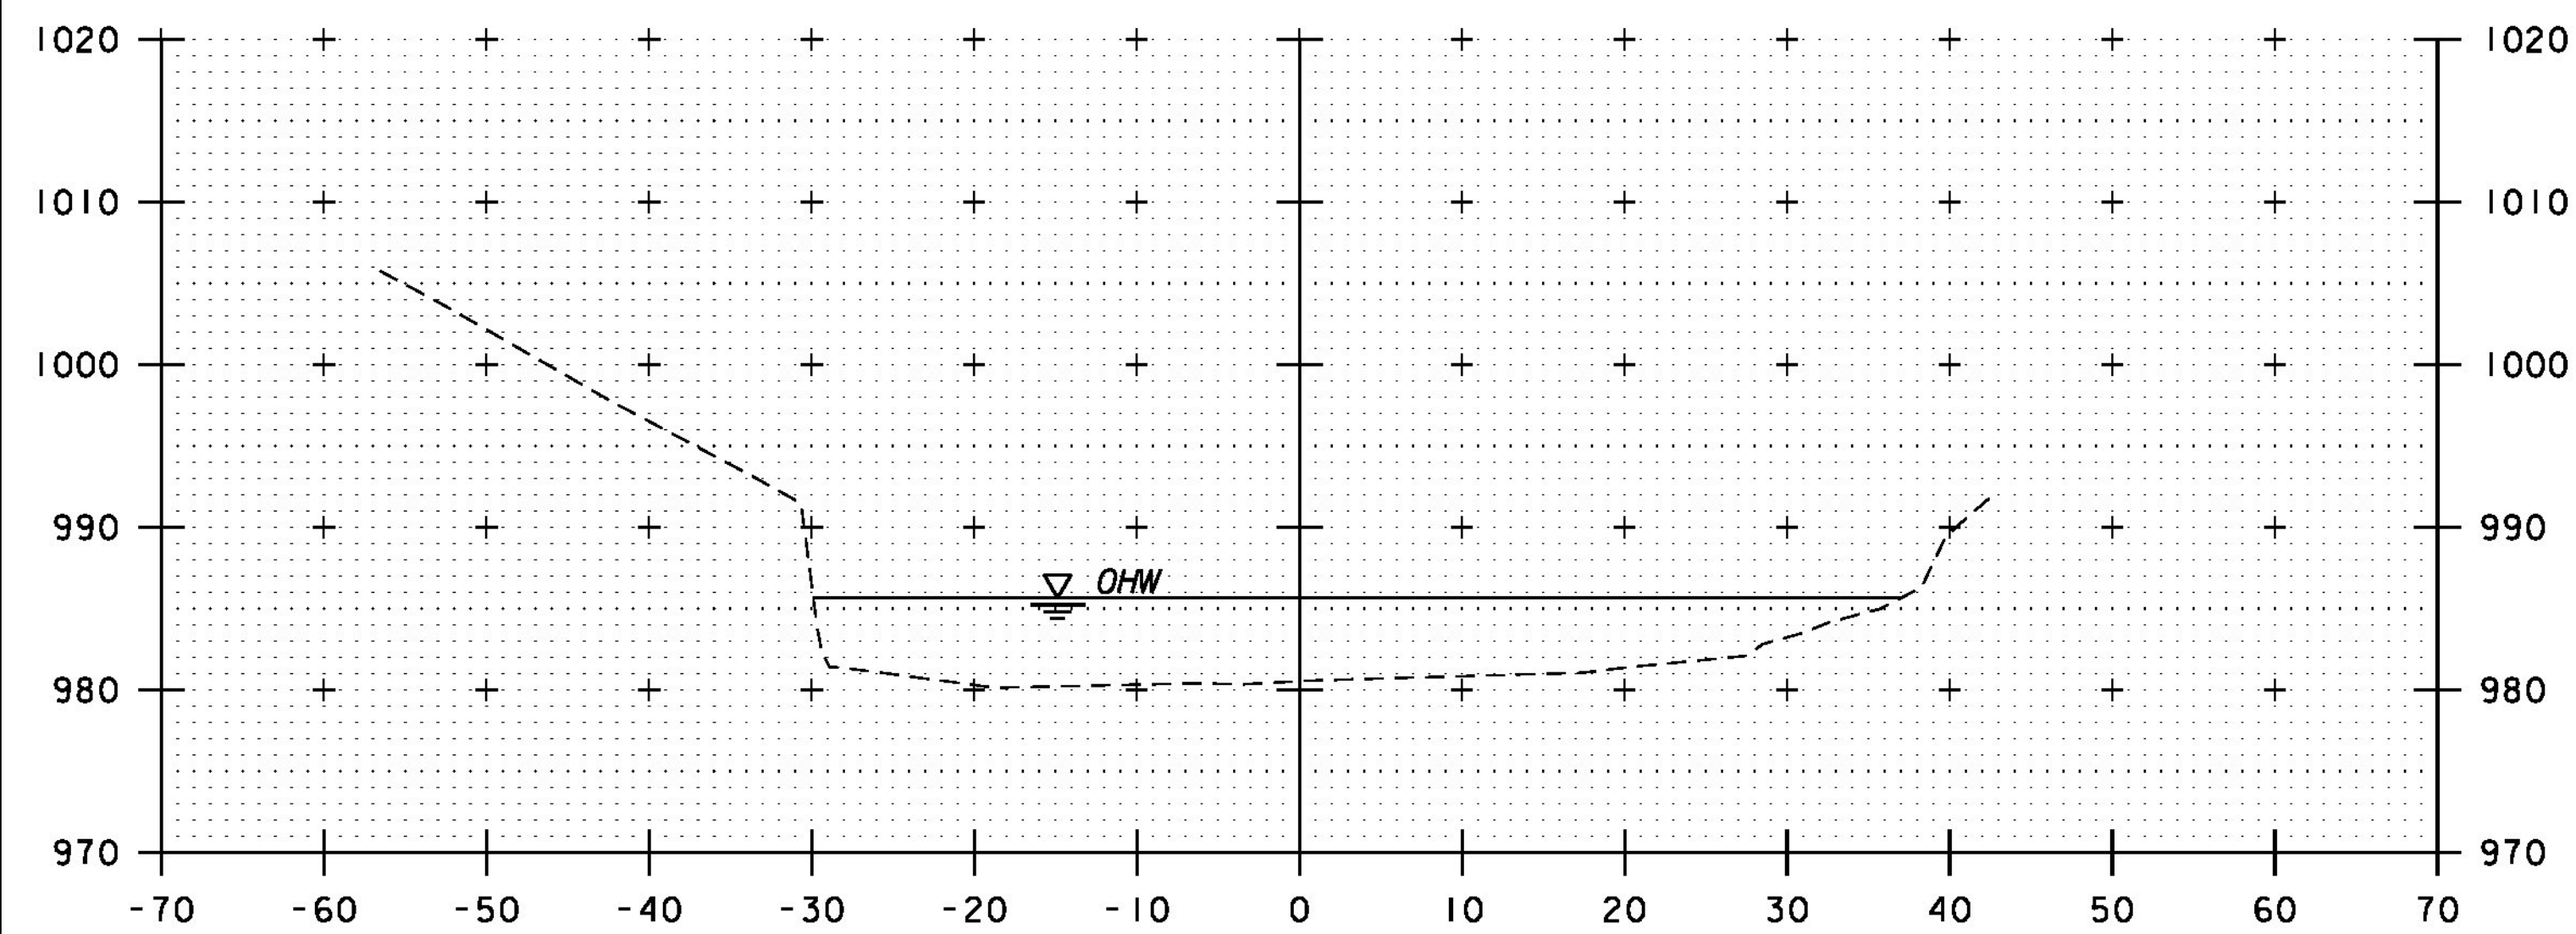

10+00

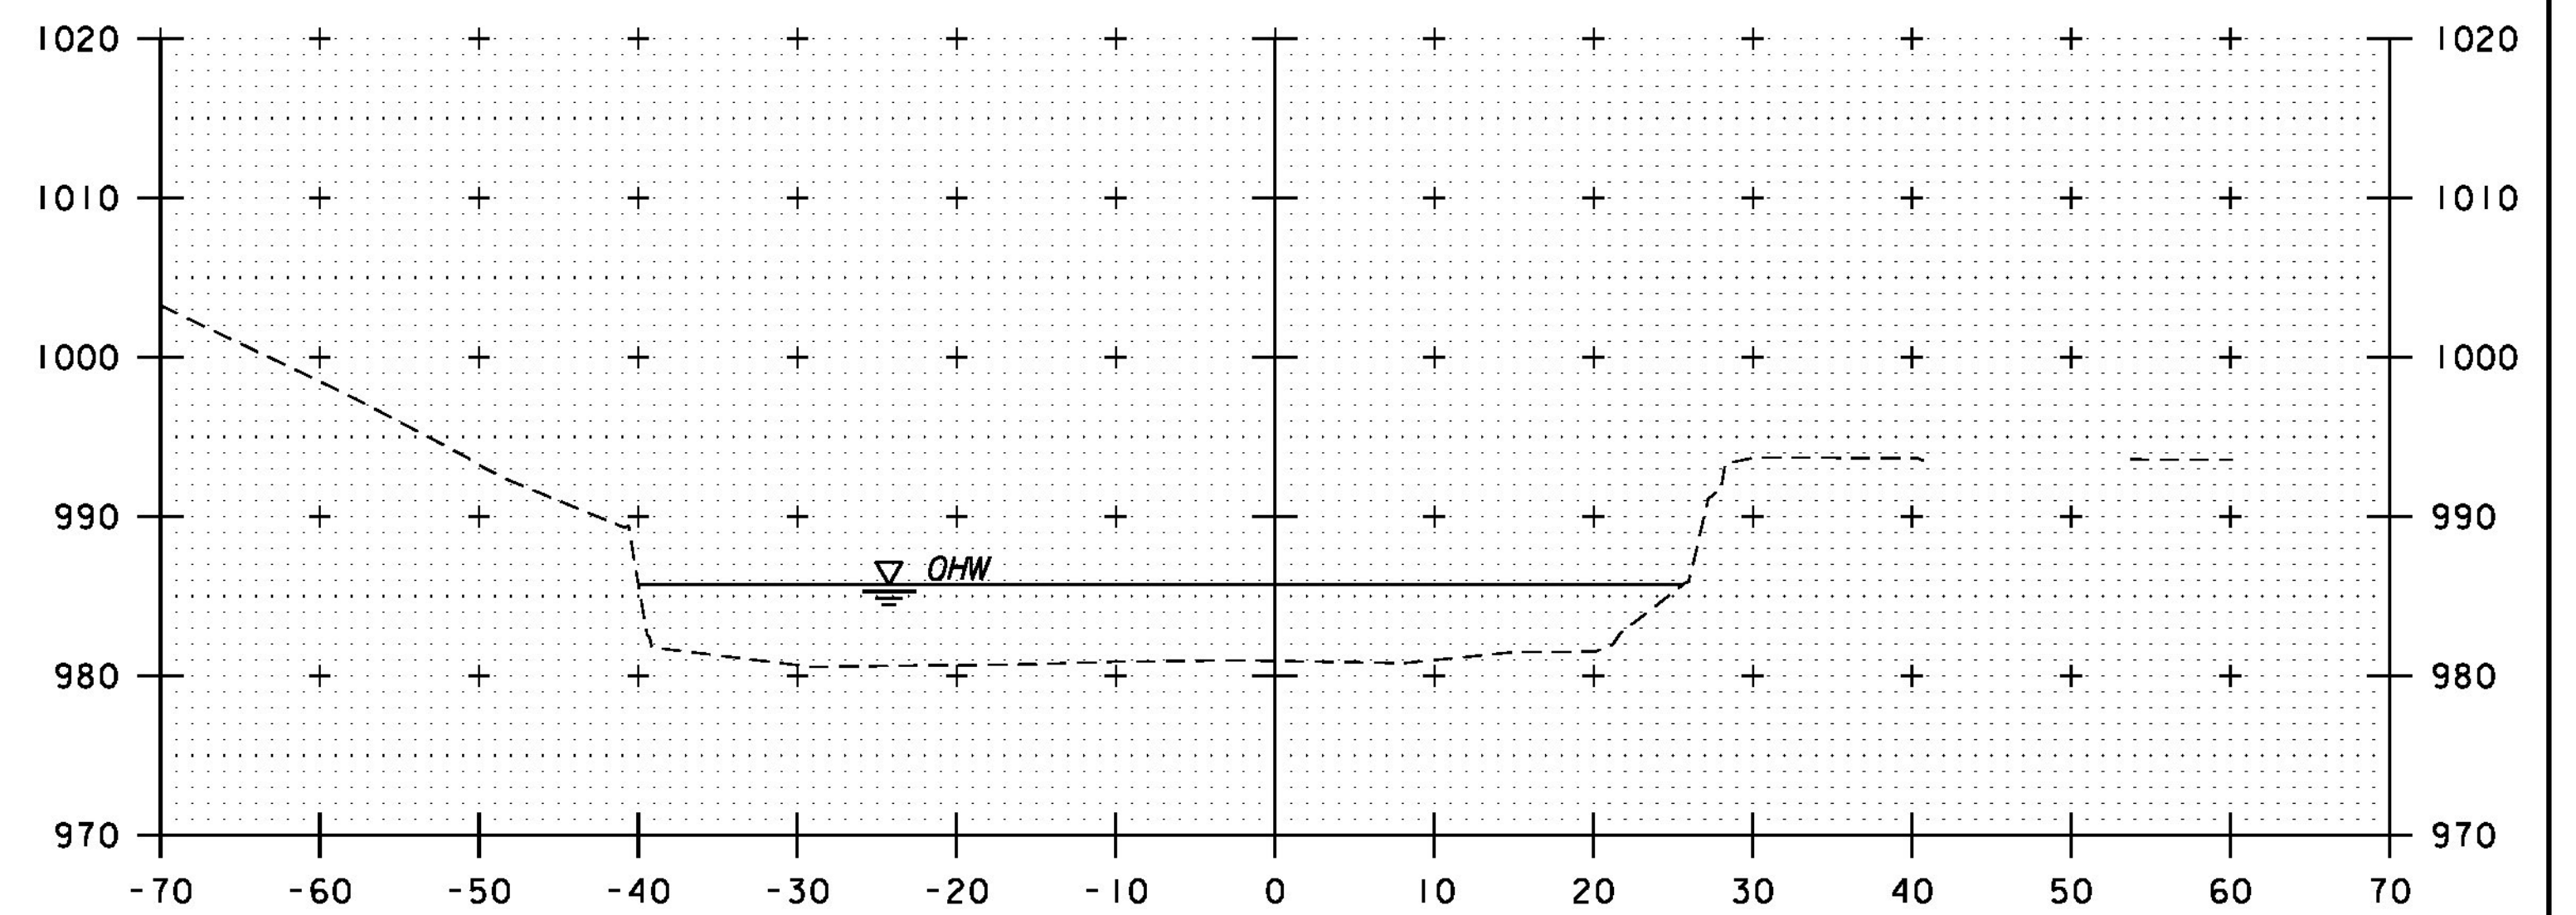

10+50

CHANNEL CROSS SECTIONS
STA. 10+00 TO 10+75

PROJECT NAME: LUDLOW	PLOT DATE: 8/23/2016
PROJECT NUMBER: BRF 025-(142)	DRAWN BY: E.A. FIALA
FILE NAME: z10j068xsl.dgn	DESIGNED BY: E.A. FIALA
PROJECT LEADER: A.P. GUYETTE	CHECKED BY: A.P. GUYETTE
CHANNEL CROSS SECTIONS (1 OF 3)	SHEET 59 OF 73

