


STA. 12+40, LT  
 END UNCLASSIFIED CHANNEL EXCAVATION  
 GEOTEXTILE UNDER STONE FILL  
 STONE FILL, TYPE III  
 GRUBBING MATERIAL


12+50

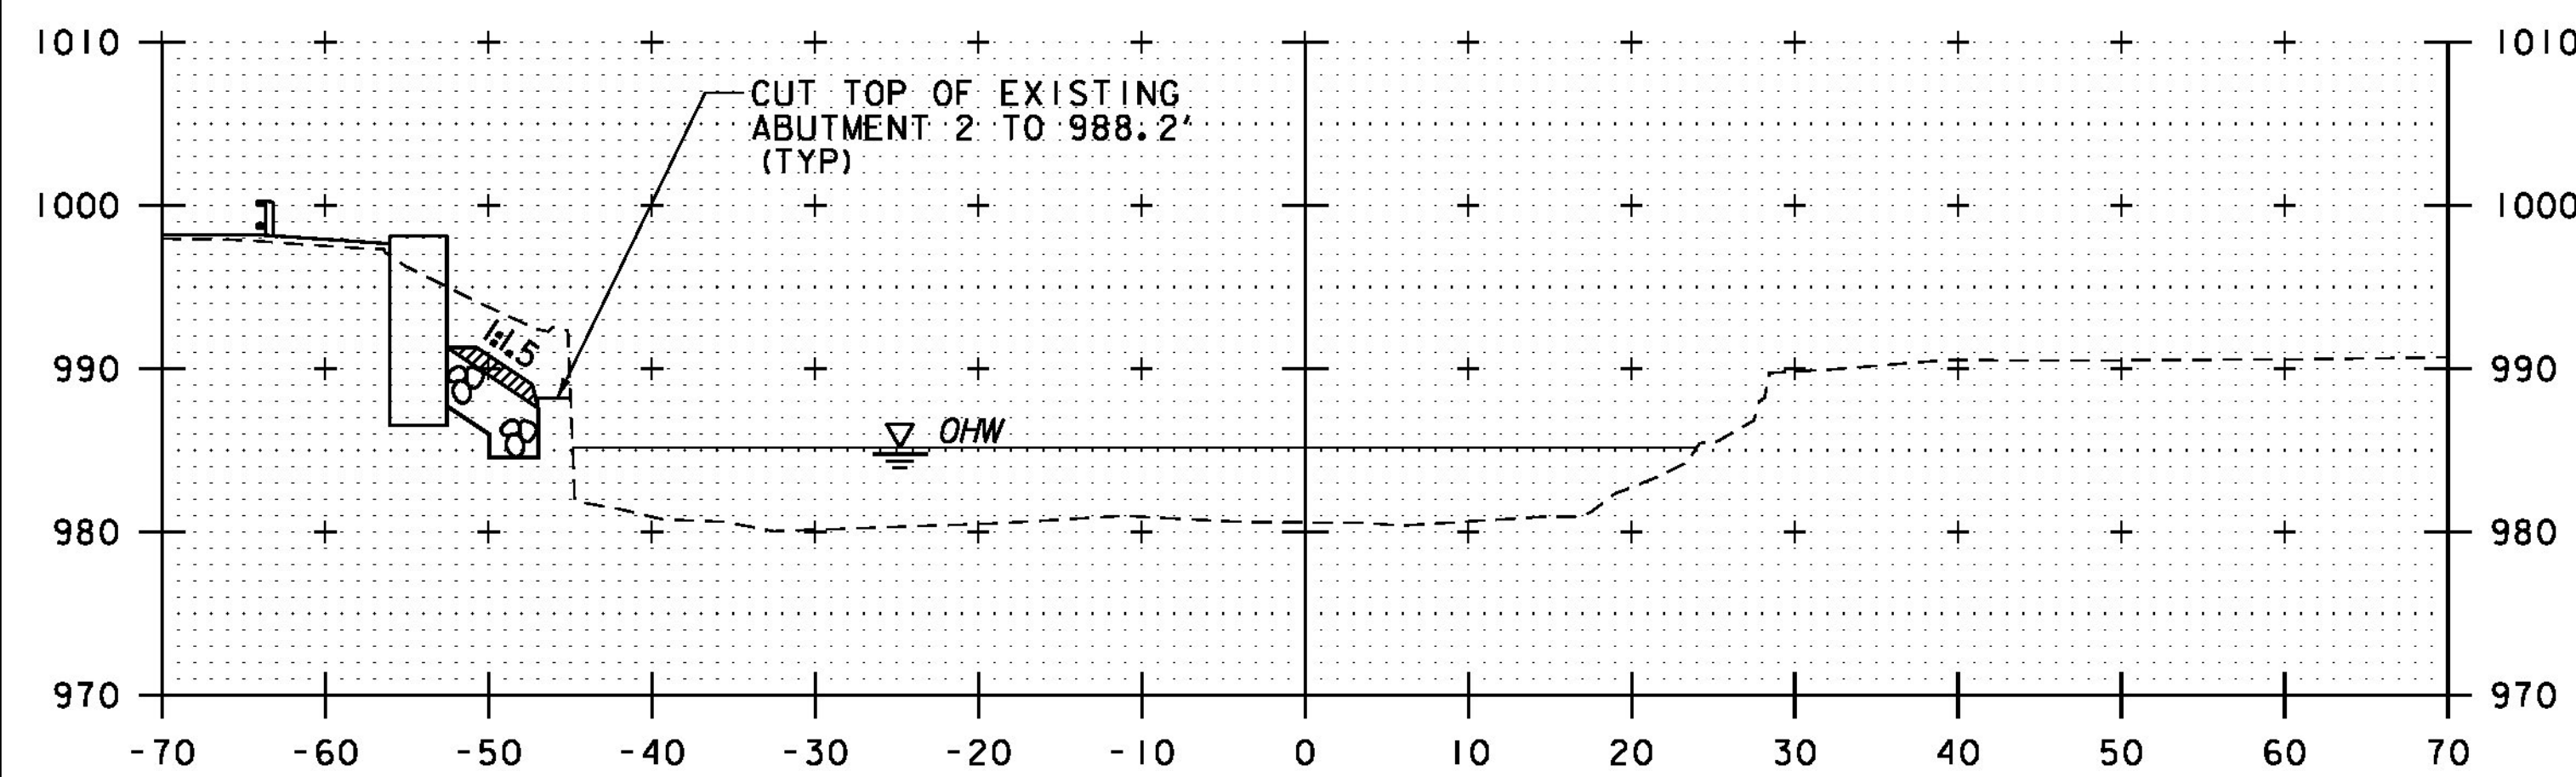


CUT TOP OF EXISTING  
 ABUTMENT 2 TO 988.2'  
 (TYP)

STA. 12+09, LT  
 BEGIN GRUBBING MATERIAL

12+25

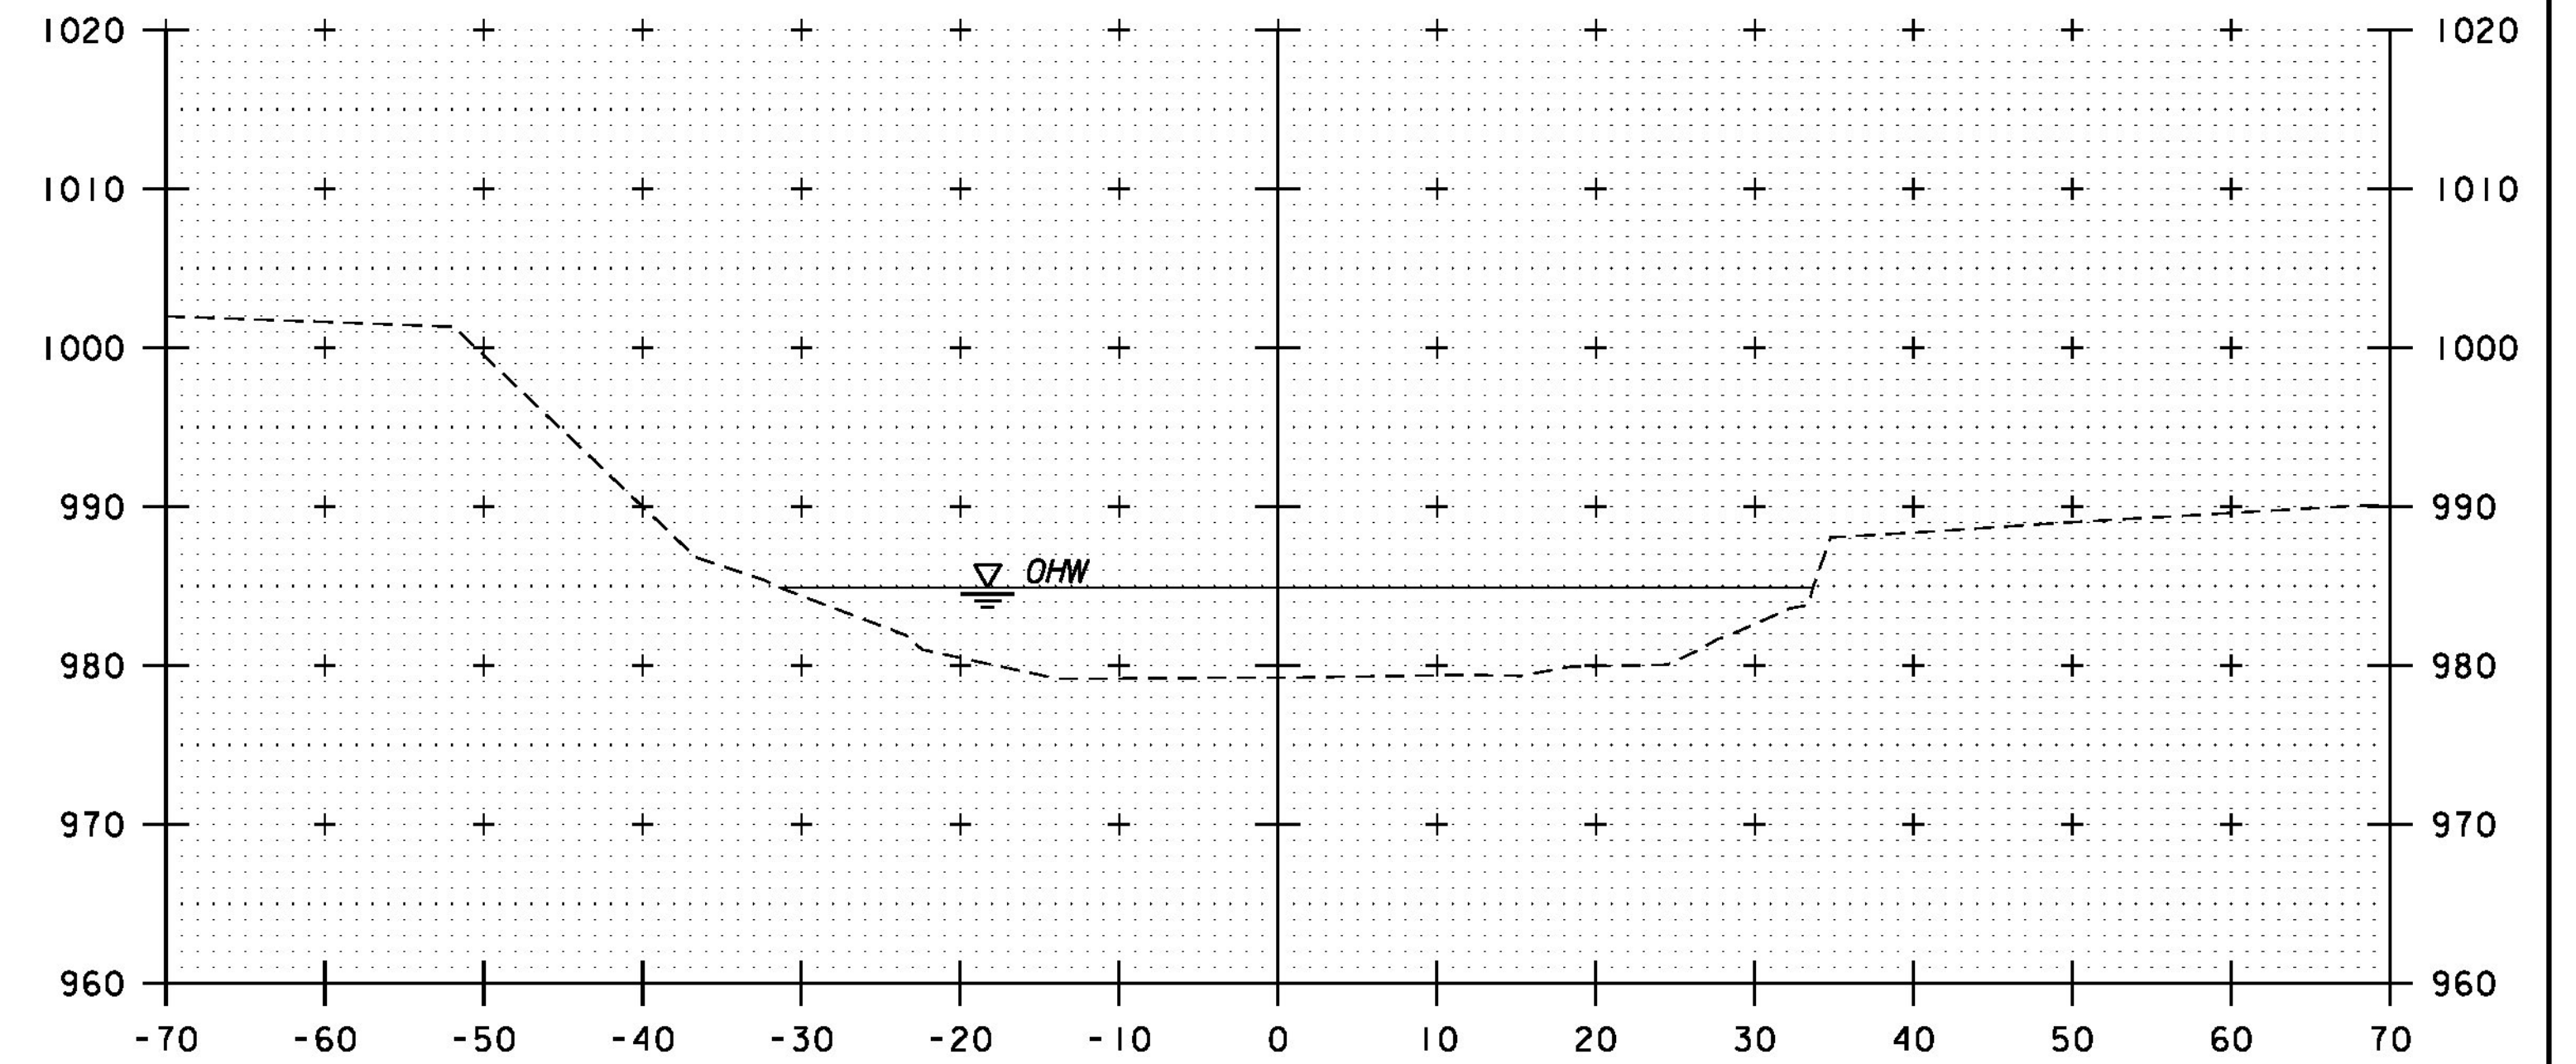

13+00

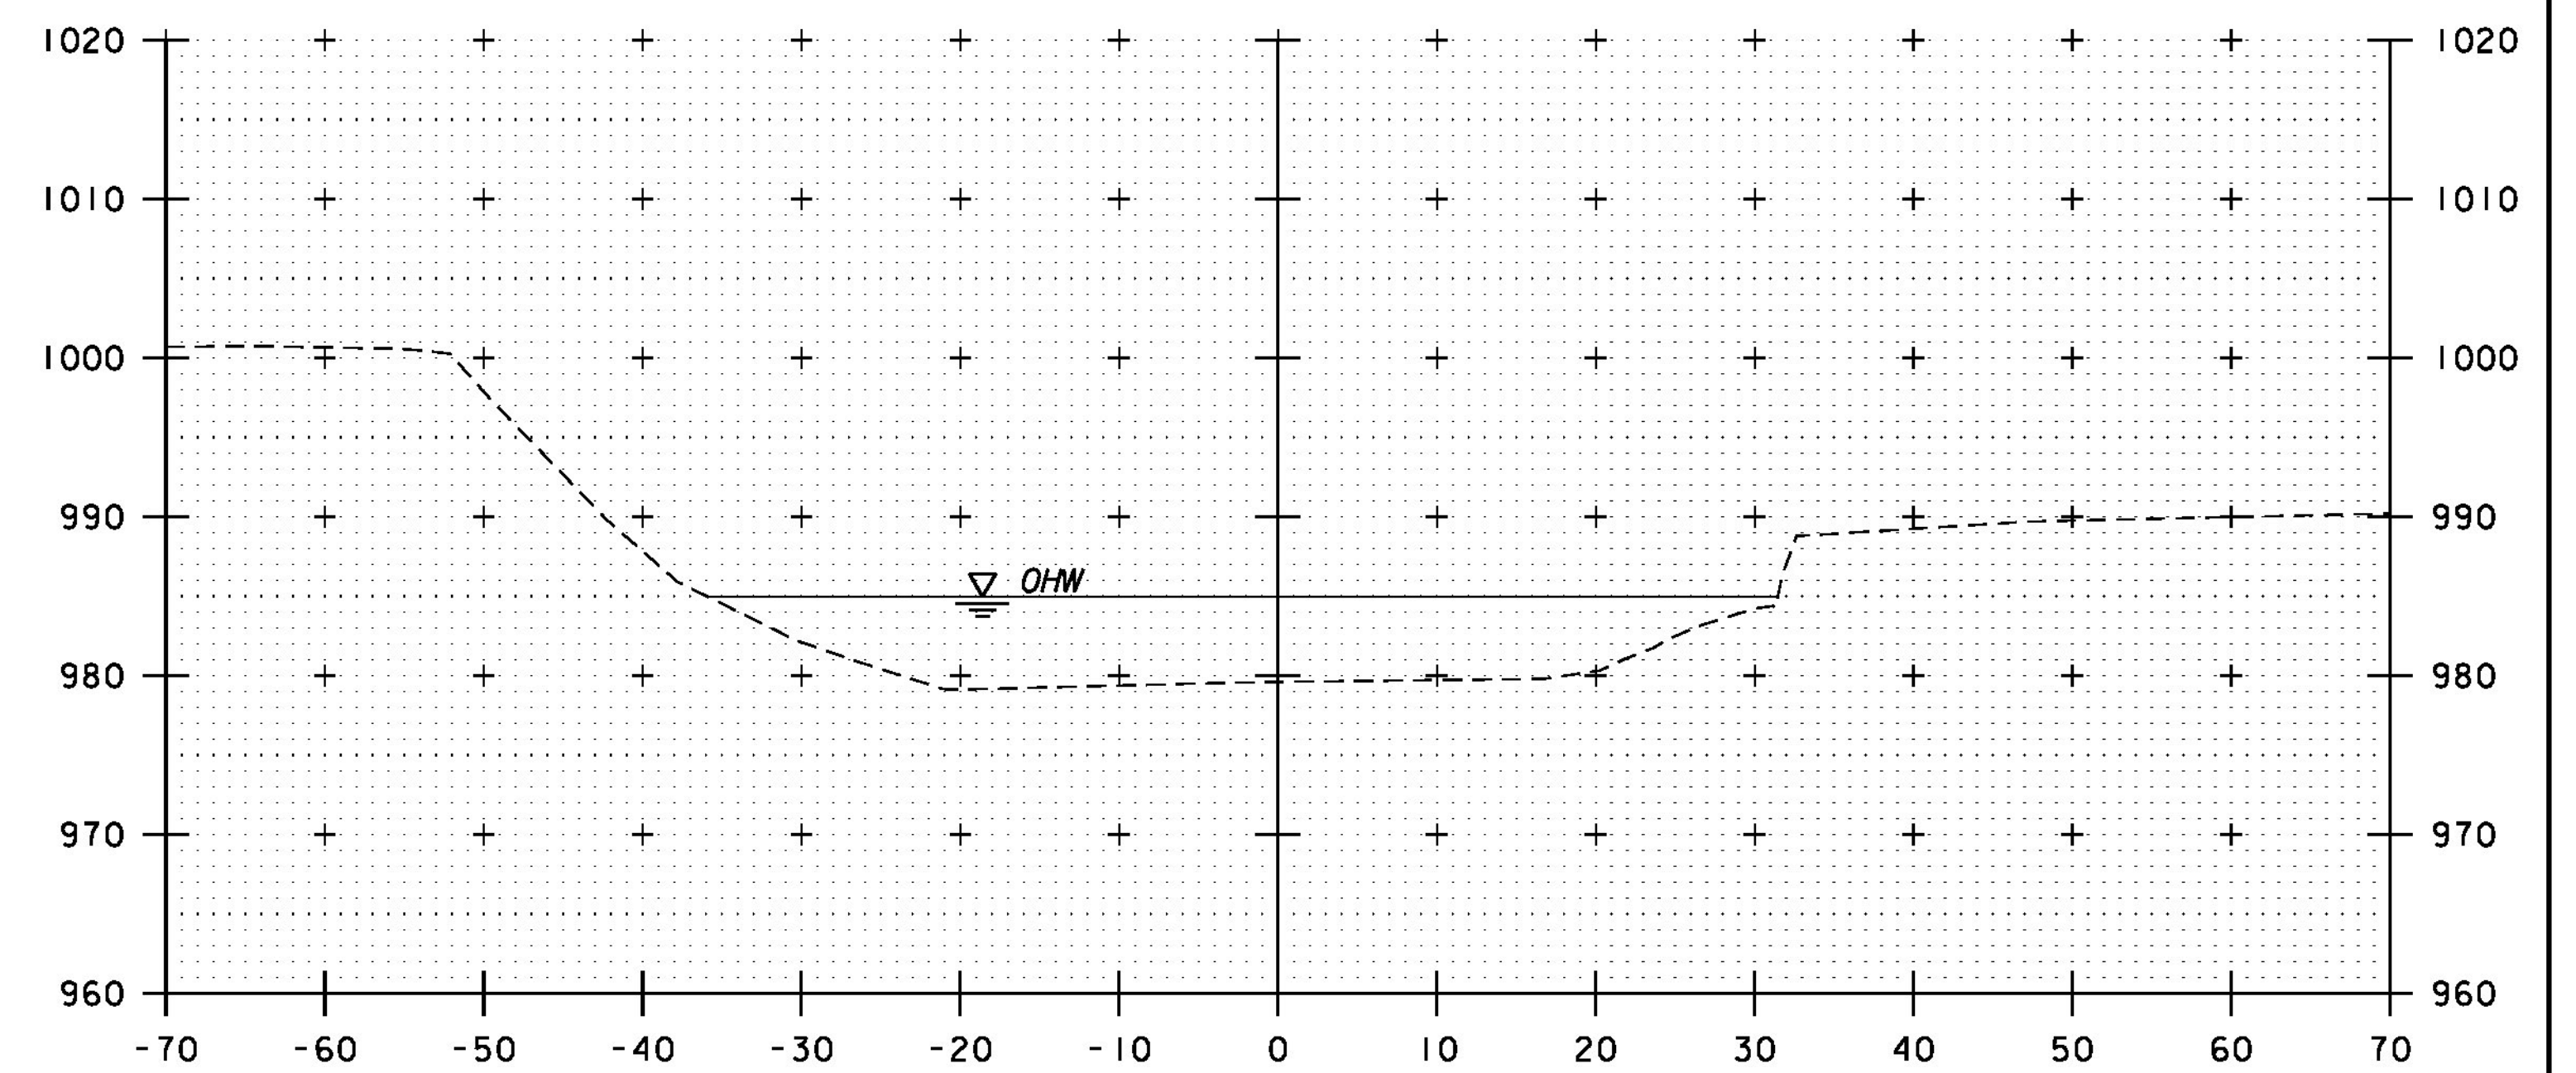

12+75

CHANNEL CROSS SECTIONS  
 STA. 12+25 TO 13+00

PROJECT NAME: LUDLOW  
 PROJECT NUMBER: BRF 025-(142)

FILE NAME: z10j068xsl.dgn  
 PROJECT LEADER: A.P. GUYETTE  
 DESIGNED BY: E.A. FIALA  
 CHANNEL CROSS SECTIONS (3 OF 3)

PLOT DATE: 8/23/2016  
 DRAWN BY: E.A. FIALA  
 CHECKED BY: A.P. GUYETTE  
 SHEET 61 OF 73

