


NOTE: SEE EROSION CONTROL DETAILS FOR SYMBOLOLOGY.



PROJECT NAME:	LUDLOW	PLOT DATE:	8/23/2016
PROJECT NUMBER:	BRF 025-(42)	DRAWN BY:	E.A. FIALA
FILE NAME:	z10j068bdr_ero.dgn	CHECKED BY:	A.P. GUYETTE
PROJECT LEADER:	A.P. GUYETTE	SHEET	65 OF 73
DESIGNED BY:	E.A. FIALA		
EPSC FINAL CONDITIONS SHEET			

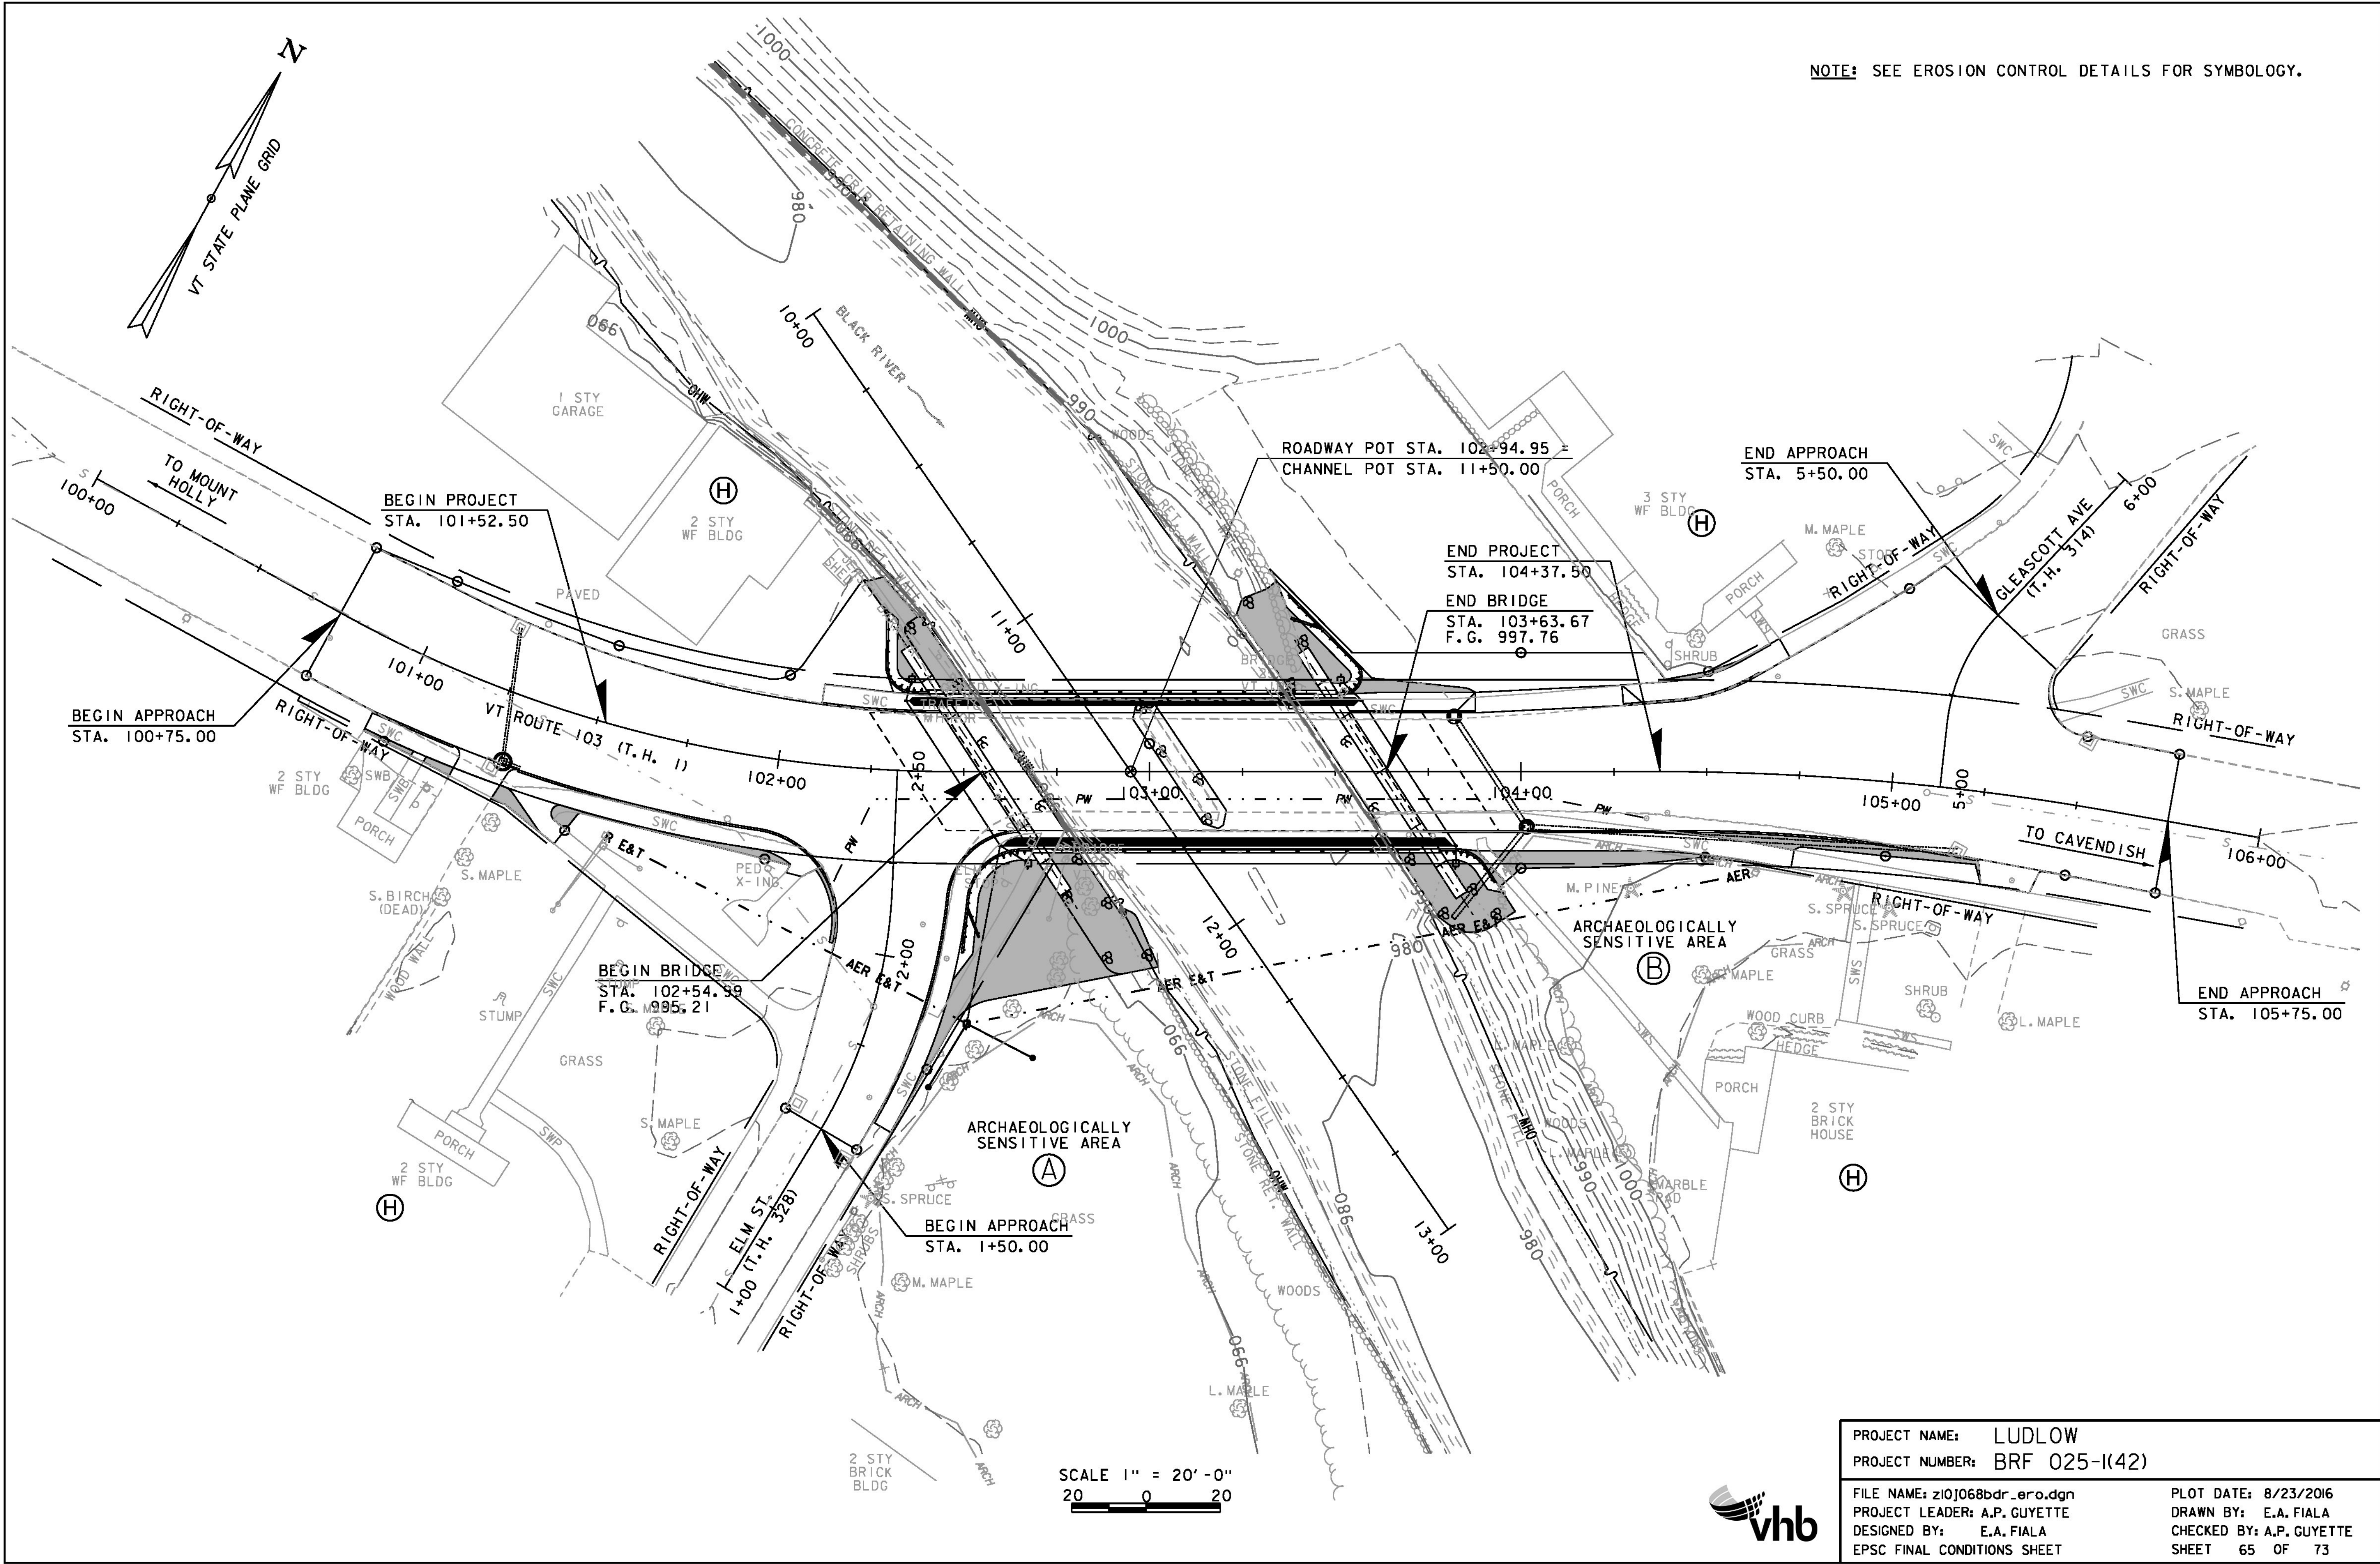