


ABUTMENT 1 PLAN

**NOTE: THREAD BAR WILL BE CAST INTO ABUTMENTS LONG AND CUT TO MAINTAIN 3" CLEARANCE

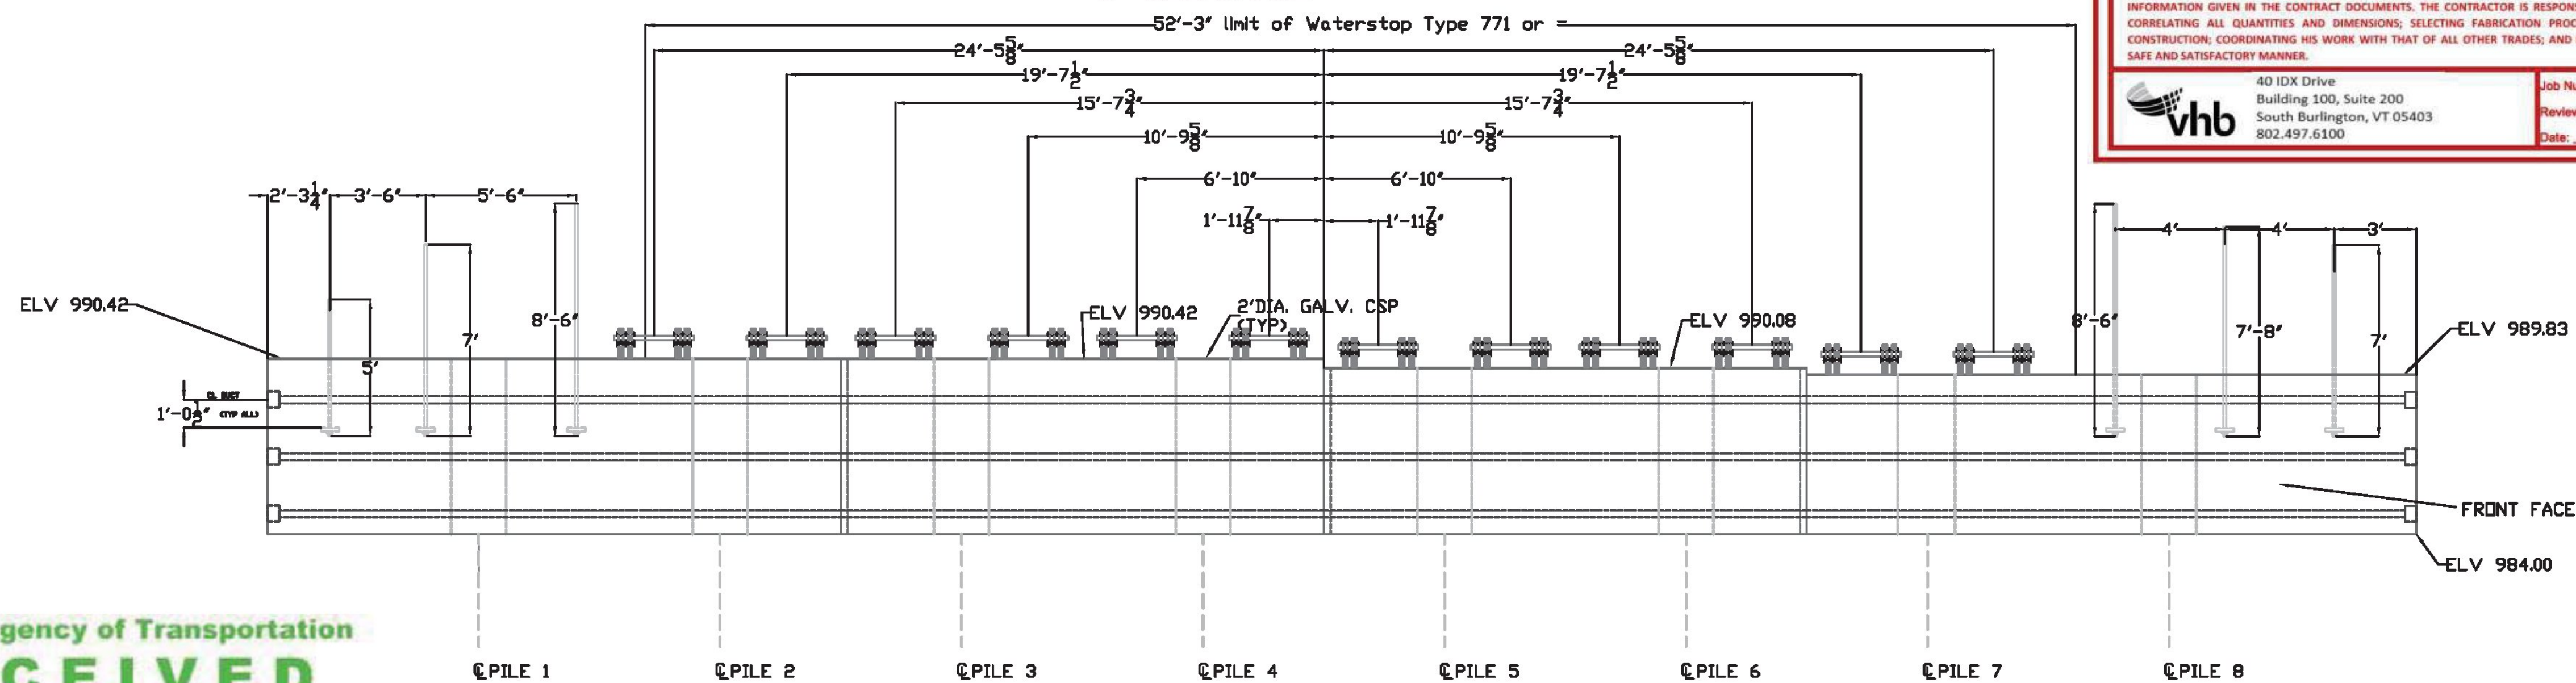

ABUTMENT 1 ELEVATION

SHOP DRAWING REVIEW	
<input type="checkbox"/> REVIEWED AS REQUIRED BY THE CONSTRUCTION CONTRACT DOCUMENTS AND APPROVED, BUT ONLY FOR CONFORMANCE TO THE DESIGN CONCEPT OF THE WORK, AND SUBJECT TO FURTHER LIMITATIONS AND REQUIREMENTS CONTAINED IN THE CONSTRUCTION CONTRACT DOCUMENTS.	<input checked="" type="checkbox"/> FURNISH AS CORRECTED
<input type="checkbox"/> REJECTED	<input type="checkbox"/> REVISE AND RESUBMIT
CORRECTIONS OR COMMENTS MADE ON THE SHOP DRAWINGS DURING THIS REVIEW DO NOT RELIEVE CONTRACTOR FROM COMPLIANCE WITH REQUIREMENTS OF THE DRAWINGS AND SPECIFICATIONS. THIS CHECK IS ONLY FOR REVIEW OF GENERAL CONFORMANCE WITH THE DESIGN CONCEPT OF THE PROJECT AND GENERAL COMPLIANCE WITH THE INFORMATION GIVEN IN THE CONTRACT DOCUMENTS. THE CONTRACTOR IS RESPONSIBLE FOR CONFIRMING AND CORRELATING ALL QUANTITIES AND DIMENSIONS, SELECTING FABRICATION PROCESSES AND TECHNIQUES OF CONSTRUCTION; COORDINATING HIS WORK WITH THAT OF ALL OTHER TRADES; AND PERFORMING HIS WORK IN A SAFE AND SATISFACTORY MANNER.	
vhb 40 IDX Drive Building 100, Suite 200 South Burlington, VT 05403 802.497.6100	Job Number: BRF 025-1(42) Reviewed By: E.F. LAWES Date: MARCH 9, 2017

Vermont Agency of Transportation
RECEIVED

CK'D BY VHB OK'D BY TAS

March 7, 2017

RESUBMIT NO APPROVED AS NOTED
BY T Sumner DATE 3/9/17

NOTE: LIFTERS HAVE BEEN LEFT OUT OF ELEV VIEW FOR CLARITY

COLD RIVER BRIDGES, LLC 10 LANBRO LANE WALPOLE, NH TEL 603-756-9300 FAX 603-756-9303	
LUDLOW BRF 0251(42)	
ABUTMENT #1 PLAN	SHEET NUMBER
DATE: 11/18/16	2