

**SHOP DRAWING REVIEW**

REVIEWED AS REQUIRED BY THE CONSTRUCTION CONTRACT DOCUMENTS AND APPROVED, BUT ONLY FOR CONFORMANCE TO THE DESIGN CONCEPT OF THE WORK, AND SUBJECT TO FURTHER LIMITATIONS AND REQUIREMENTS CONTAINED IN THE CONSTRUCTION CONTRACT DOCUMENTS.

REJECTED     REVISE AND RESUBMIT     FURNISH AS CORRECTED


CORRECTIONS OR COMMENTS MADE ON THE SHOP DRAWINGS DURING THIS REVIEW DO NOT RELIEVE CONTRACTOR FROM COMPLIANCE WITH REQUIREMENTS OF THE DRAWINGS AND SPECIFICATIONS. THIS CHECK IS ONLY FOR REVIEW OF GENERAL CONFORMANCE WITH THE DESIGN CONCEPT OF THE PROJECT AND GENERAL COMPLIANCE WITH THE INFORMATION GIVEN IN THE CONTRACT DOCUMENTS. THE CONTRACTOR IS RESPONSIBLE FOR: CONFIRMING AND CORRELATING ALL QUANTITIES AND DIMENSIONS; SELECTING FABRICATION PROCESSES AND TECHNIQUES OF CONSTRUCTION; COORDINATING HIS WORK WITH THAT OF ALL OTHER TRADES; AND PERFORMING HIS WORK IN A SAFE AND SATISFACTORY MANNER.

<p>40 IDX Drive Building 100, Suite 200 South Burlington, VT 05403 802.497.6100</p>	<p>Job Number: BRF 025-1(42) Reviewed By: E.F. LAWES Date: MARCH 9, 2017</p>
---	--

### ABUTMENT 2 PLAN

\*\*\*NOTE: THREAD BAR WILL BE CAST INTO ABUTMENTS LONG AND CUT TO MAINTAIN 3" CLEARANCE

15" CLEAR BETWEEN PILE CAVITY AND ANCHOR BOLTS AS SHOWN. VERIFIED IN FIELD 15" CLEARANCE. EXTRA CARE SHALL BE TAKEN TO ENSURE CONCRETE CONSOLIDATION AROUND ANCHOR BOLT

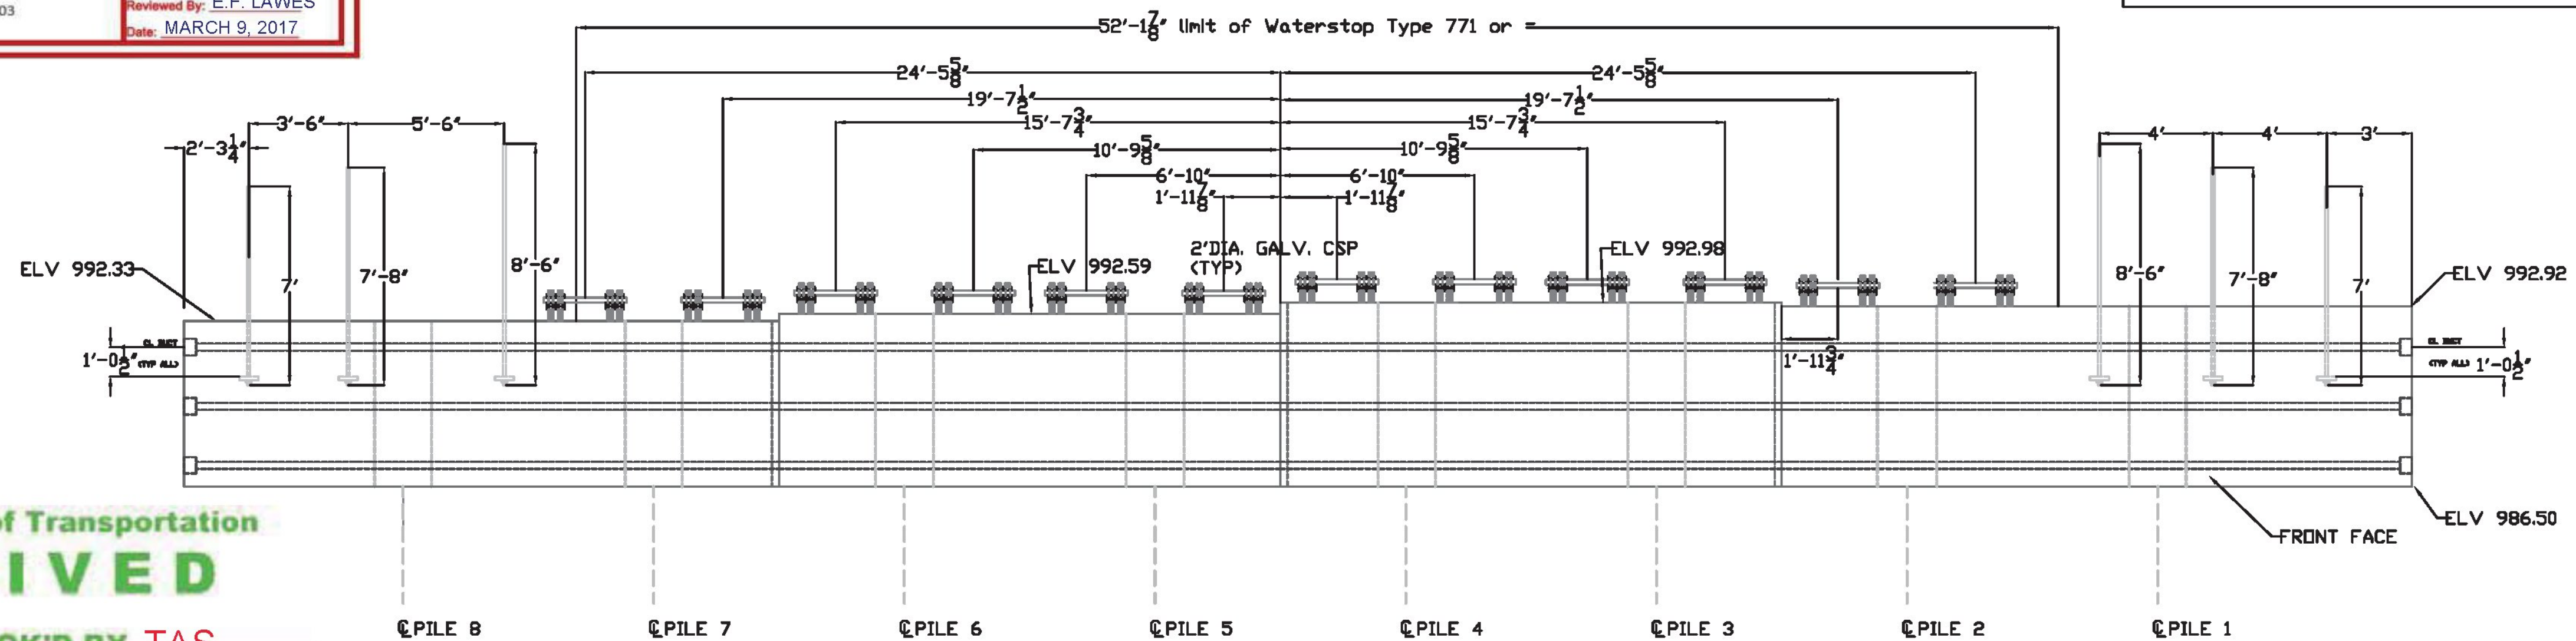

Vermont Agency of Transportation  
**RECEIVED**

CK'D BY VHB    OK'D BY TAS

March 7, 2017

RESUBMIT NO    APPROVED AS NOTED  
BY T Sumner    DATE 3/9/17

NOTE: LIFTERS HAVE BEEN LEFT OUT OF ELEV VIEW FOR CLARITY

### ABUTMENT 2 ELEVATION

COLD RIVER BRIDGES, LLC	
10 LANBRO LANE WALPOLE, NH	
TEL 603-756-9300	FAX 603-756-9303
LUDLOW BRF 0251(42)	
ABUTMENT #2 PLAN	SHEET NUMBER
DATE: 11/18/16	4