



WPS 8000
1/4" END OF RAIL DETAIL
(ENLARGED FOR CLARITY)

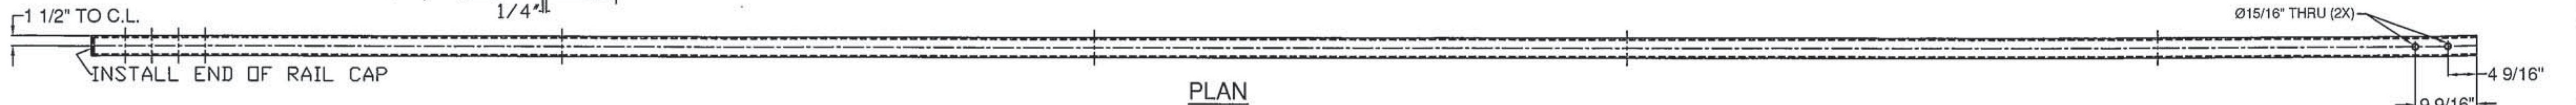


PLAN

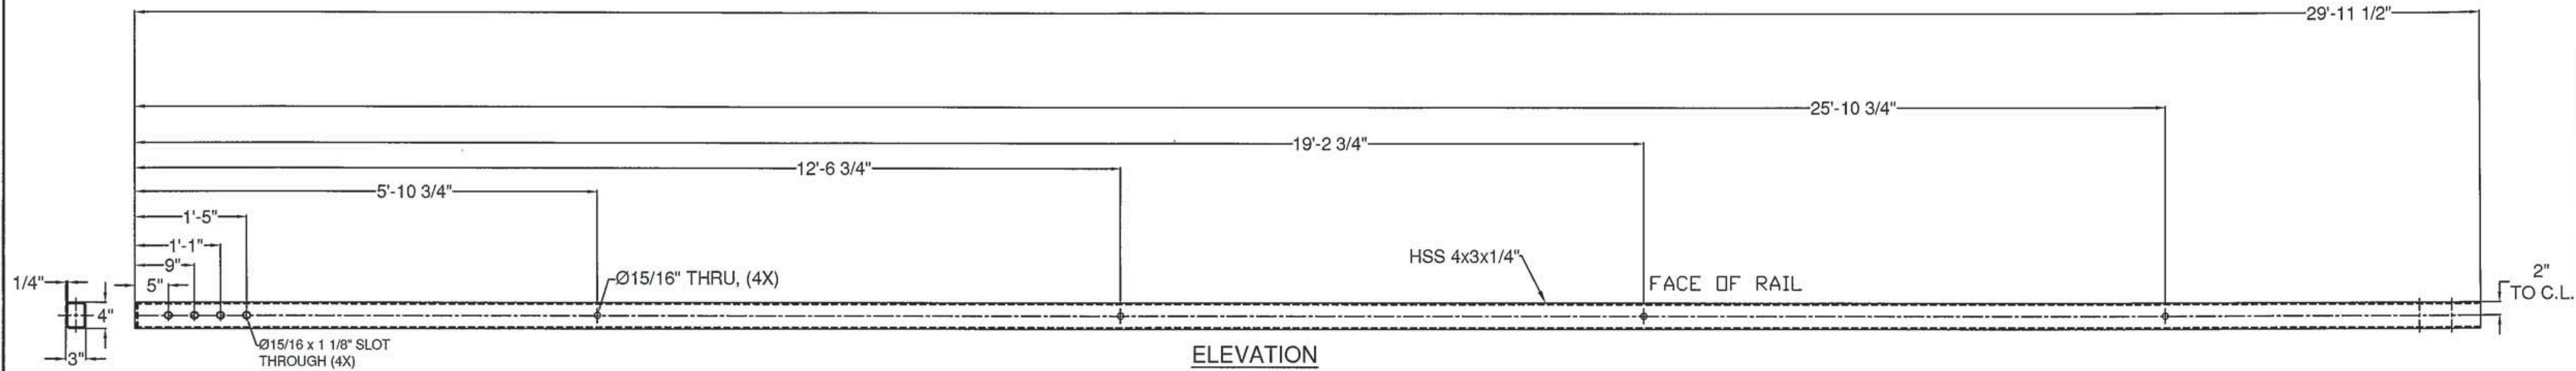


ELEVATION
(ITEM #4)

WPS 8000
1/4" END OF RAIL DETAIL
(ENLARGED FOR CLARITY)

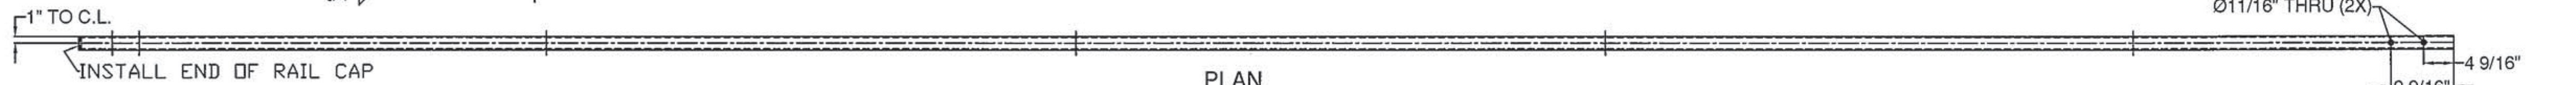

PLAN

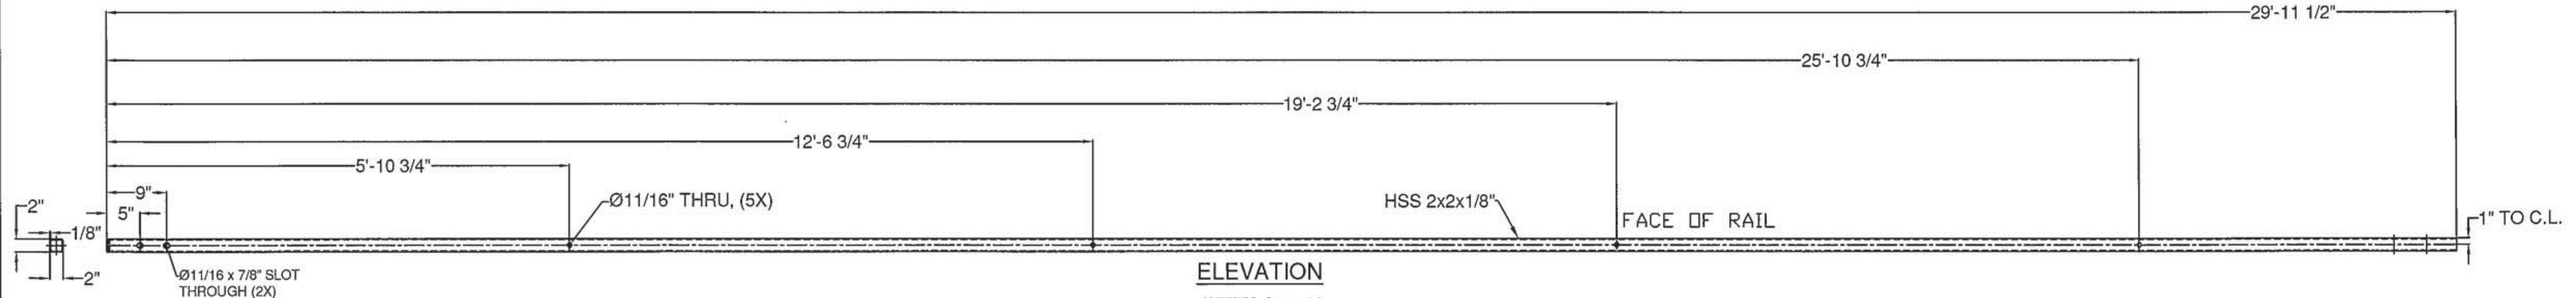

ELEVATION
(ITEM # 2)

Vermont Agency of Transportation

RECEIVED

CK'D BY VHB OK'D BY TAS

March 14, 2017

RESUBMIT APPROVED YES
BY T Sumner DATE 3/14/17

SHOP DRAWING REVIEW

REVIEWED AS REQUIRED BY THE CONSTRUCTION CONTRACT DOCUMENTS AND APPROVED, BUT ONLY FOR CONFORMANCE TO THE DESIGN CONCEPT OF THE WORK, AND SUBJECT TO FURTHER LIMITATIONS AND REQUIREMENTS CONTAINED IN THE CONSTRUCTION CONTRACT DOCUMENTS.
 REJECTED REVISE AND RESUBMIT FURNISH AS CORRECTED

CORRECTIONS OR COMMENTS MADE ON THE SHOP DRAWINGS DURING THIS REVIEW DO NOT RELIEVE CONTRACTOR FROM COMPLIANCE WITH REQUIREMENTS OF THE DRAWINGS AND SPECIFICATIONS. THIS CHECK IS ONLY FOR REVIEW OF GENERAL CONFORMANCE WITH THE DESIGN CONCEPT OF THE PROJECT AND GENERAL COMPLIANCE WITH THE INFORMATION GIVEN IN THE CONTRACT DOCUMENTS. THE CONTRACTOR IS RESPONSIBLE FOR: CONFIRMING AND CORRELATING ALL QUANTITIES AND DIMENSIONS; SELECTING FABRICATION PROCESSES AND TECHNIQUES OF CONSTRUCTION; COORDINATING HIS WORK WITH THAT OF ALL OTHER TRADES; AND PERFORMING HIS WORK IN A SAFE AND SATISFACTORY MANNER.

vhb
40 IDX Drive
Building 100, Suite 200
South Burlington, VT 05403
802.497.6100

Job Number: BRF.025-1(42)
Reviewed By: E.F. LAWES
Date: MARCH 14, 2017

ITEM #: 900.640

STRUCTURAL STEEL TO COMPLY W/ ASTM A6

TOLERANCE UNLESS OTHERWISE NOTED:
FRACTIONS = ± 1/16"
ANGLES = ± 1/2"
DIAMETERS = ± 1/32"

SHEET 4 OF 5

BRIDGE RAIL DETAILS SHEET

T.H. 1 (V.T. 103) CLASS I (PRINCIPAL ARTERIAL) F.A.S. 025-1, BRIDGE # 25
TOWN OF LUDLOW, WINDSOR COUNTY

R NO.	DATE	DESCRIPTION	BY	R NO.	DATE	DESCRIPTION	BY
E 1	1/9/17	REVISED PER 1/4/17 MARK-UP	D.K.				

ELDERLEE, INC. OAKS CORNERS, NEW YORK 14518 email: dlong@elderlee.com / epesk@elderlee.com Tel: 315-789-6670 Fax: 315-789-6615	CERTIFIED FABRICATOR ORTHOGONAL PROJECTION	DRAWN D.K. 12/12/16 CHECKED E.P. 12/12/16 APPROVED S.L. 12/12/16 SCALE SCHEMATIC DRAWING NO. FR LAFAYETTE - LUDLOW
--	--	--