


ELEVATION  
(ITEM #5)

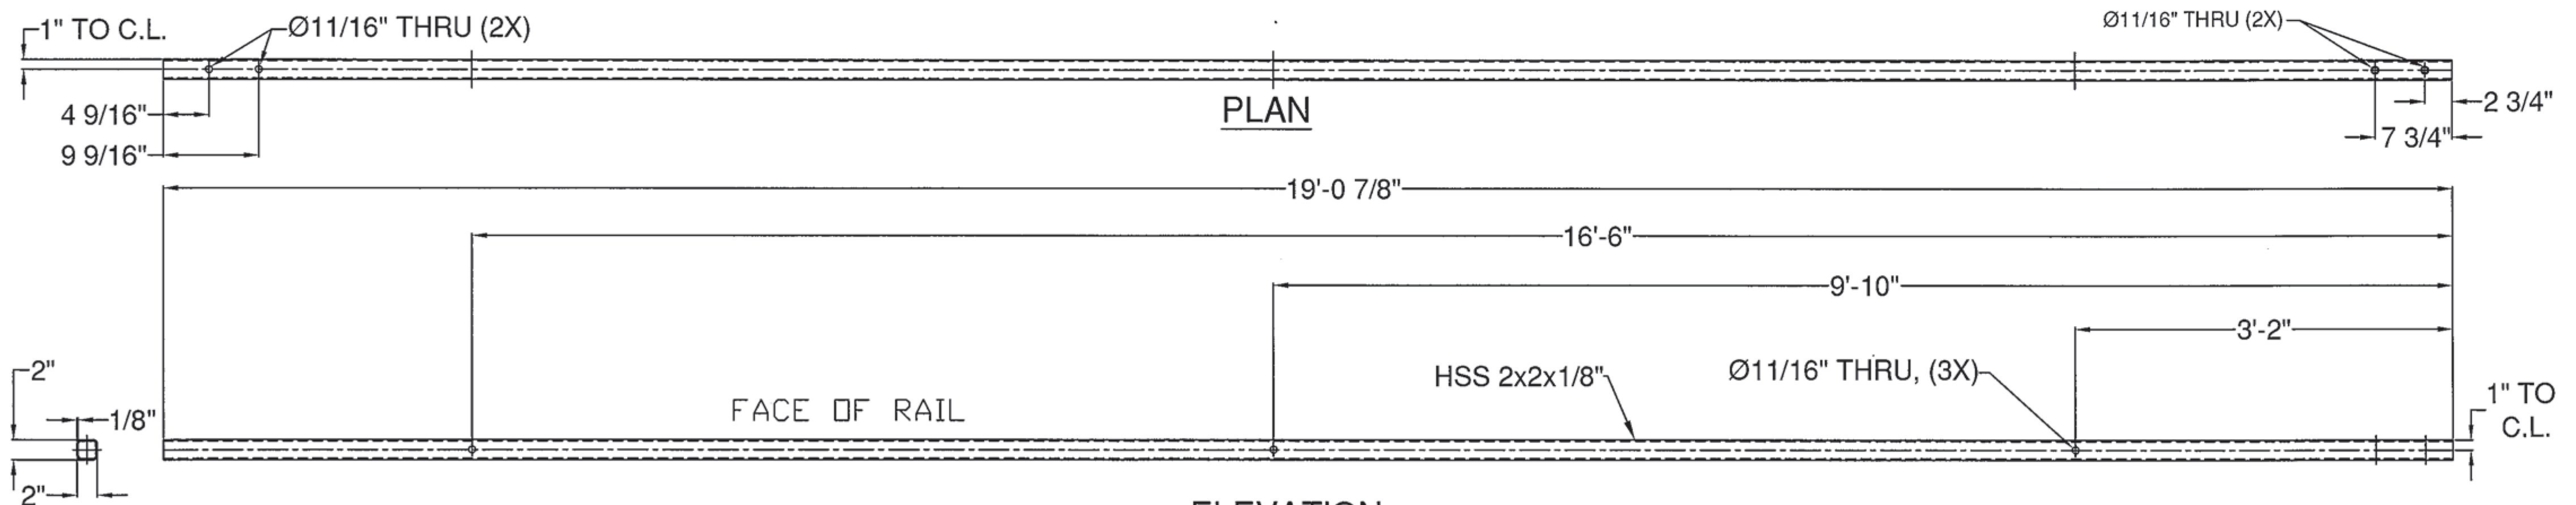

ELEVATION  
(ITEM #3)

Vermont Agency of Transportation  
**RECEIVED**

CK'D BY VHB OK'D BY TAS

March 14, 2017

RESUBMIT            APPROVED YES  
BY T Sumner DATE 3/14/17

SHOP DRAWING REVIEW	
<input checked="" type="checkbox"/>	REVIEWED AS REQUIRED BY THE CONSTRUCTION CONTRACT DOCUMENTS AND APPROVED, BUT ONLY FOR CONFORMANCE TO THE DESIGN CONCEPT OF THE WORK, AND SUBJECT TO FURTHER LIMITATIONS AND REQUIREMENTS CONTAINED IN THE CONSTRUCTION CONTRACT DOCUMENTS.
<input type="checkbox"/>	REJECTED
<input type="checkbox"/>	REVISE AND RESUBMIT
<input type="checkbox"/>	FURNISH AS CORRECTED
CORRECTIONS OR COMMENTS MADE ON THE SHOP DRAWINGS DURING THIS REVIEW DO NOT RELIEVE CONTRACTOR FROM COMPLIANCE WITH REQUIREMENTS OF THE DRAWINGS AND SPECIFICATIONS. THIS CHECK IS ONLY FOR REVIEW OF GENERAL CONFORMANCE WITH THE DESIGN CONCEPT OF THE PROJECT AND GENERAL COMPLIANCE WITH THE INFORMATION GIVEN IN THE CONTRACT DOCUMENTS. THE CONTRACTOR IS RESPONSIBLE FOR: CONFIRMING AND CORRELATING ALL QUANTITIES AND DIMENSIONS; SELECTING FABRICATION PROCESSES AND TECHNIQUES OF CONSTRUCTION; COORDINATING HIS WORK WITH THAT OF ALL OTHER TRADES; AND PERFORMING HIS WORK IN A SAFE AND SATISFACTORY MANNER.	
40 IDX Drive Building 100, Suite 200 South Burlington, VT 05403 802.497.6100	Job Number: BRE 025-1(42) Reviewed By: E.F. LAWES Date: MARCH 14, 2017

ITEM #: 900.640

STRUCTURAL STEEL TO  
COMPLY W/ ASTM A6

TOLERANCE UNLESS  
OTHERWISE NOTED:  
FRACTIONS = ± 1/16"  
ANGLES = ± 1/2°  
DIAMETERS = ± 1/32"

SHEET 5 OF 5

**BRIDGE RAIL DETAILS SHEET**

T.H. 1 (V.T. 103) CLASS I (PRINCIPAL ARTERIAL) F.A.S. 025-1, BRIDGE # 25  
TOWN OF LUDLOW, WINDSOR COUNTY

R NO.	DATE	DESCRIPTION	BY	R NO.	DATE	DESCRIPTION	BY
E 1	1/9/17	REVISED PER 1/4/17 MARK-UP	D.K. E				
V			V				

	CERTIFIED FABRICATOR	DRAWN	D.K.	12/12/16
	CERTIFIED FABRICATOR	CHECKED	E.P.	12/12/16
	CERTIFIED FABRICATOR	APPROVED	D.L.	12/12/16
	CERTIFIED FABRICATOR	SCALE	SCHMATIC	
	CERTIFIED FABRICATOR	DRAWING NO.	FR LAFAYETTE - LUDLOW	

ELDERLEE, INC.  
OAKS CORNERS, NEW YORK 14518  
email: dlong@elderlee.com / epeek@elderlee.com  
Tel: 315-789-6670 Fax: 315-789-6615