



STATE OF VERMONT AGENCY OF TRANSPORTATION

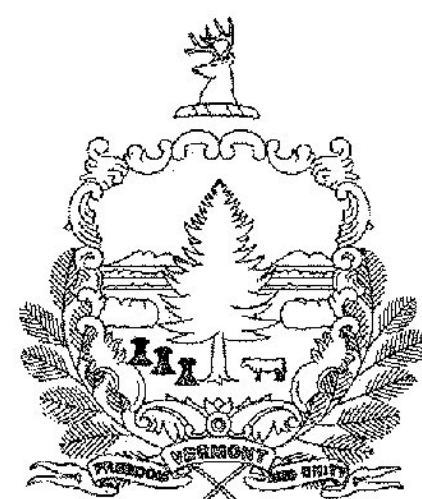

PROPOSED IMPROVEMENT BRIDGE PROJECT TOWN OF ROCKINGHAM COUNTY OF WINDHAM

VT 121 (CL 2, TH 1) RURAL MAJOR COLLECTOR BRIDGE NO. 11R




THIS IS A VALUE ENGINEERED PLAN SET. THESE PLANS HAVE BEEN DEVELOPED USING PORTIONS OF THE ORIGINAL VTRANS CONTRACT PLANS FOR BRIDGE NO. 11R, ROCKINGHAM AND MODIFICATIONS MADE BY CALDERWOOD ENGINEERING. IN ORDER TO PROVIDE A COMPLETE SET PACKAGE FOR RECORD KEEPING PURPOSES AND FOR CONSTRUCT, VTRANS HAS PROVIDED THE ORIGINAL PLAN SET SO THEY COULD BE INCORPORATED WITH THE VALUE ENGINEERED PLANS. REPORT ANY DISCREPANCY BETWEEN THESE PLANS AND THE ACTUAL OBSERVED FIELD CONDITIONS TO THE VALUE ENGINEER OF RECORD IMMEDIATELY. DO NOT PROCEED WITH ANY DEPENDENT WORK UNTIL SUCH REPORTED DISCREPANCY HAS BEEN RESOLVED TO THE SATISFACTION OF THE VALUE ENGINEER OR RECORD.

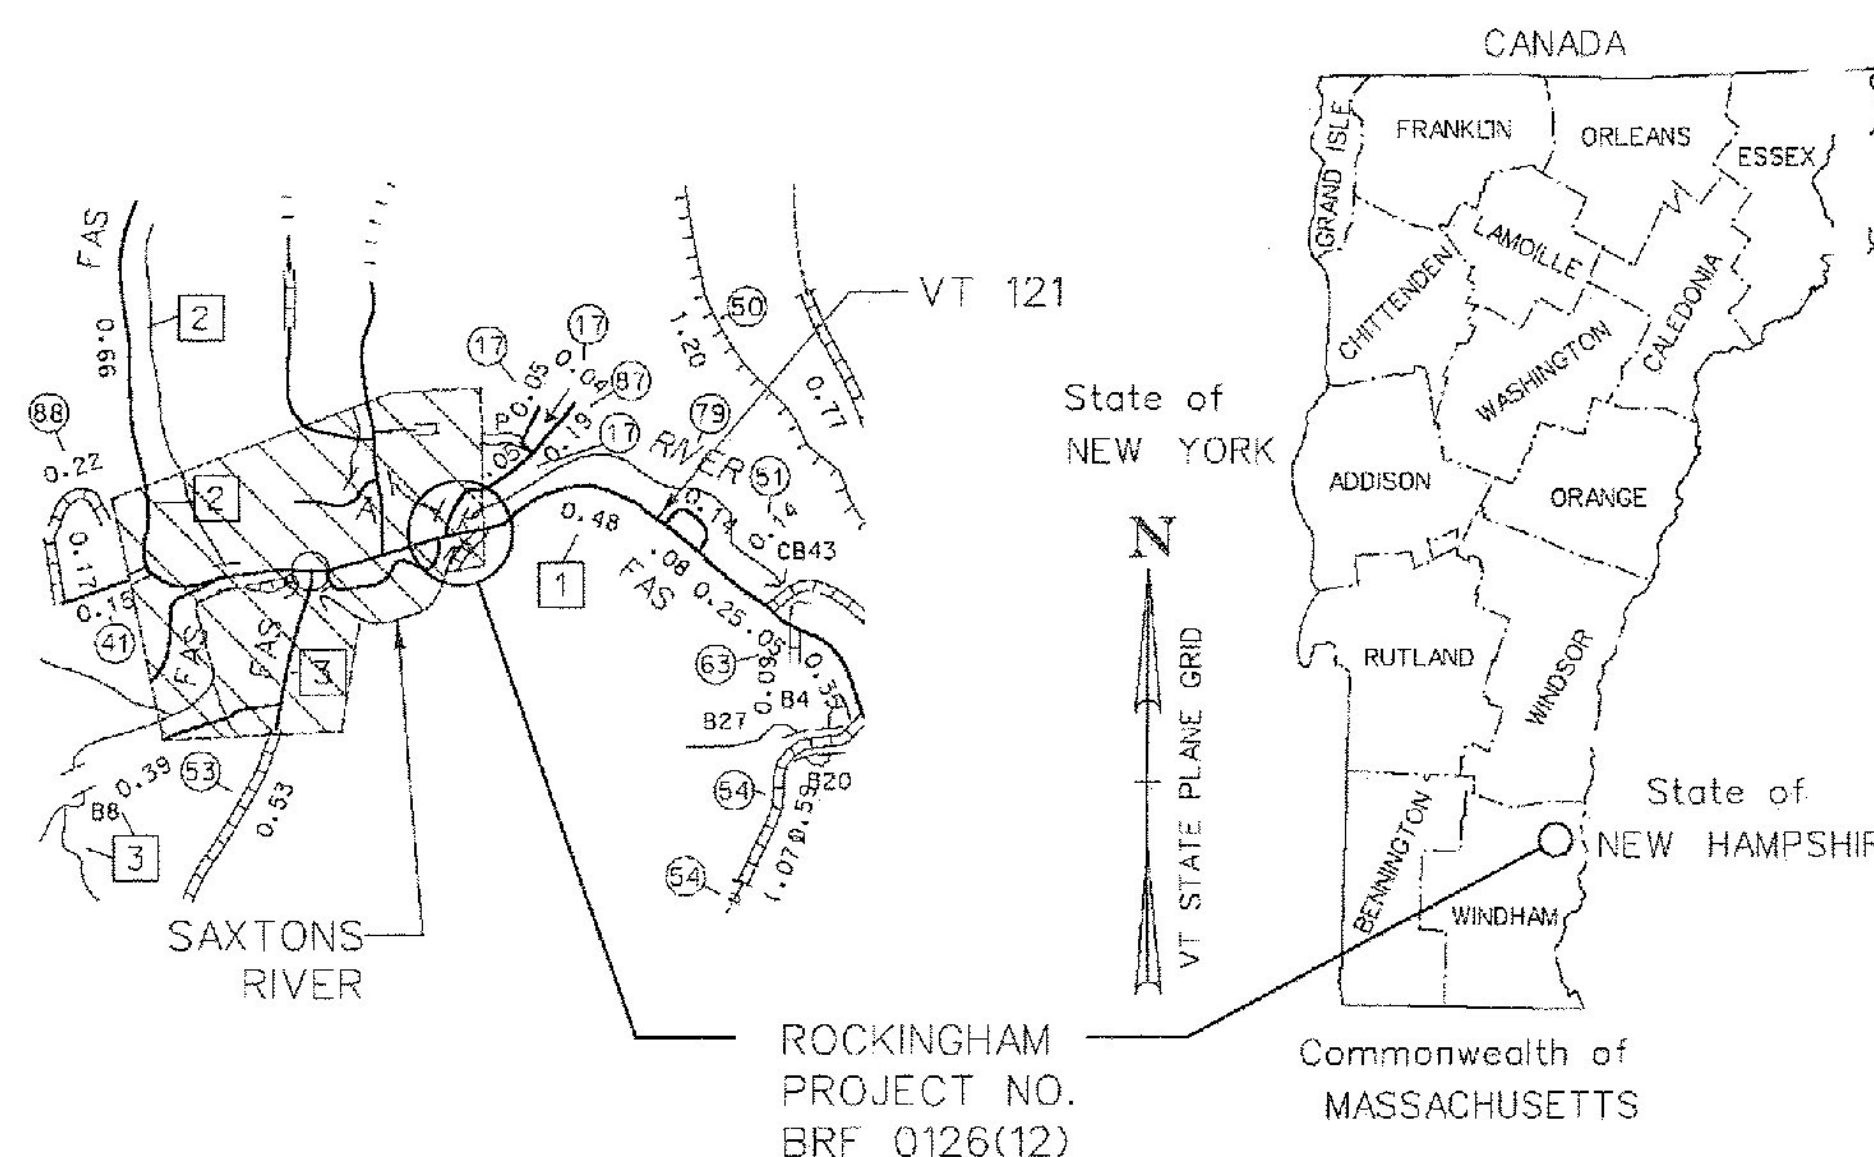

PROJECT LOCATION: BEGINNING ON VT 121 (CL2, TH 1) (FAS ROUTE S0126) APPROXIMATELY 4.1 MILES WEST OF THE JUNCTION WITH U.S. ROUTE 5 AND 68.0 FEET EAST OF THE JUNCTION WITH OAK STREET AND EXTENDING EASTERLY ALONG VT 121 APPROXIMATELY 243 FEET (0.04 MILES).

PROJECT DESCRIPTION: WORK TO BE PERFORMED UNDER THIS PROJECT INCLUDES REPLACEMENT OF BRIDGE NO. 11R SUPERSTRUCTURE WITH NEW SUPERSTRUCTURE ON EXISTING ALIGNMENT, PARTIAL REMOVAL OF EXISTING ABUTMENTS AND REPLACEMENT WITH NEW ABUTMENTS, REPAIR OF EXISTING PIERS AND CHANNEL WORK WITH OTHER RELATED HIGHWAY ITEMS.

STRUCTURE LENGTH: 202.69 FEET
ROADWAY LENGTH: 40.00 FEET
PROJECT LENGTH: 242.69 FEET

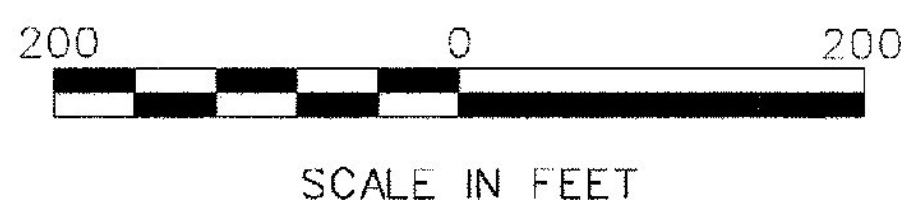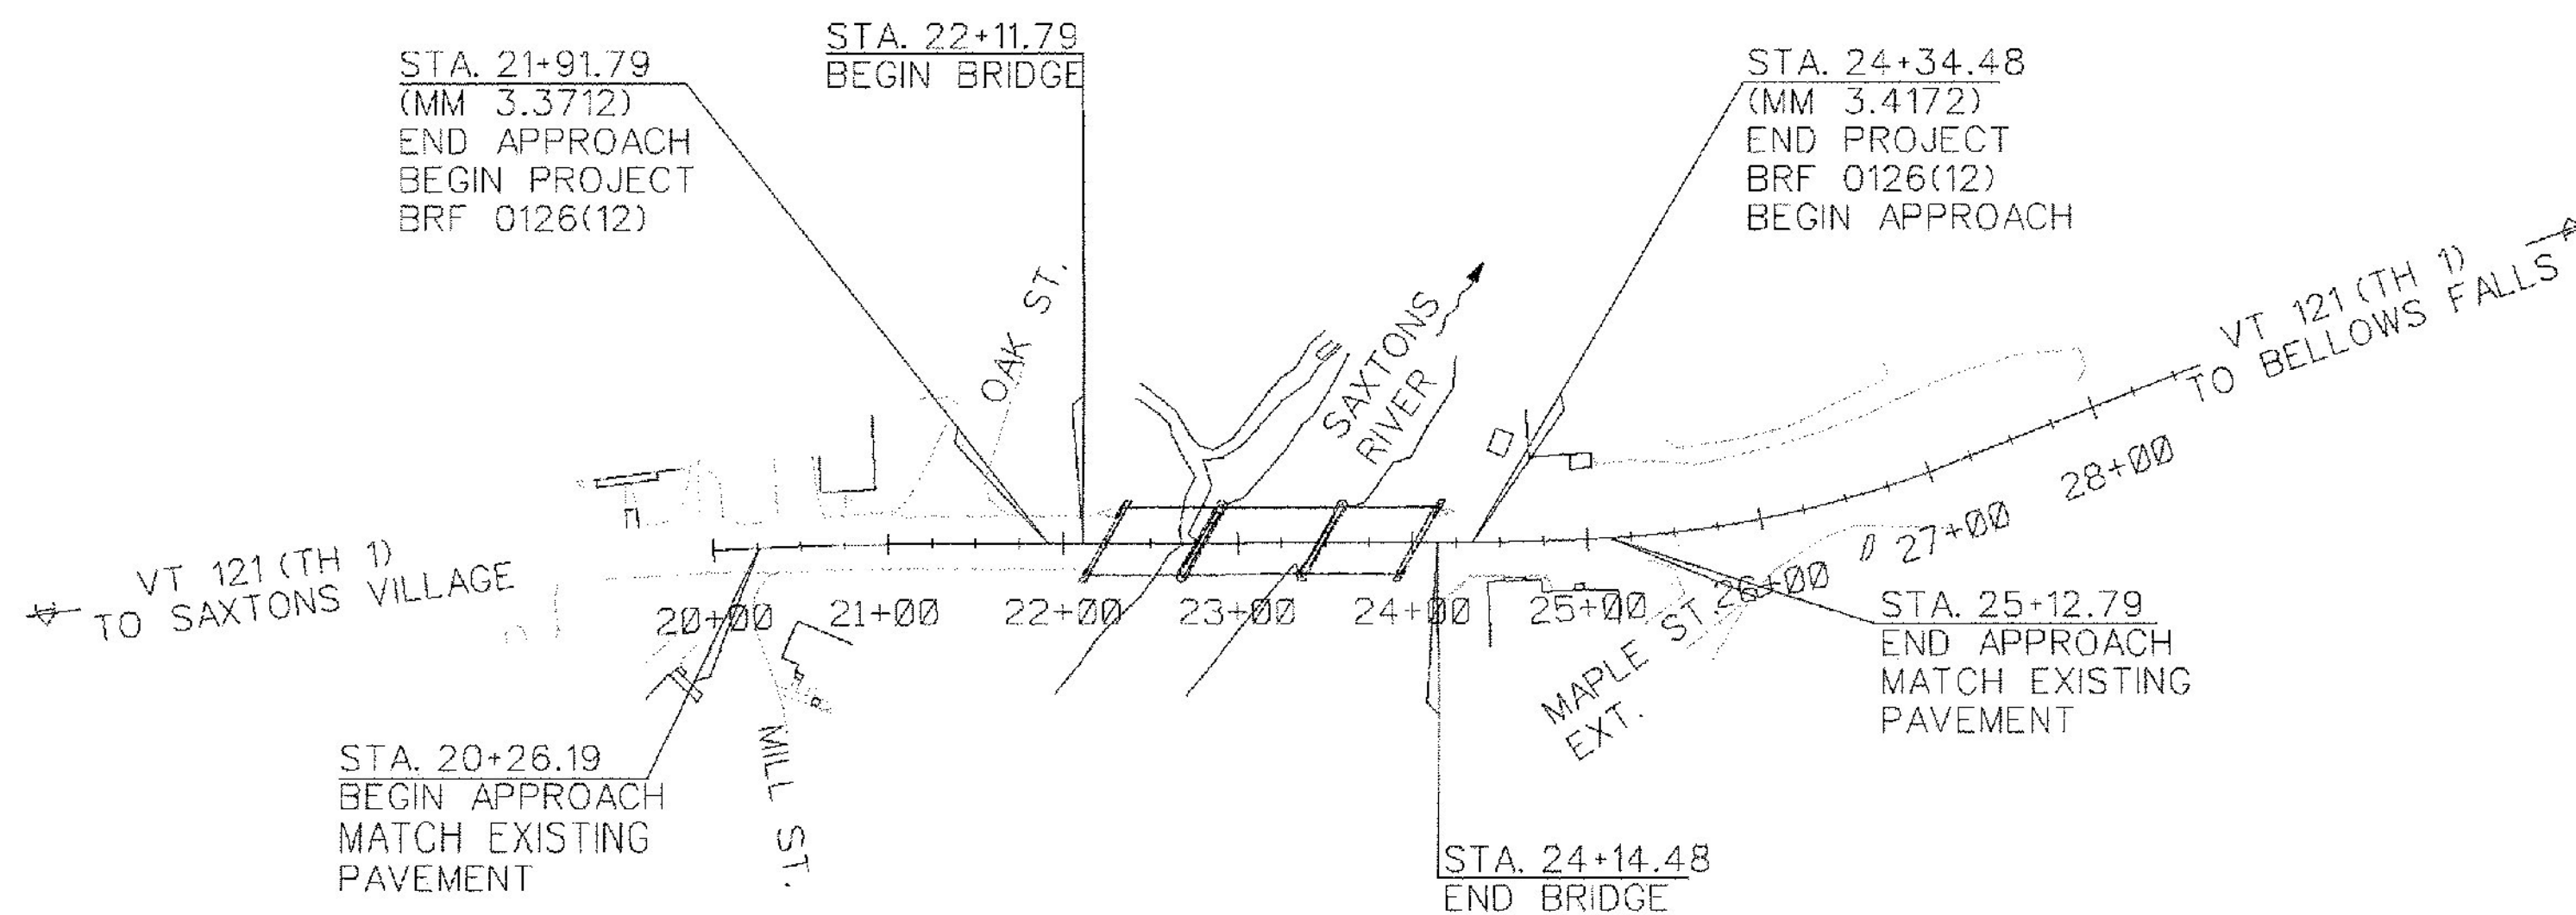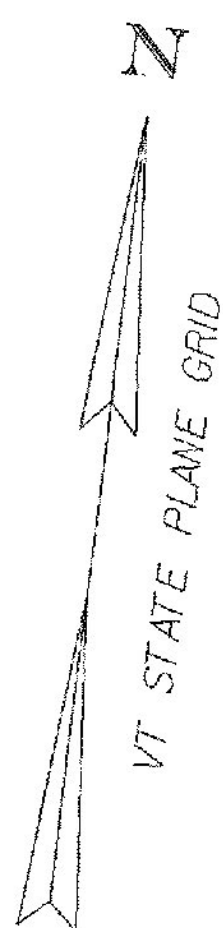

RECORD PLANS	
CONTRACTOR:	COLD RIVER BRIDGES, LLC - KEENE, NH
RESIDENT ENGINEER:	CHAD GREENWOOD
CONSTRUCTION BEGAN:	OCTOBER 29, 2014
CONSTRUCTION COMPLETE:	NOVEMBER 3, 2015
RECORD PLANS BY:	CHAD GREENWOOD & KEVIN KING
I HEREBY CERTIFY THAT ALL THE CONSTRUCTION REQUIRED BY THIS SET OF DRAWINGS HAS BEEN ACCOMPLISHED AS INDICATED HEREIN.	
BY:	<i>Chad Greenwood</i> RESIDENT ENGINEER
DATE:	3/9/17
NOTE: Any further information concerning final quantities, amounts or other details relative to this project may be found at Central Files in the electronic archives.	

CONSTRUCTION IS TO BE CARRIED ON IN ACCORDANCE WITH THESE PLANS AND THE STANDARD SPECIFICATIONS FOR CONSTRUCTION DATED 2011, AS APPROVED BY THE FEDERAL HIGHWAY ADMINISTRATION ON JULY 20, 2011 FOR USE ON THIS PROJECT, INCLUDING ALL SUBSEQUENT REVISIONS AND SUCH REVISED SPECIFICATIONS AND SPECIAL PROVISIONS AS ARE INCORPORATED IN THESE PLANS.

QUALITY ASSURANCE PROGRAM : LEVEL 2	
SURVEYED BY : VERMONT SURVEY & ENGINEERING, INC.	
SURVEYED DATE : 12/2010	
DATUM	
VERTICAL	NAVD 88(GEOID09)FT
HORIZONTAL	NAD 83 (CORS) sFT

CALDERWOOD ENGINEERING, ETC.
 STRUCTURAL ENGINEERING • DETAILING SERVICES
 222 RIVER RD, RICHMOND, ME 04357 PH/FX (207)737-2007/(207) 737-2008
 PREPARED FOR:
COLD RIVER BRIDGES, LLC
 CEE 106-BR-14

DATE	BY	DESIGN-DETAILED	CHECKED-REVIEWED	REVISIONS 1	REVISIONS 2	REVISIONS 3	REVISIONS 4	FIELD CHANGES
2014	E/C							

VE SUPER. DESIGN
 ROCKINGHAM VT. BRF 0126 (12)
 TITLE SHEET

SHEET NUMBER
 1

