


DETAIL A
SCALE 3/4" = 1'-0"

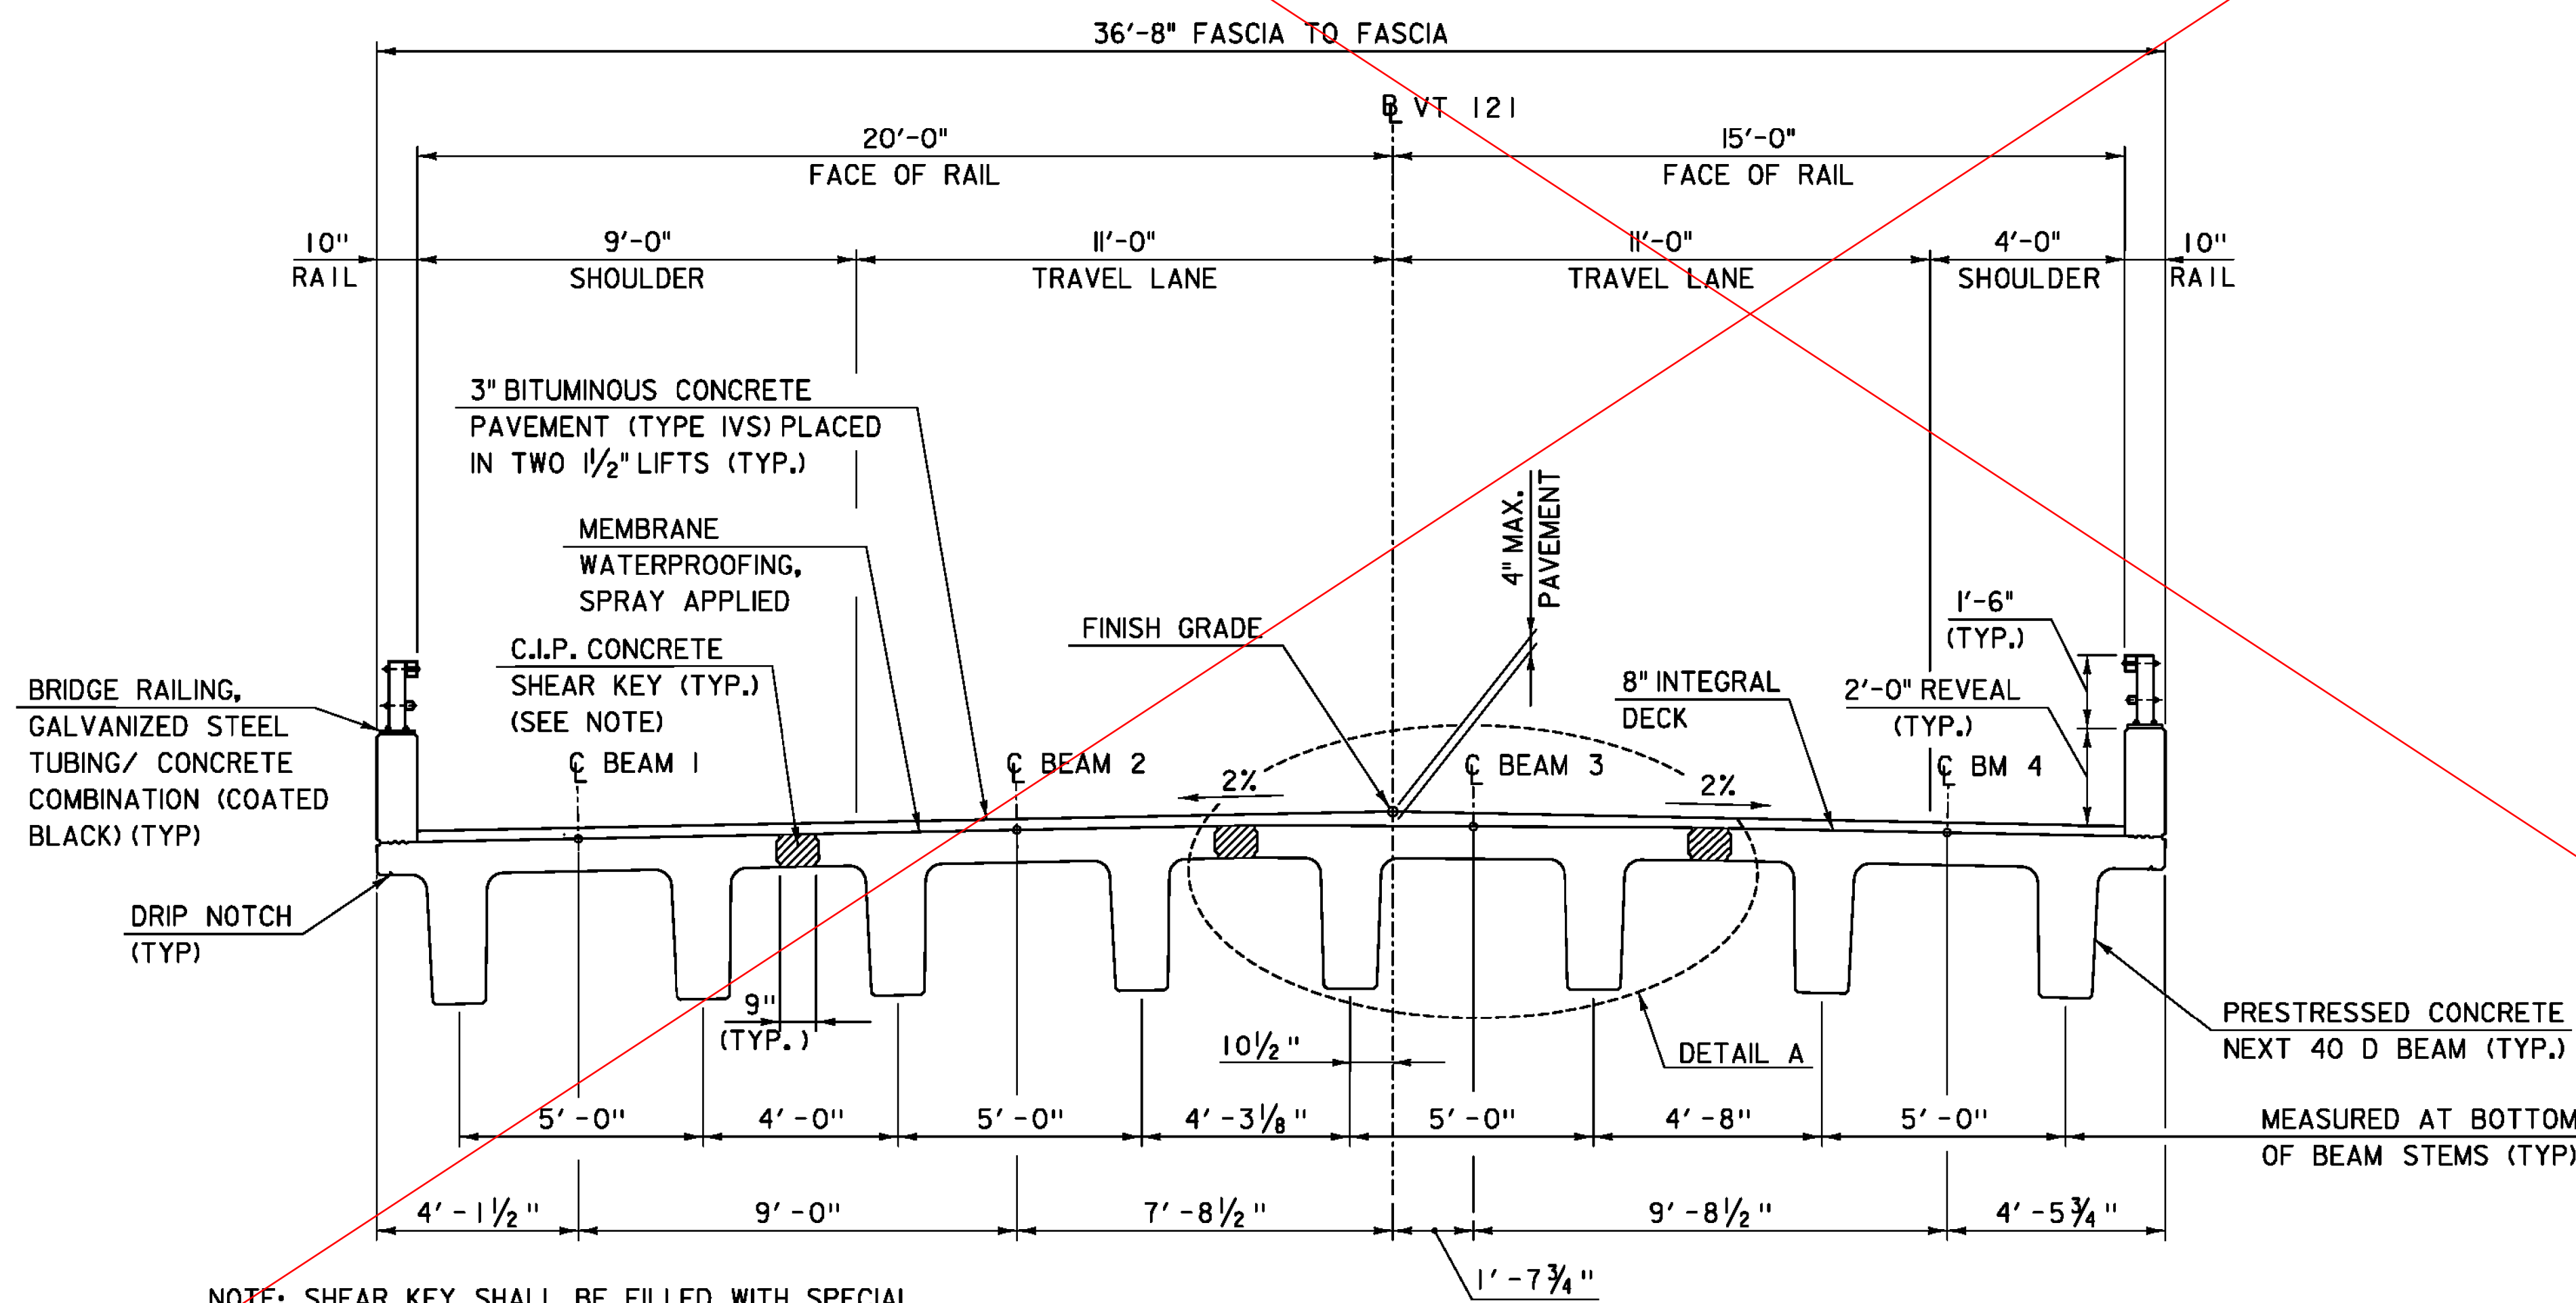

NOTE: SHEAR KEY SHALL BE FILLED WITH SPECIAL PROVISION (HIGH PERFORMANCE CONCRETE, RAPID SET)

BRIDGE TYPICAL SECTION

SCALE 3/8" = 1'-0"

TYLIN INTERNATIONAL	PROJECT NAME: ROCKINGHAM	PLOT DATE: 8/26/2014
	PROJECT NUMBER: BRF 0126(12)	DRAWN BY: D. AXTELL
	FILE NAME: z10J072bdr_btyp.dgn	DESIGNED BY: S. KELLER
	BRIDGE TYPICAL SECTION	SHEET 4 OF 69

SEE SHEET 4 VE