


BRIDGE FASCIA

INTERIOR

NEXT D BEAM REINFORCEMENT SECTION

(SECTION IS SHOWN NORMAL TO BEAM, BUT REINFORCEMENT IS PARALLEL TO CL BRG.)
 (BEAM I SPAN 2 SHOWN, END SPANS AND OTHER BEAMS SIMILAR)
 SCALE: 1/2" = 1'-0"

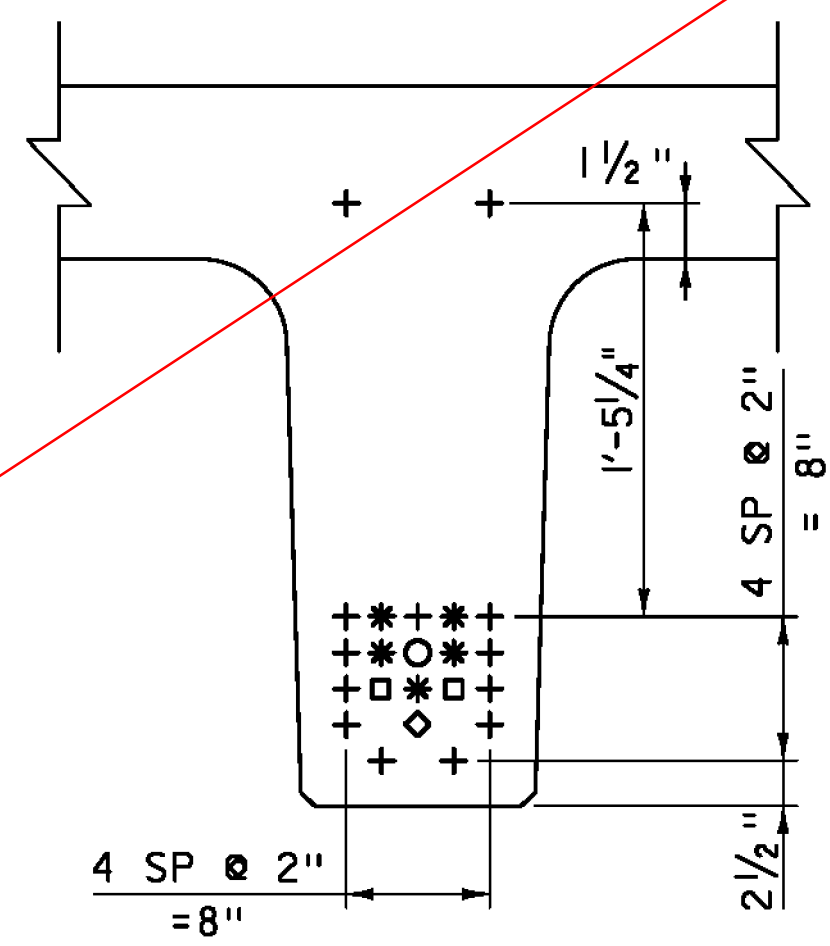


TYPICAL NEXT BEAM STRAND PATTERN

N. T. S.


PRESTRESSING LEGEND:

- × FULLY BONDED. EXTENDED 2'-0" BEYOND END OF BEAM AT ABUTMENT ENDS ONLY. (BEND UP 90° @ 1'-1 3/4" BEYOND END OF BEAM)
- + FULLY BONDED
- * DEBONDED 0.5 FEET
- DEBONDED 6 FEET
- DEBONDED 8 FEET
- ◇ DEBONDED 10 FEET

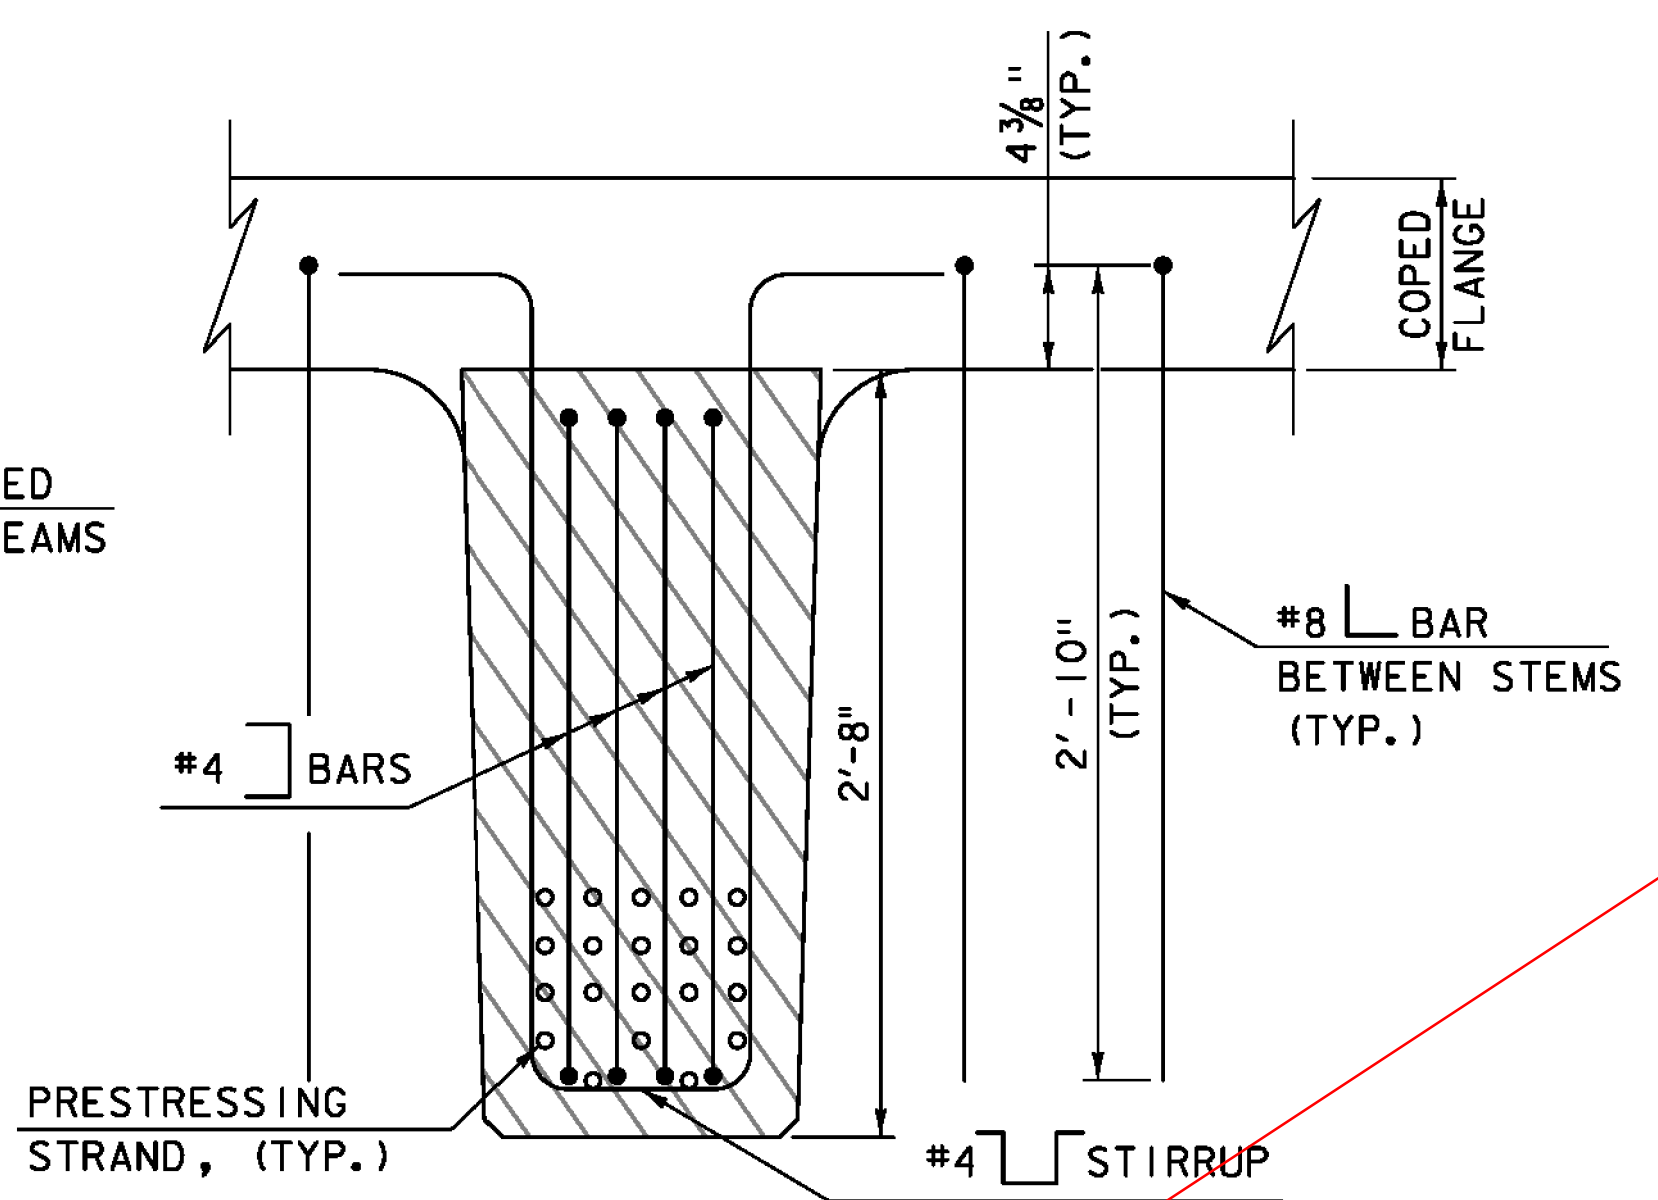


TYPICAL STEM REINF. @ ABUTMENT END

SCALE: 1/2" = 1'-0"

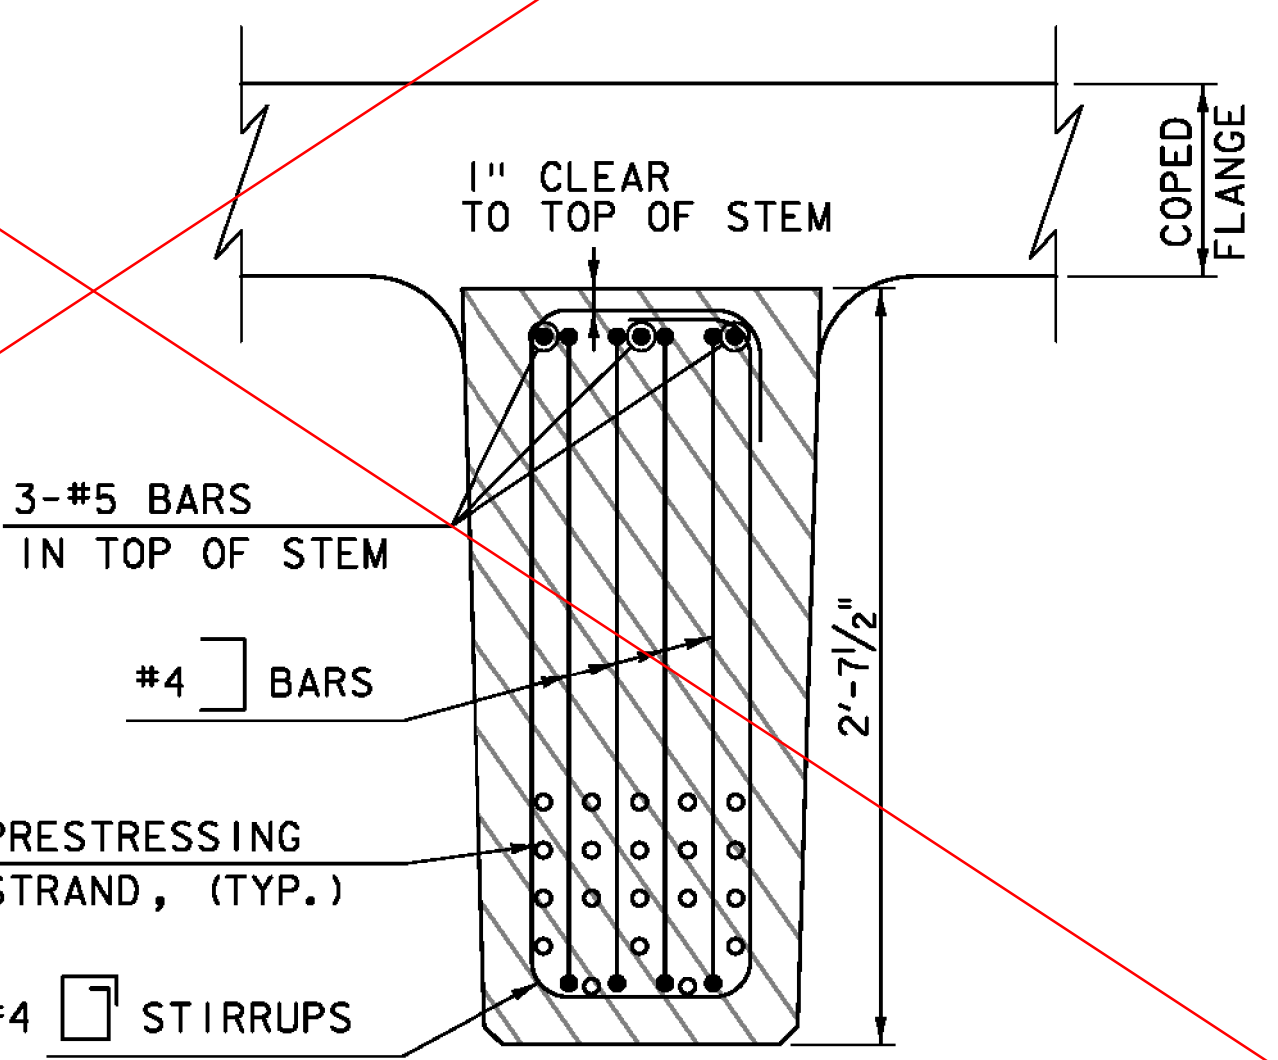


TYPICAL STEM REINF. @ PIER END

SCALE: 1/2" = 1'-0"

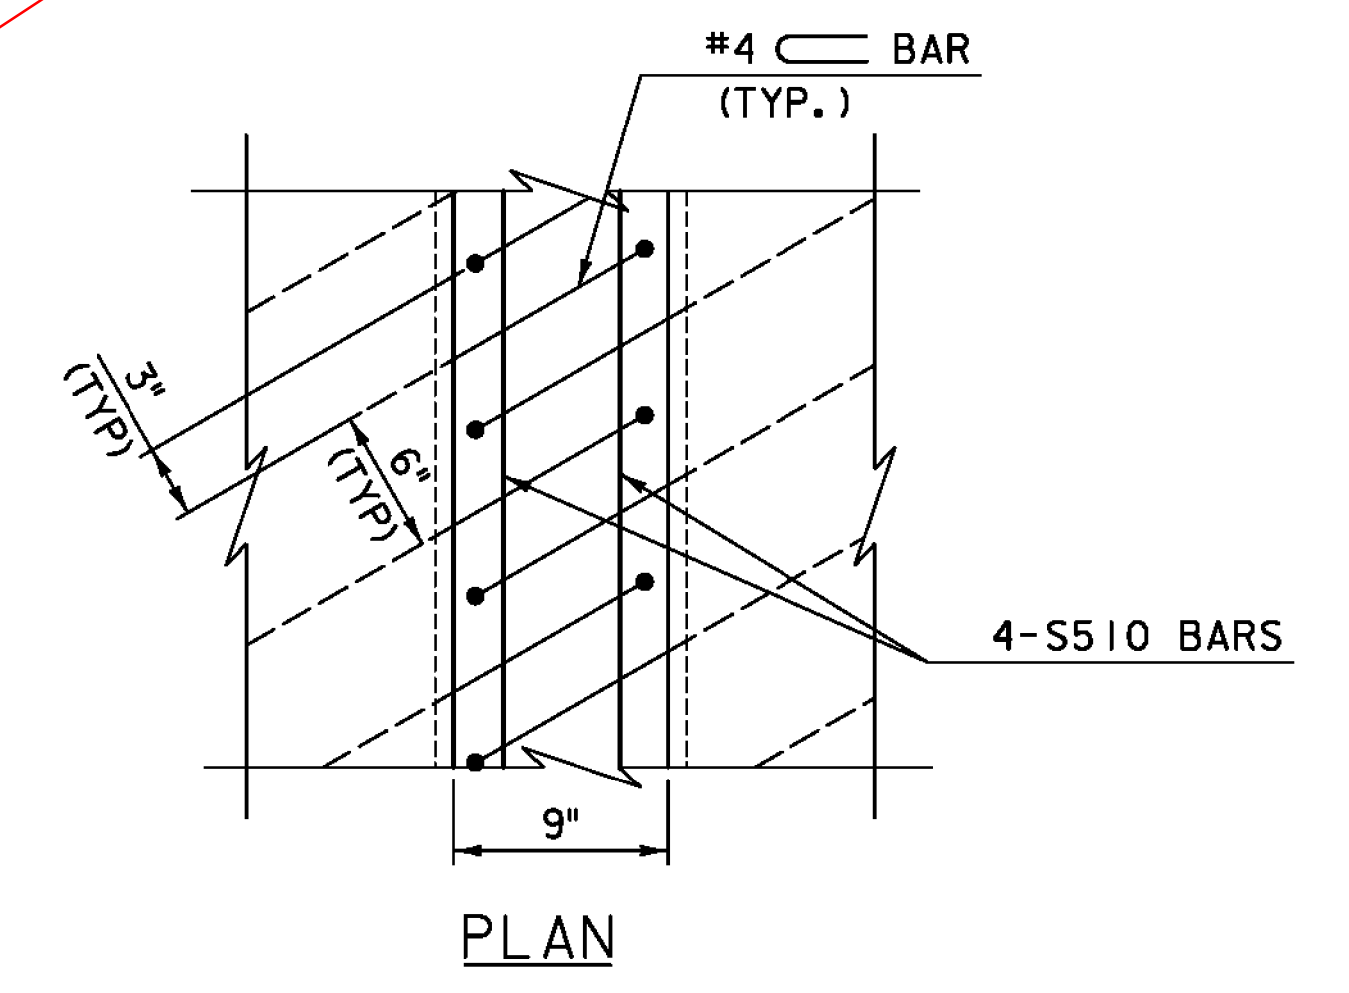

PLAN

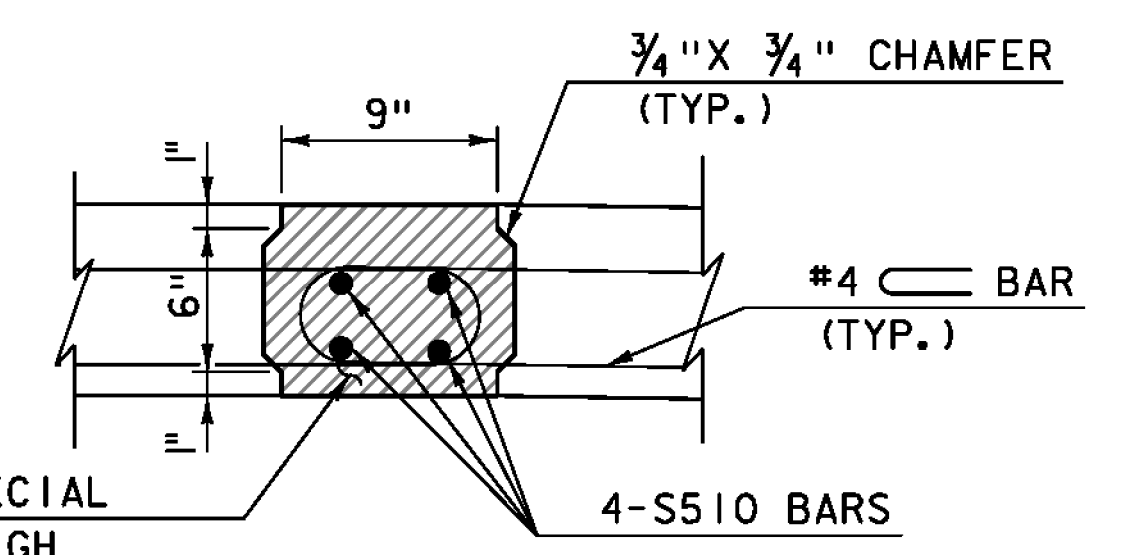

SECTION

SHEAR KEY DETAILS

SCALE: 1/2" = 1'-0"

FILL WITH SPECIAL PROVISION (HIGH PERFORMANCE CONCRETE, RAPID SET)

PRECAST BEAM NOTES:

1. PRESTRESSING STRANDS SHALL BE 0.6 INCH DIAMETER.
2. ALL STRANDS SHALL BE TENSIONED TO 44 KIPS EACH.
3. ANGLE VERTICAL LEGS OF RAILING BAR TO MAKE THEM PLUMB IN PLACE. REFER TO 'BRIDGE RAILING DETAILS (1 OF 3)' FOR ADDITIONAL RAILING DETAILS.
4. SHEAR KEY FACES SHALL BE SAND BLASTED AT THE PRECAST PLANT TO IMPROVE CLOSURE POUR GROUT BOND. IF VISUAL INSPECTION REVEALS LAITANCE OR DEBRIS WITHIN THE SHEAR KEYS WHEN THE BEAMS ARRIVE ON-SITE, THEN THE SHEAR KEY FACES SHALL BE CLEANED BY POWER WASHING OR OTHER METHOD APPROVED BY THE ENGINEER.

PROJECT NAME: ROCKINGHAM	PLOT DATE: 8/26/2014
PROJECT NUMBER: BRF 0126(12)	DRAWN BY: D. AXTELL
FILE NAME: z10J072bdr_glrder_3.dgn	CHECKED BY: T. POULIN
DESIGNED BY: S. KELLER	SHEET 29 OF 69
NEXT D BEAM DETAILS (3 OF 3)	