



ABUTMENT #1 PLAN

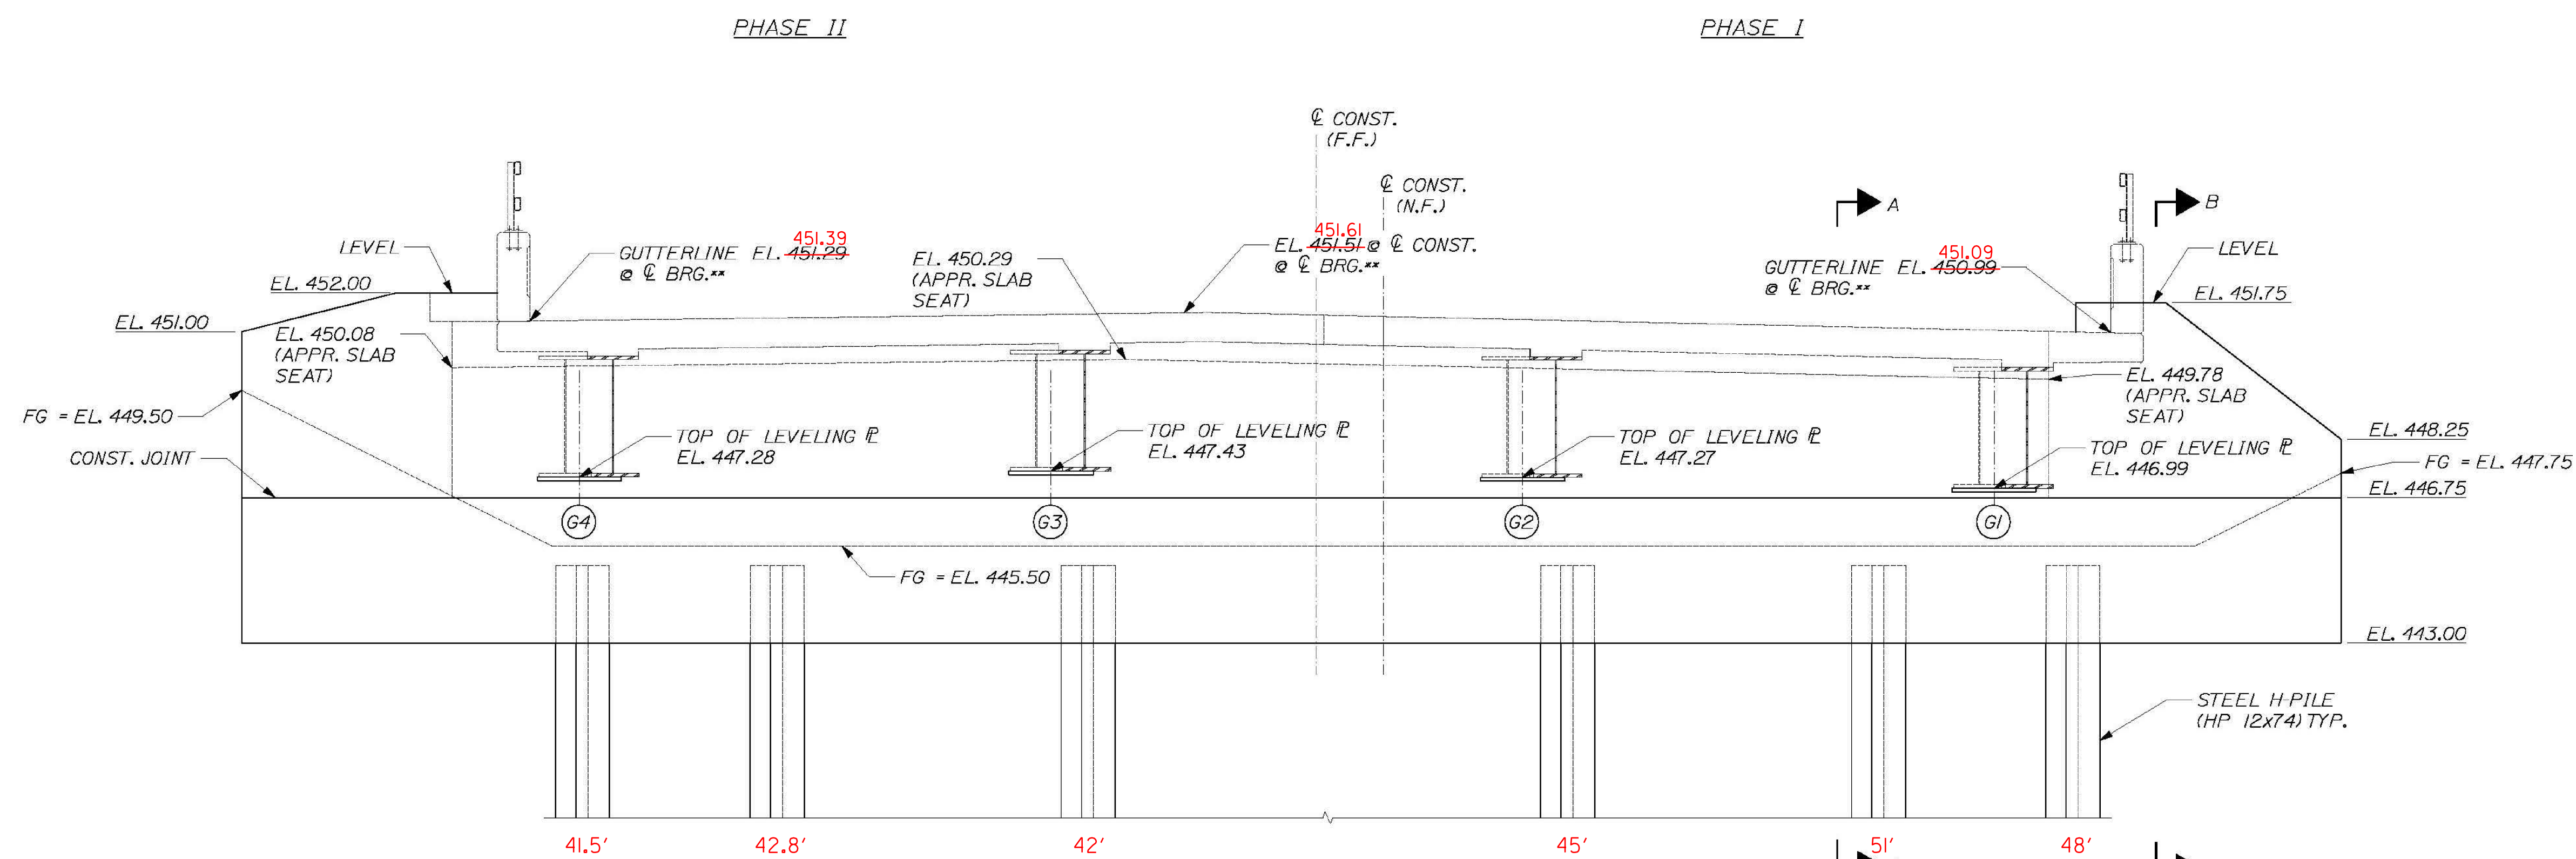

**NOTE: ELEVATIONS PROVIDED ARE TOP OF DECK ELEVATIONS (FINAL ELEVATION LESS PAVEMENT)

ABUTMENT #1 ELEVATION
 3/8"=1'-0"
 NOTE: FRONT FACE OF DECK & RAIL ONLY SHOWN FOR CLARITY

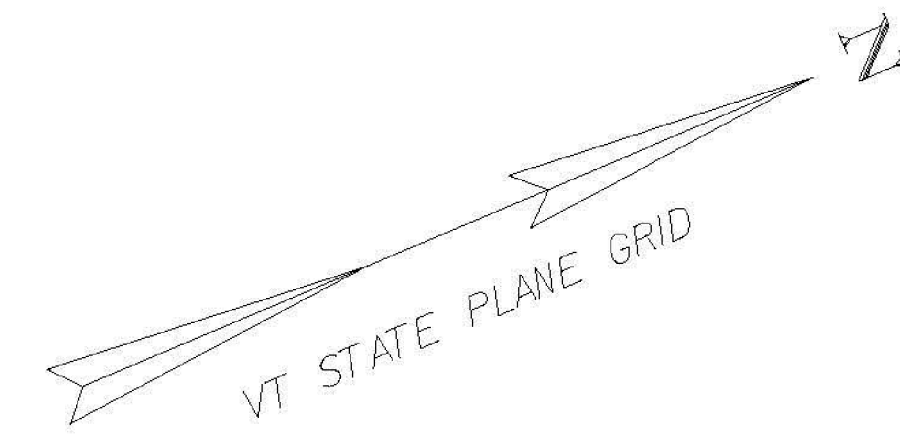

CALDERWOOD ENGINEERING, ETC.
 STRUCTURAL ENGINEERING • DETAILING SERVICES
 222 RIVER RD. RICHMOND, ME 04857 PH/FX (207) 337-2007/2007 737-3008
 PREPARED FOR
COLD RIVER BRIDGES, LLC
 CEE 106-BR-14

DESIGN DETAILED	DATE	BY	REVISIONS 1	P.E. NUMBER
CHECKED-REVIEWED	2014	ETC	REVISIONS 2	DATE:
			REVISIONS 3	
			REVISIONS 4	
			FIELD CHANGES	

VE SUPER. DESIGN
 ROCKINGHAM VT. BR# 0126 (12)
 ABUTMENT 1 MASONRY

SHEET NUMBER
 32

