


ABUTMENT #1 PLAN ~ PHASE I REINFORCEMENT
3/8"=1'-0"

NOTE: ADJUST IA501 BARS IN FIELD AS REQ'D TO AVOID GIRDERS

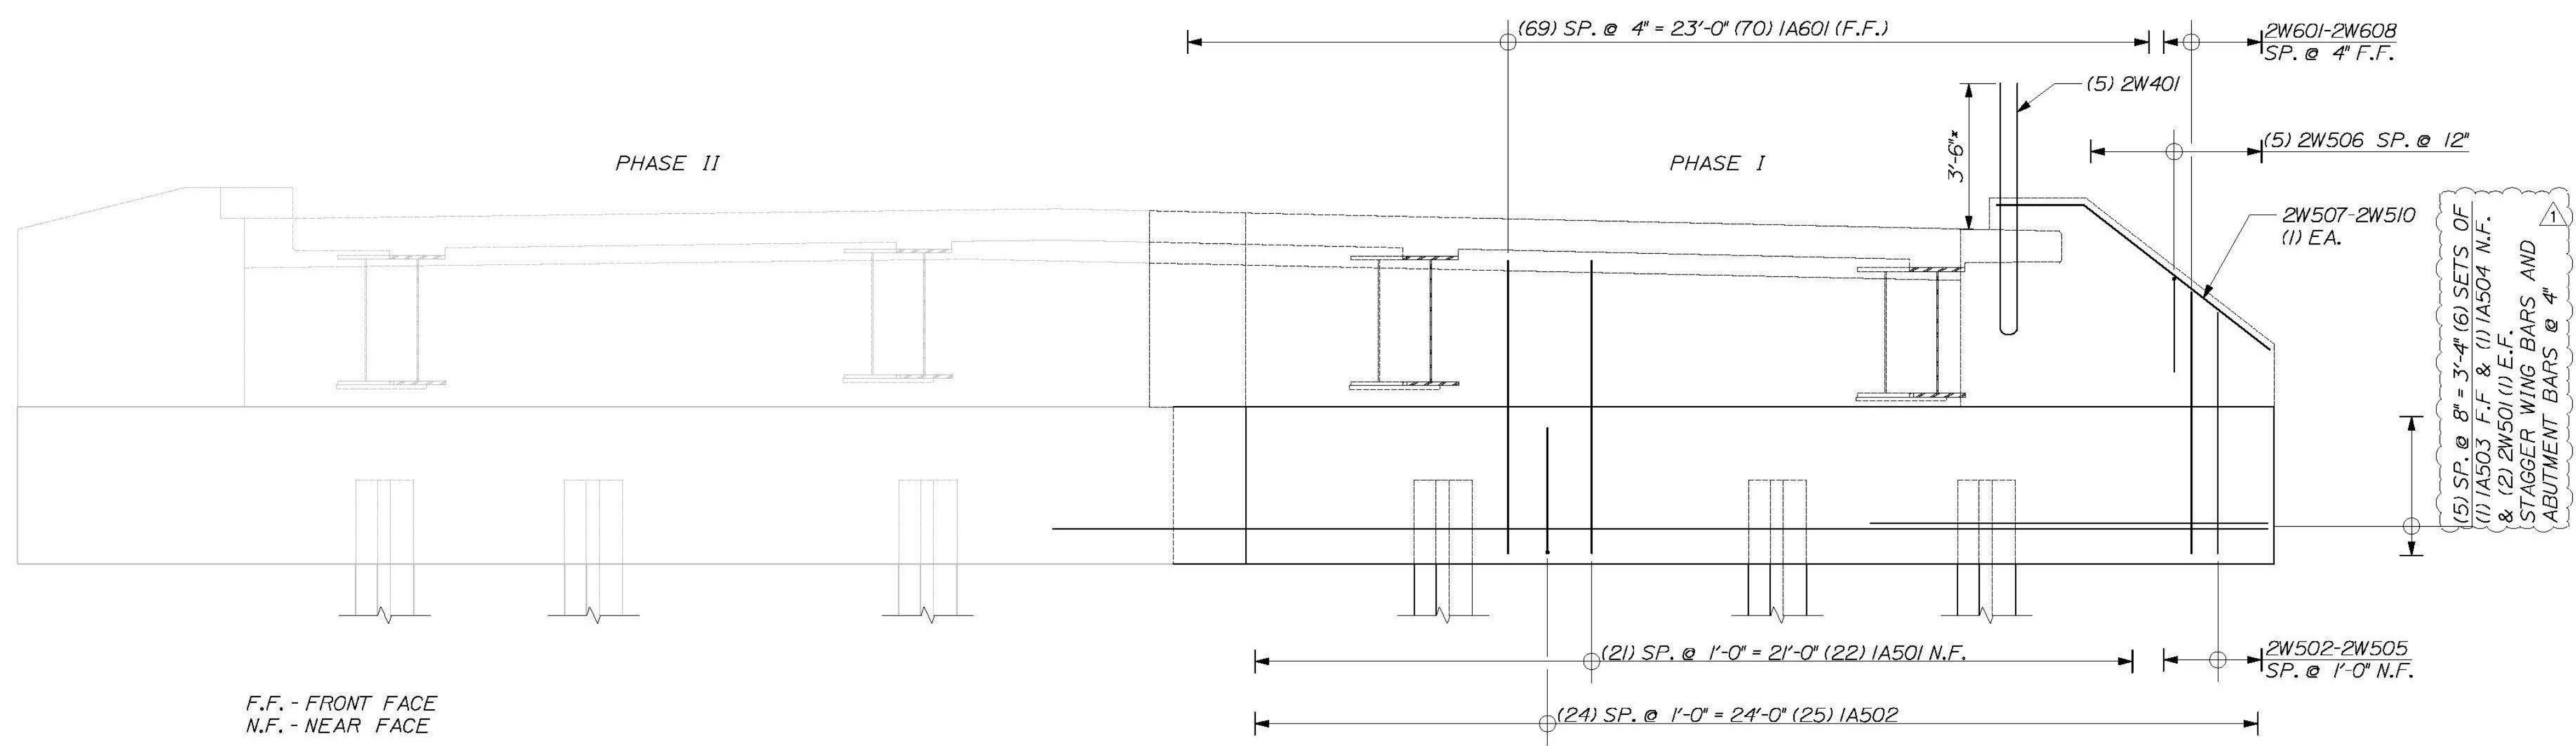

F.F. - FRONT FACE
N.F. - NEAR FACE

ABUTMENT #1 ELEVATION ~ PHASE I REINFORCEMENT
3/8"=1'-0"

* TRIM 2W401 BARS IN FIELD AS NEEDED TO MAINTAIN COVER TO TOP OF CONCRETE BRIDGE RAILING END POST

CALDERWOOD ENGINEERING, ETC.
STRUCTURAL ENGINEERING • DETAILING SERVICES
222 RIVER RD, RICHMOND, ME 04357 PH/FX (207)737-2007/(207) 737-2008
PREPARED FOR:
COLD RIVER BRIDGES, LLC
CEE 106-BR-14

DESIGN/DETAILED	DATE	BY	DATE
CHECKED/REVIEWED	ETC	ETC	2014
REVISIONS 1			
REVISIONS 2			
REVISIONS 3			
REVISIONS 4			
FIELD CHANGES			
			P.E. NUMBER
			DATE:

VE SUPER. DESIGN
ROCKINGHAM VT. BR# 0126 (12)
ABUTMENT 1 PHASE I REINFORCEMENT

SHEET NUMBER
33

