


NOTE: ADJUST 1A501 BARS IN FIELD AS REQ'D TO AVOID GIRDERS

ABUTMENT #1 PLAN ~ PHASE II REINFORCEMENT
3/8"=1'-0"

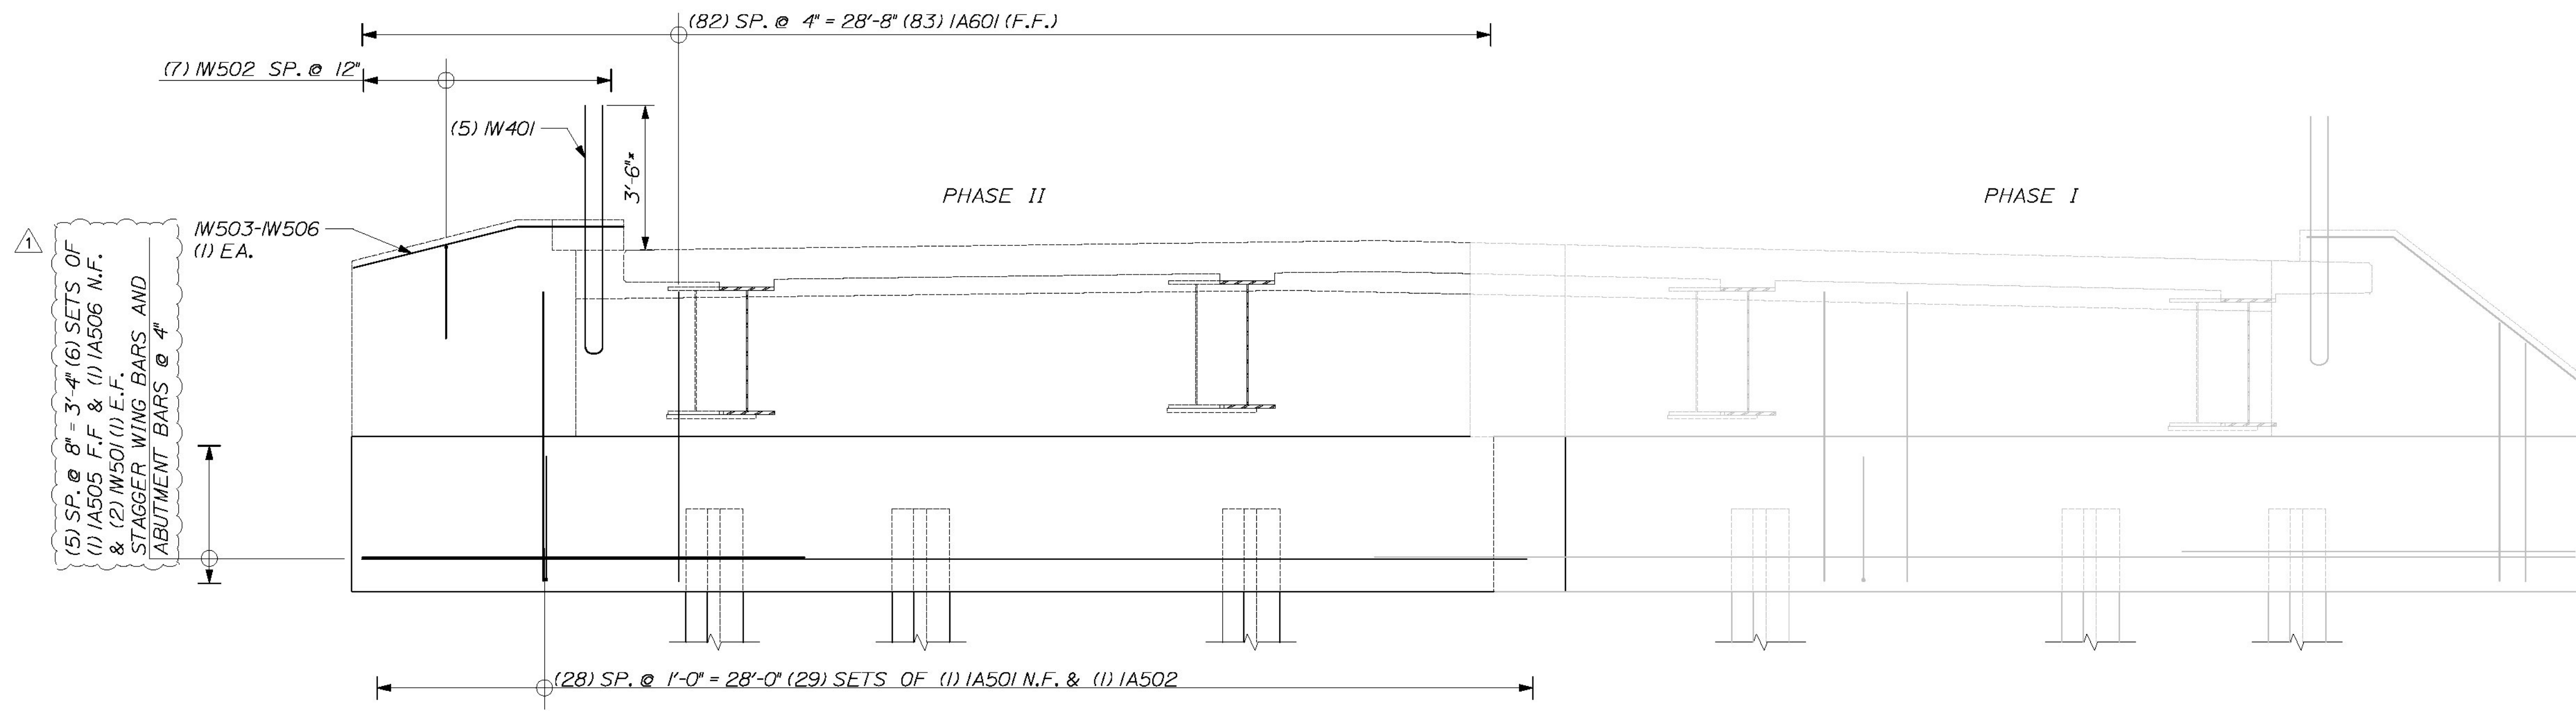

* TRIM W401 BARS IN FIELD AS NEEDED TO MAINTAIN COVER TO TOP OF CONCRETE BRIDGE RAILING END POST

ABUTMENT #1 ELEVATION ~ PHASE II REINFORCEMENT
3/8"=1'-0"

CALDERWOOD ENGINEERING, ETC.
STRUCTURAL ENGINEERING • DETAILING SERVICES
222 RIVER RD, RICHMOND, ME 04357 PH/FX (207)737-2007/(207) 737-2008
PREPARED FOR:
COLD RIVER BRIDGES, LLC
CEE 106-BR-14

DESIGN-REVIEWED	BY	DATE	P.E. NUMBER
ETC	ETC	2014	
REVISIONS 1			
REVISIONS 2			
REVISIONS 3			
REVISIONS 4			
FIELD CHANGES			

VE SUPER. DESIGN
ROCKINGHAM VT. BR# 0126 (12)
ABUTMENT 1 PHASE II REINFORCEMENT

SHEET NUMBER
33a

