


ABUTMENT #2 PLAN ~ PHASE II REINFORCEMENT
3/8"=1'-0"


NOTE: ADJUST 2A50I BARS IN FIELD AS REQ'D TO AVOID GIRDERS

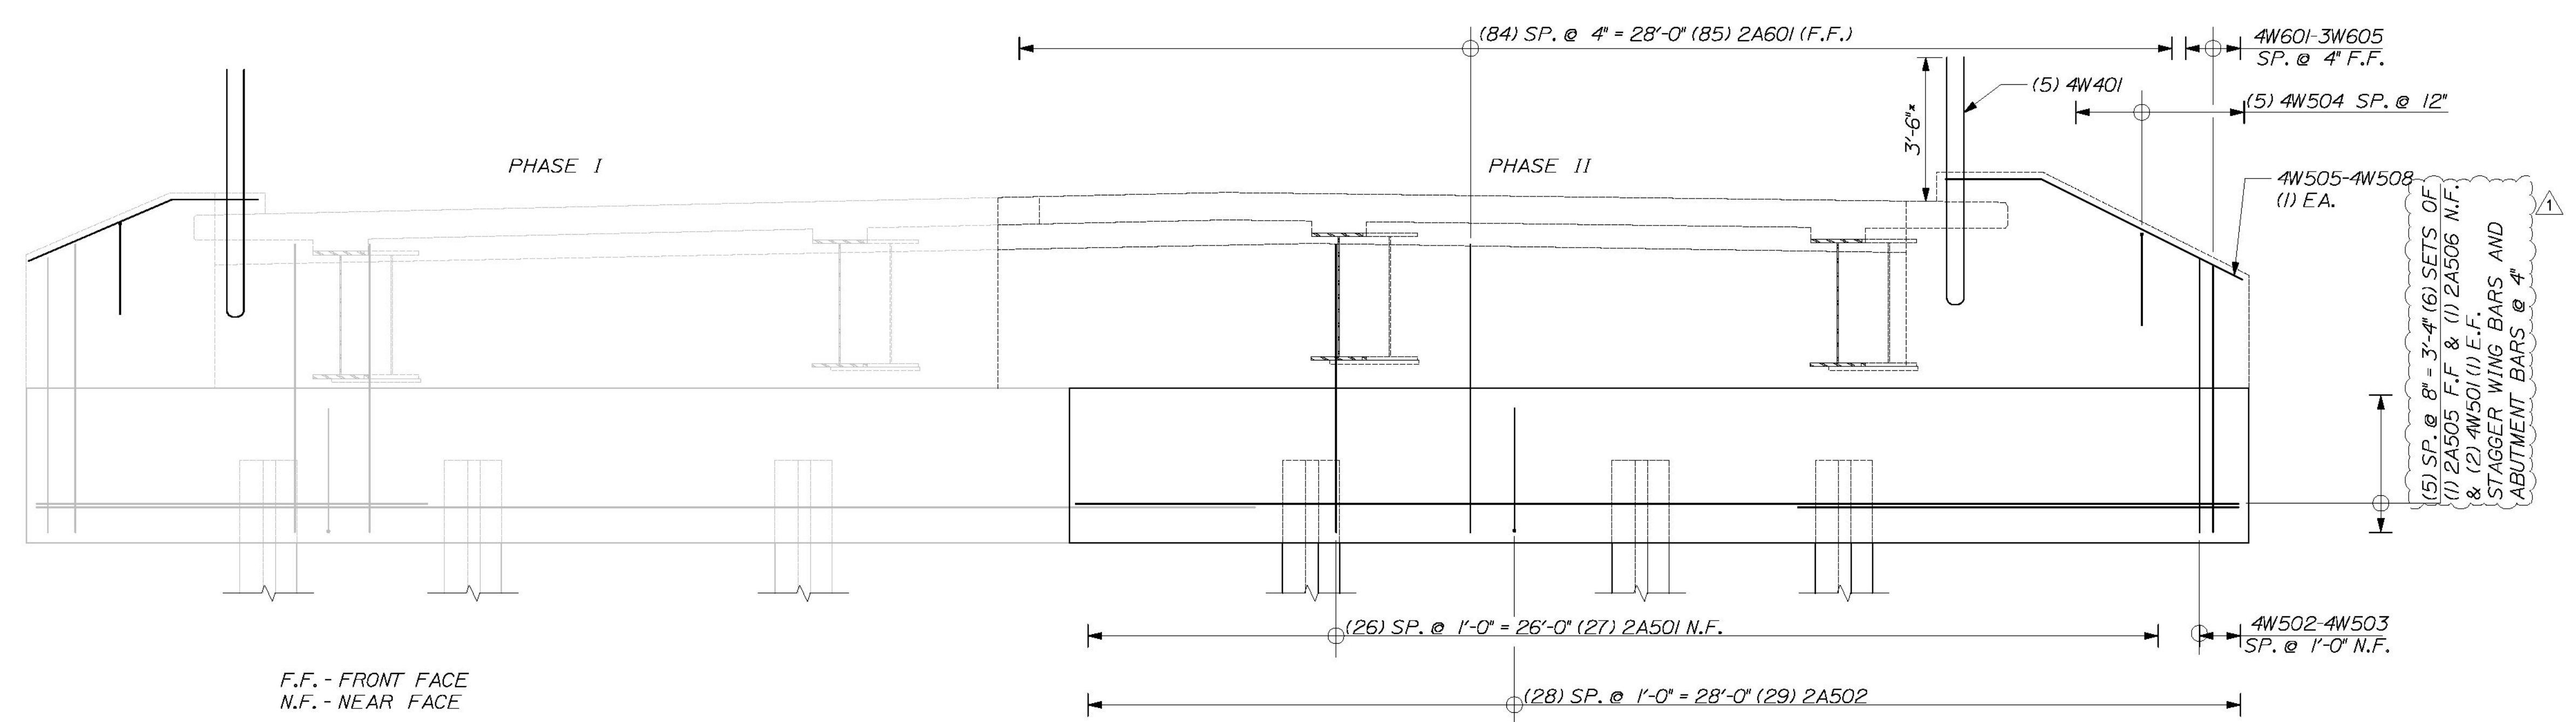

ABUTMENT #2 ELEVATION ~ PHASE II REINFORCEMENT
3/8"=1'-0"

(5) SP. @ 8" = 3'-4" (6) SETS OF (1) 2A505 F.F. & (1) 2A506 N.F. & (2) 4W50I (1) F.F. STAGGER WING BARS AND ABUTMENT BARS @ 4"

F.F. - FRONT FACE
N.F. - NEAR FACE

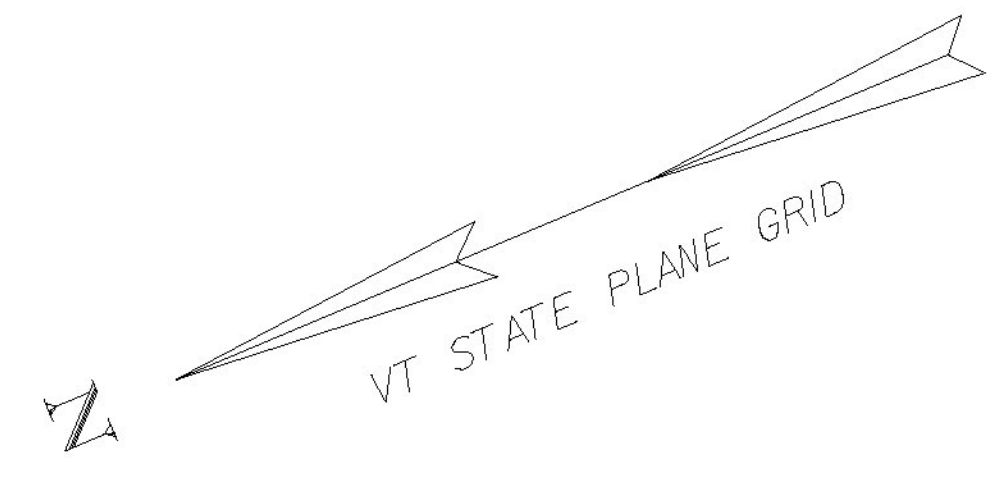

CALDERWOOD ENGINEERING, ETC.
STRUCTURAL ENGINEERING • DETAILING SERVICES
222 RIVER RD, RICHMOND, ME 04357 PH/FX (207)737-2007/(207) 737-2008
PREPARED FOR:
COLD RIVER BRIDGES, LLC
CEE 106-BR-14

DESIGN-DETAILED	DATE	BY	DATE
CHECKED-REVIEWED	ETC	ETC	2014
REVISIONS 1			
REVISIONS 2			
REVISIONS 3			
REVISIONS 4			
FIELD CHANGES			

VE SUPER. DESIGN
ROCKINGHAM VT. BR# 0126 (12)
ABUTMENT 2 PHASE 2 REINFORCEMENT

SHEET NUMBER
35a

