


STA 61+07.38 LEFT
 BEGIN GEOTEXTILE UNDER STONE FILL
 STONE FILL, TYPE I

61+25

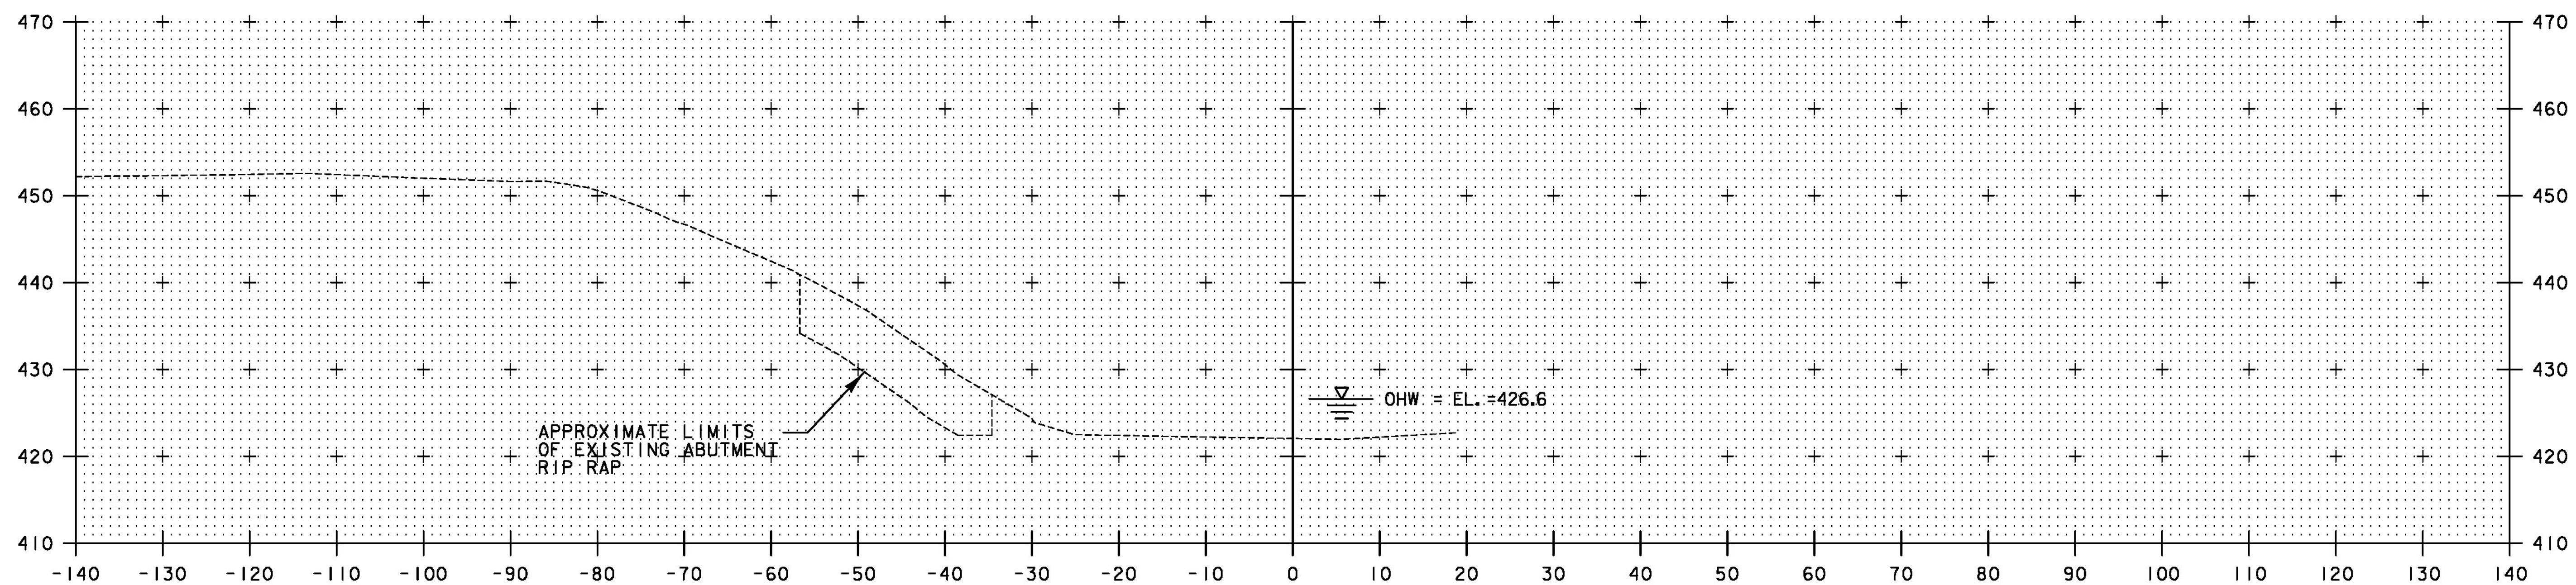

61+00

STA. 61+00 TO STA. 61+25

PROJECT NAME: ROCKINGHAM
 PROJECT NUMBER: BRF 0126(12)

FILE NAME: z10j072bdr_xs02.dgn
 PROJECT LEADER: R. HEBERT
 DESIGNED BY: D. BURHANS
 CHANNEL CROSS SECTIONS - I

PLOT DATE: 8/26/2014
 DRAWN BY: D. BURHANS
 CHECKED BY: D. BRYANT
 SHEET 47 OF 69

SCALE 1" = 10' - 0"

TYLIN INTERNATIONAL