


STA 61+74.48 LEFT
 END GEOTEXTILE UNDER STONE FILL
 STONE FILL, TYPE I

61+75

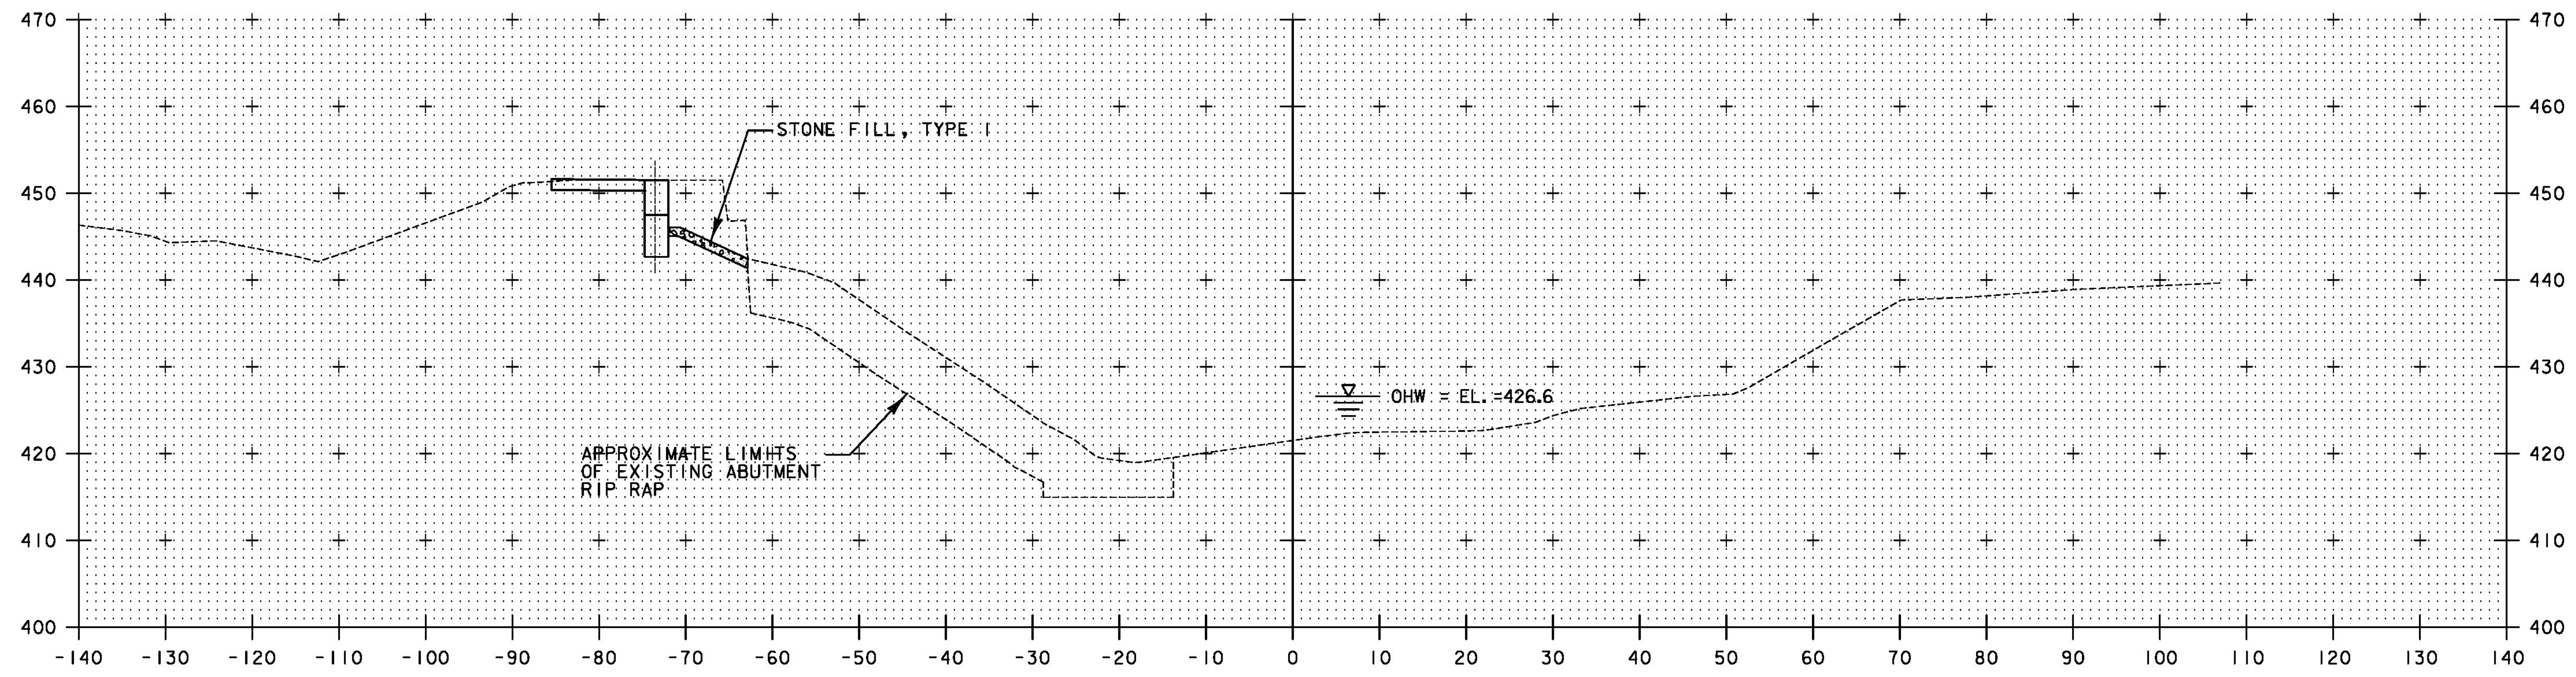

61+50

STA. 61+50 TO STA. 61+75

SCALE 1" = 10' - 0"

TYLIN INTERNATIONAL	PROJECT NAME: ROCKINGHAM	PLOT DATE: 8/26/2014
	PROJECT NUMBER: BRF 0126(12)	DRAWN BY: D. BURHANS
	FILE NAME: z10j072bdr_xs02.dgn	CHECKED BY: D. BRYANT
	DESIGNED BY: D. BURHANS	SHEET 48 OF 69
CHANNEL CROSS SECTIONS - 2		