


62+25

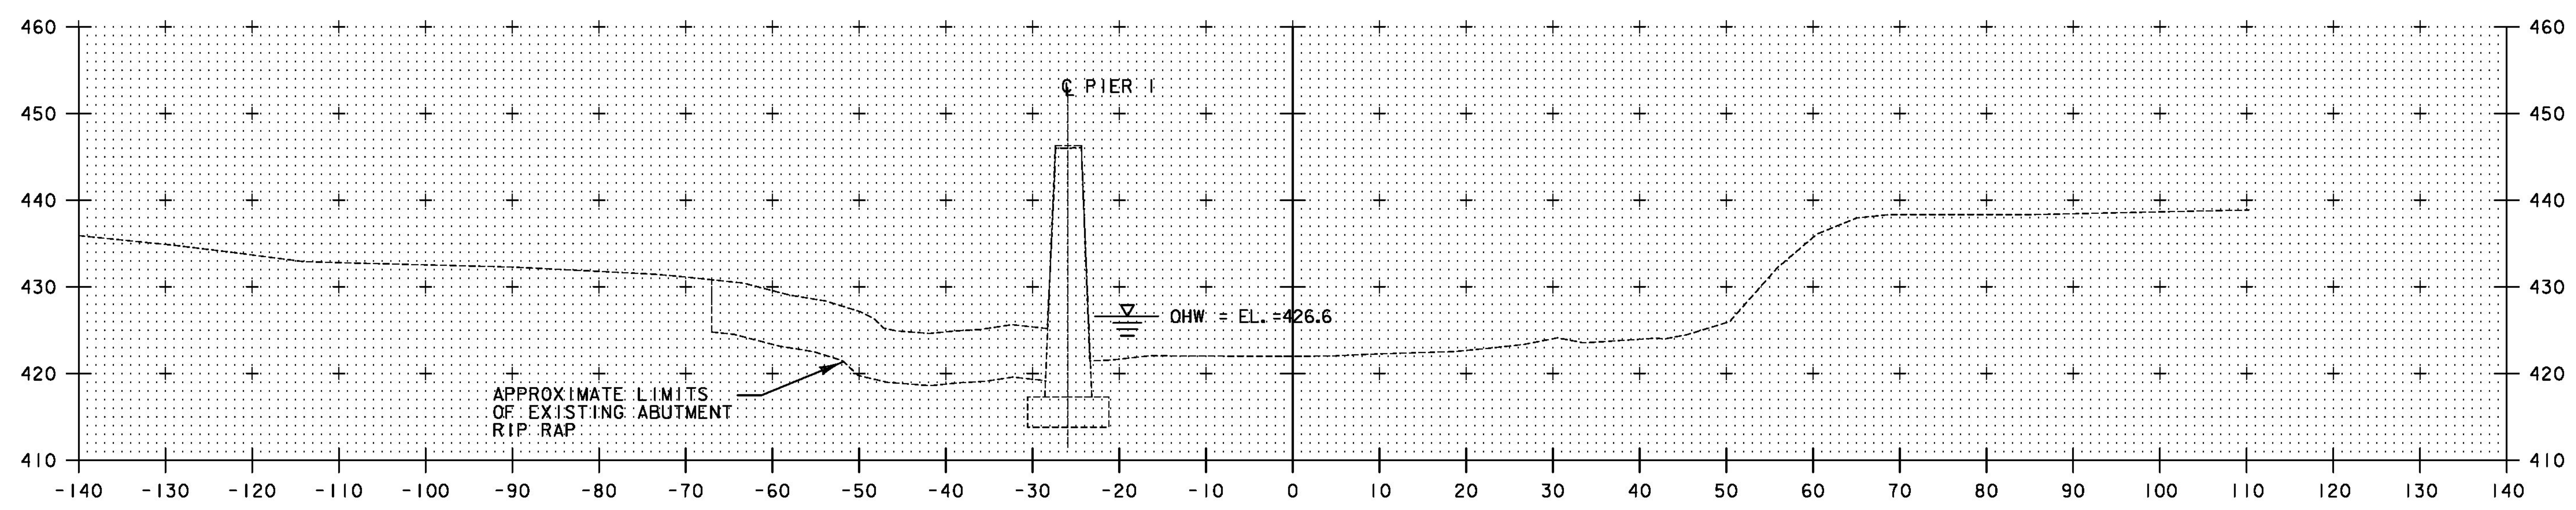

62+00

STA. 62+00 TO STA. 62+25

SCALE 1" = 10' - 0"

TYLIN INTERNATIONAL	PROJECT NAME: ROCKINGHAM	PLOT DATE: 8/26/2014
	PROJECT NUMBER: BRF 0126(12)	DRAWN BY: D. BURHANS
	FILE NAME: z10j072bdr_xs02.dgn	CHECKED BY: D. BRYANT
	DESIGNED BY: D. BURHANS	SHEET 49 OF 69
	CHANNEL CROSS SECTIONS - 3	