




PLAN

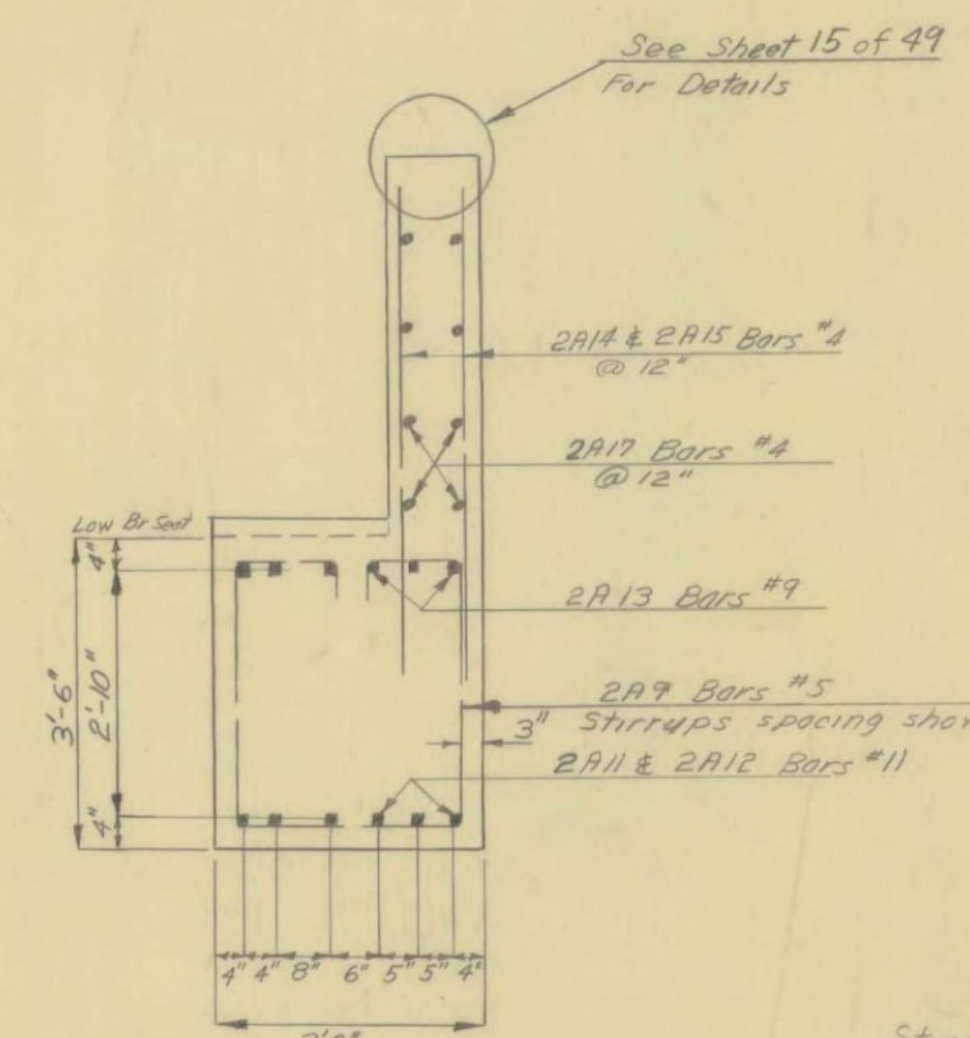


SECTION B-B  
Scale 1/2"=1'-0"

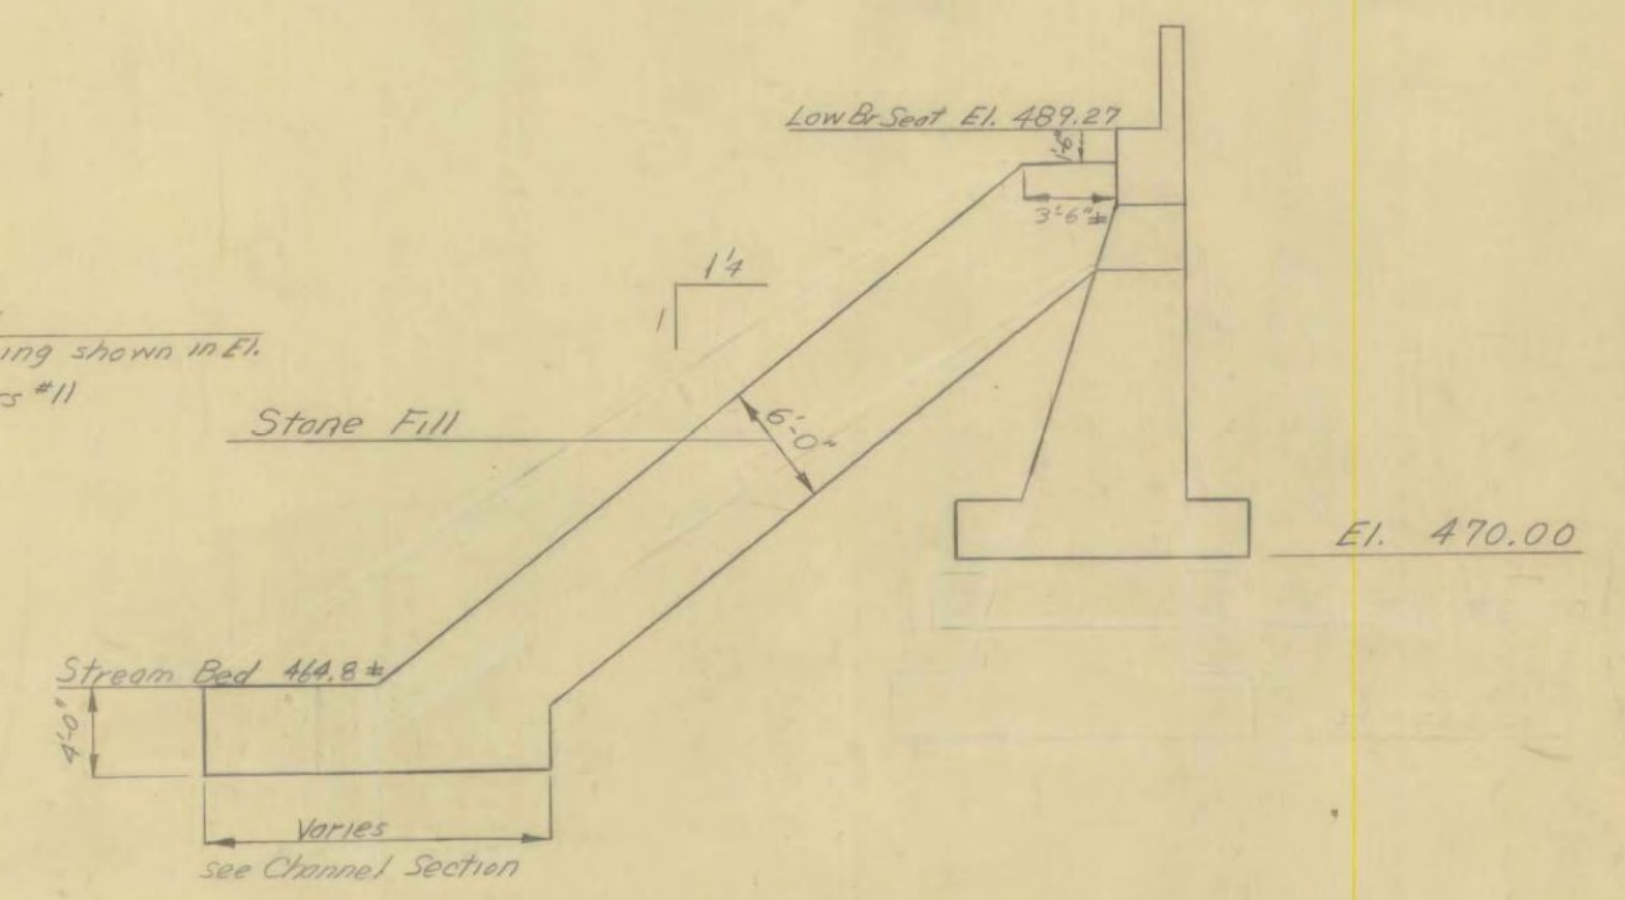

TYPICAL SECTION  
Scale 1/8"=1'-0"

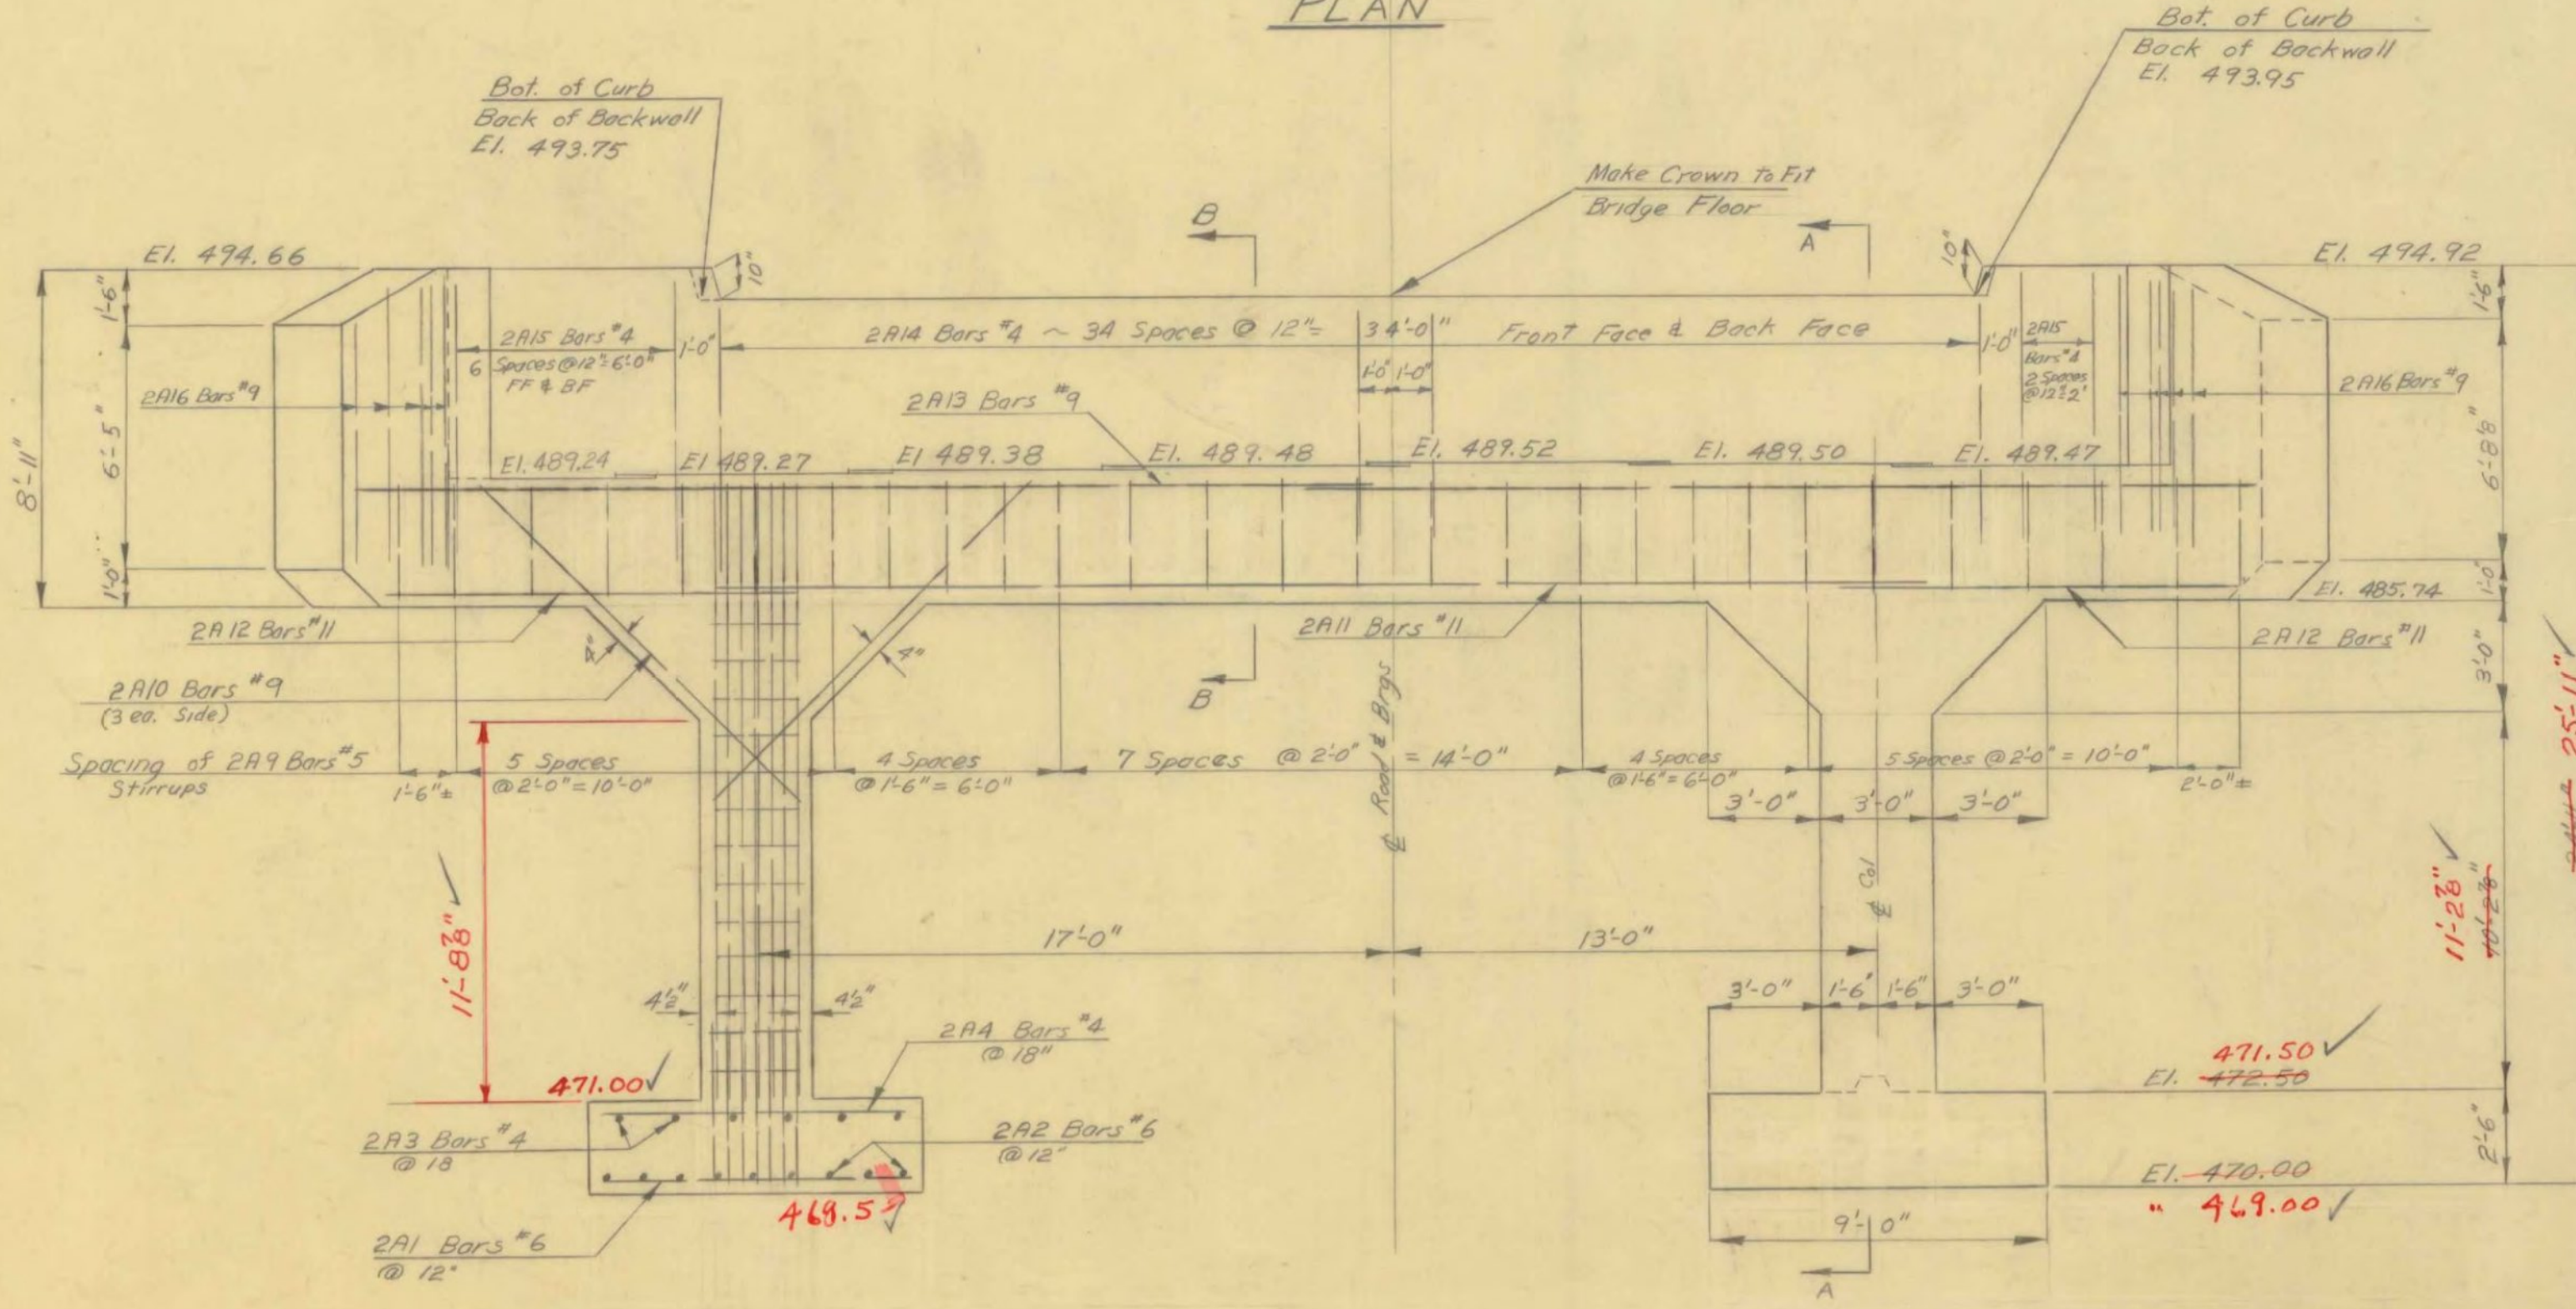

ELEVATION

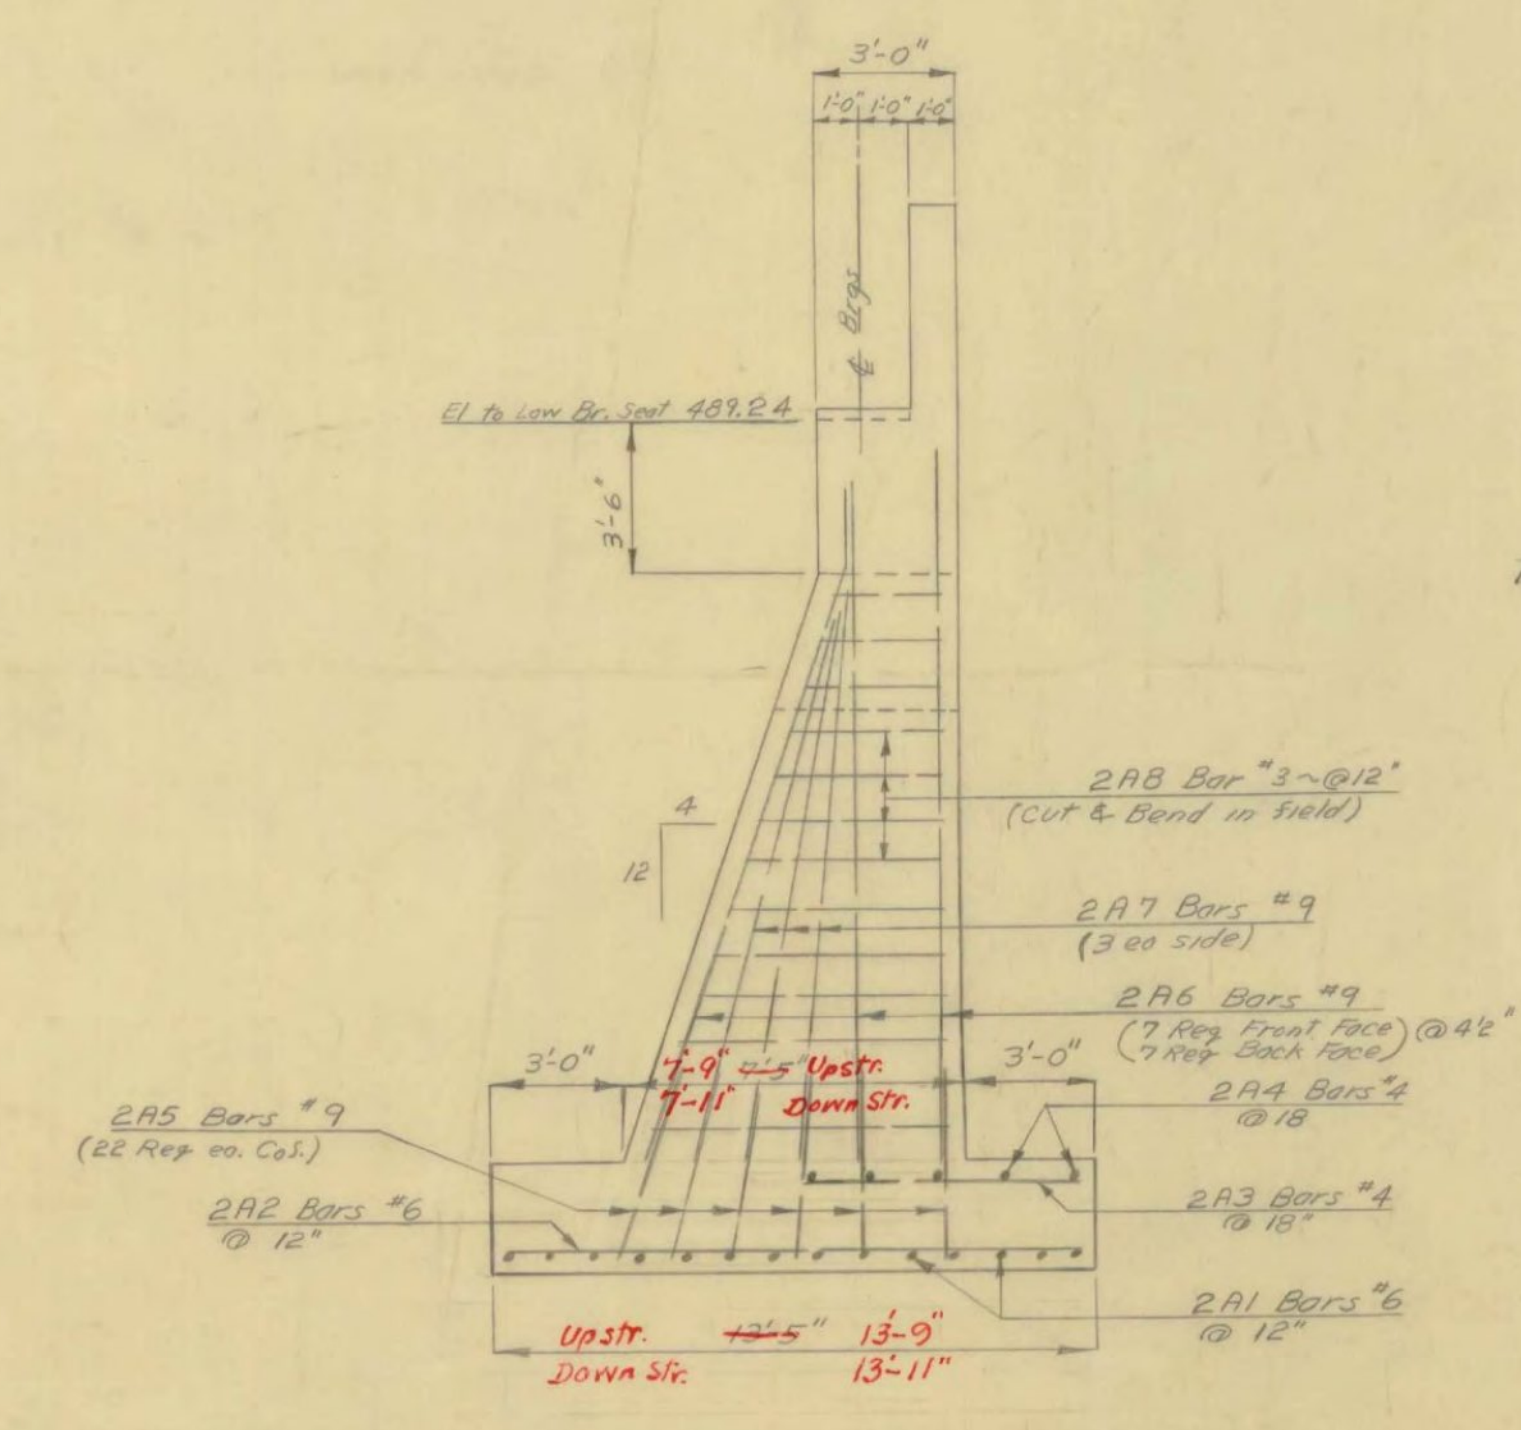

SECTION A-A

FOR REFERENCE ONLY

| ESTIMATED QUANTITIES |                                 |           |
|----------------------|---------------------------------|-----------|
| 106C                 | Unclassified Channel Excavation | 715 CY    |
| 107                  | Structure Excavation            | 196 C.Y.  |
| 401B                 | Concrete Class B                | 75 C.Y.   |
| 521                  | Stone Fill                      | 1050 C.Y. |

STATE OF VERMONT  
DEPARTMENT OF HIGHWAYS

TOWN OF ROCKINGHAM

ROAD NO. Vt 121 BRIDGE NO. 11

DETAILS of ABUTMENT # 2

SCALE 1/4"=1'-0" or as noted

SURVEYED BY Poger

DRAWN BY C.F.H. CHECKED BY Dev. L.H.

PROJECT No. 3-156 (3)

SHEET 11 OF 49