
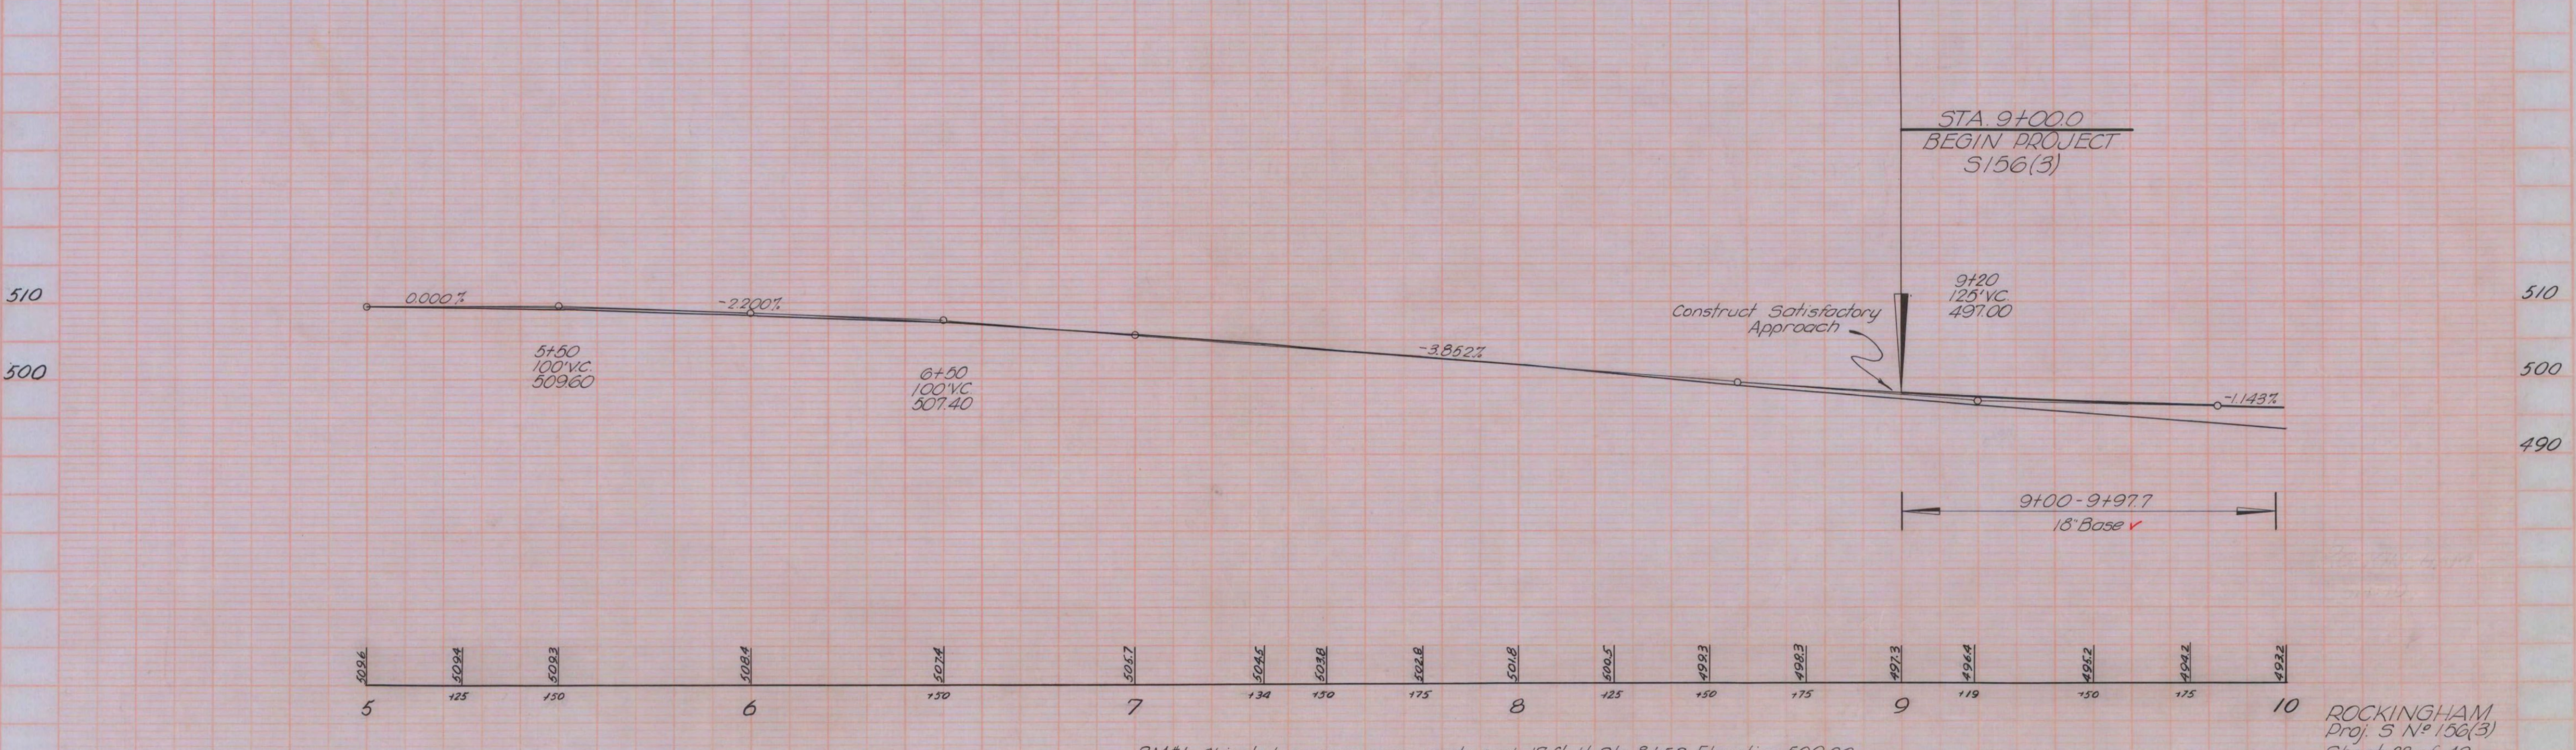


PLAN  
 DATE: 10/26/53  
 DRAWN BY: Z. C. Brownell  
 CHECKED BY: [blank]  
 NO. OF SHEETS: 69

PROFILE  
 DATE: 10/26/53  
 DRAWN BY: Z. C. Brownell  
 CHECKED BY: [blank]  
 NO. OF SHEETS: 69

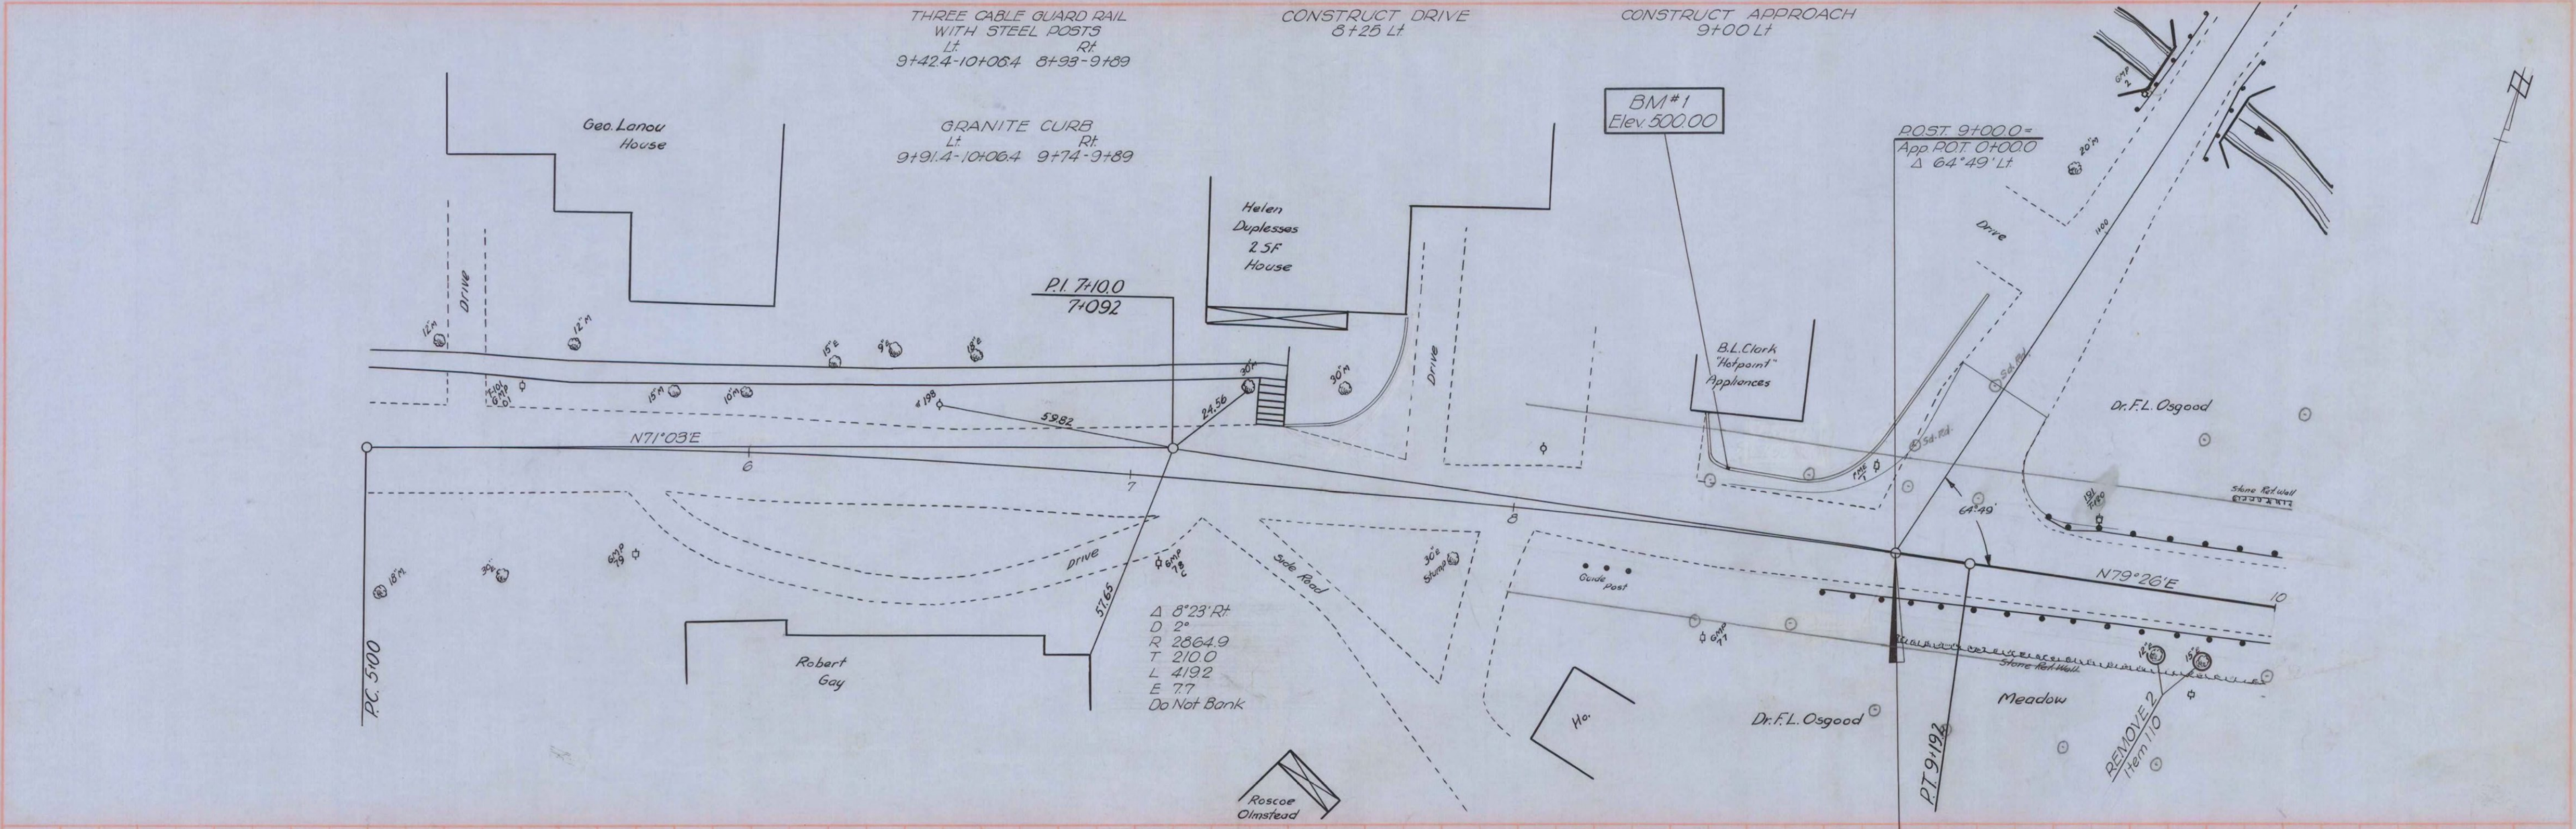

BM#1-Chiseled square on concrete curb 17 ft. lt. Sta. 8+53 Elevation 500.00

FOR REFERENCE ONLY

SHEET 67 OF 69

ROCKINGHAM  
 Proj. S N° 156(3)  
 Sheet 67 of 69