


34' PAY LIMIT

COATED BLACK PER ASTM D7803

HSS 6"x6"x3/16" Kickback  
@ 9'-0" w/End Cap

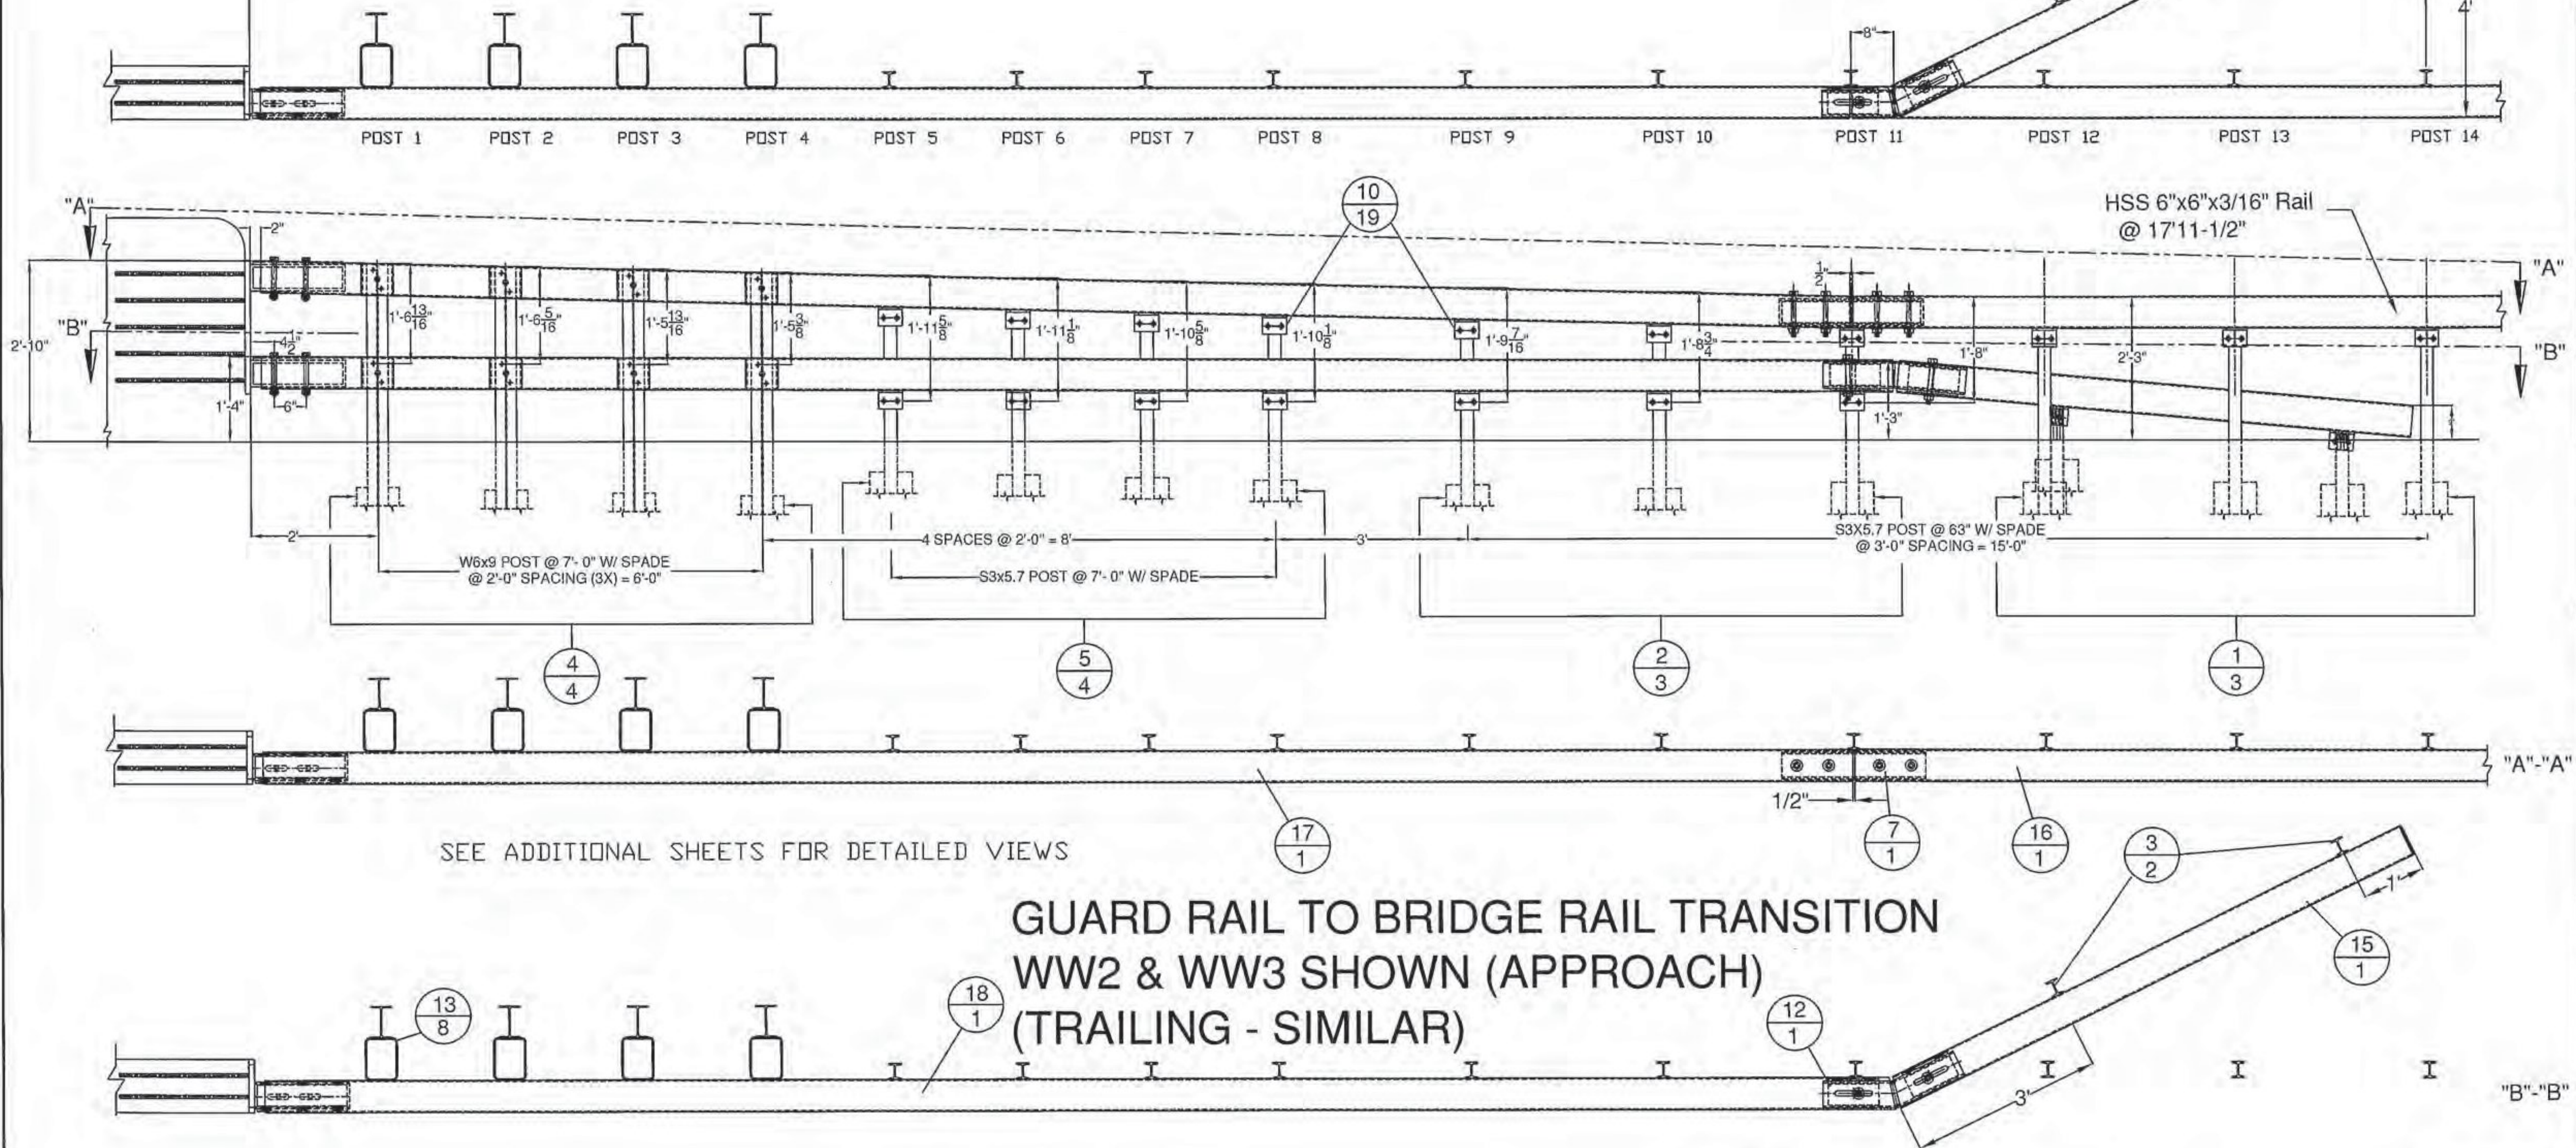

Vermont Agency of Transportation

**RECEIVED**

ON: December 29, 2014

and Checked for

**CONFORMANCE**

BY: TAS DATE: 01/20/2015

ITEM #: 621.72

STRUCTURAL STEEL TO  
COMPLY W/ ASTM A6

TOLERANCE UNLESS  
OTHERWISE NOTED:  
FRACTIONS = ± 1/16"  
ANGLES = ± 1/2"  
DIAMETERS = ± 1/32"

SHEET 1 OF 5

**GRAS, GLV 2 RAIL BOX BEAM**

EM14-192, VT 121 (CL 2, TH 1) RURAL MAJOR COLLECTOR, BRIDGE NO: 11R  
PROJECT: ROCKINGHAM BR 0126(12), TOWN OF ROCKINGHAM, WINDHAM COUNTY, VT

R NO.	DATE	DESCRIPTION	BY	R NO.	DATE	DESCRIPTION	BY

DRAWN	E.P.	12/24/14
CHECKED	D.L.	
APPROVED	M.V.	
SCALE	SCHEMATIC	
DRAWING NO. FR L - ROCKINGHAM-T		



**ELDERLEE, INC.**

OAKS CORNERS, NEW YORK 14518  
E-Mail: dlong@elderlee.com / epeek@elderlee.com  
Tel: 315-789-6670 Fax: 315-789-6616



CERTIFIED FABRICATOR