



NOTE: S.E. CORNER, BOTTOM RAIL
TURNBACK (ITEM #15) - SUPPLIED @
STD 9'-0" LENGTH W/ WELDED END
CAP, CUT & DRILL SPLICE END TO
MATCH FIELD REQUIREMENTS.

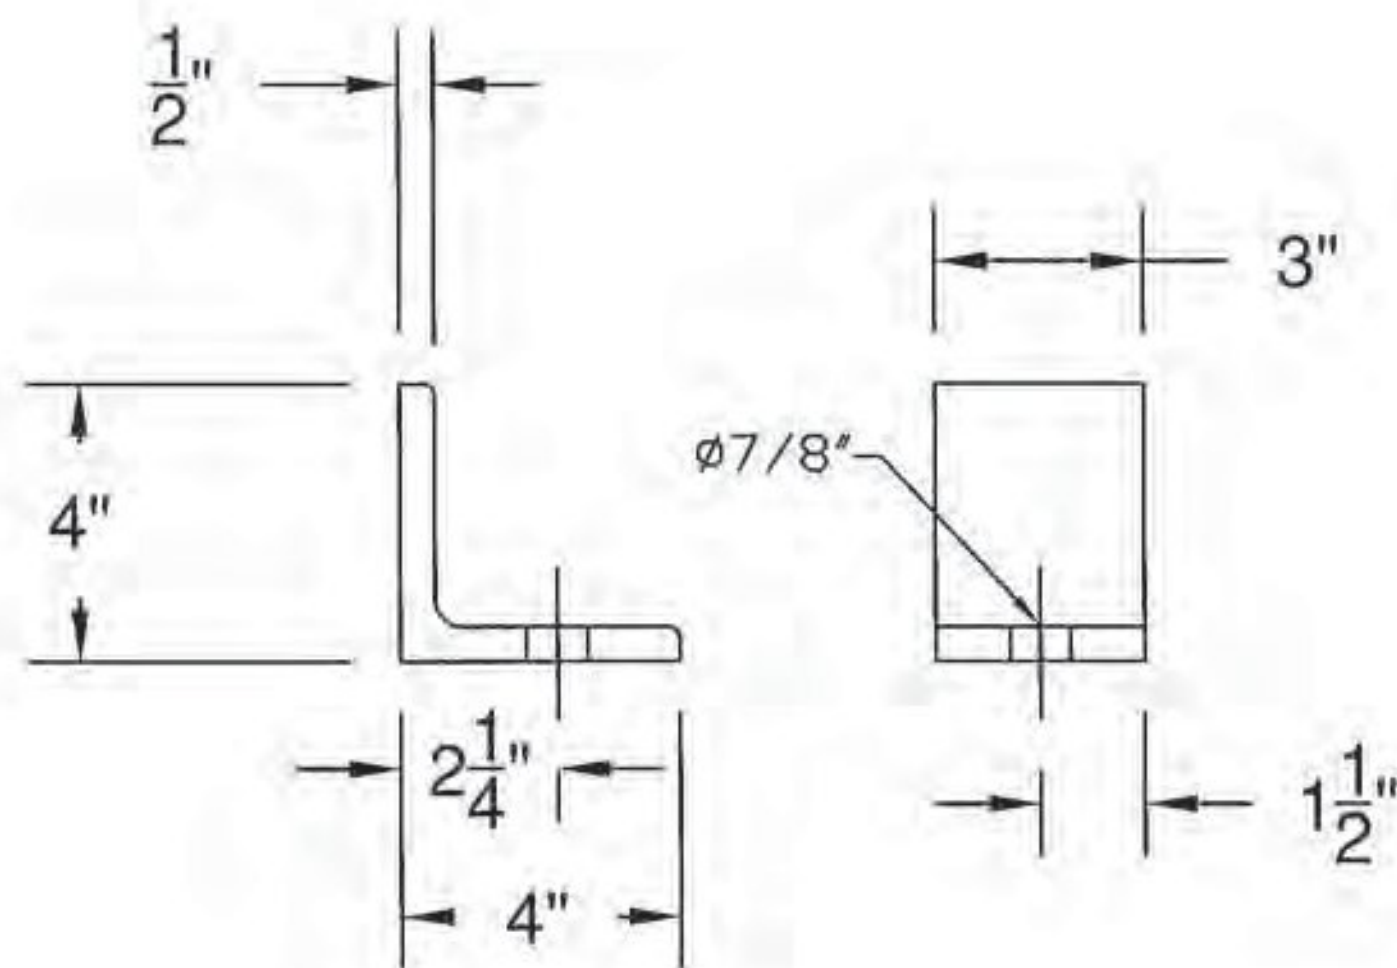

SPECIAL POST DETAIL
FOR WW3 (S.E. CORNER)
BOTTOM RAIL TURNBACK

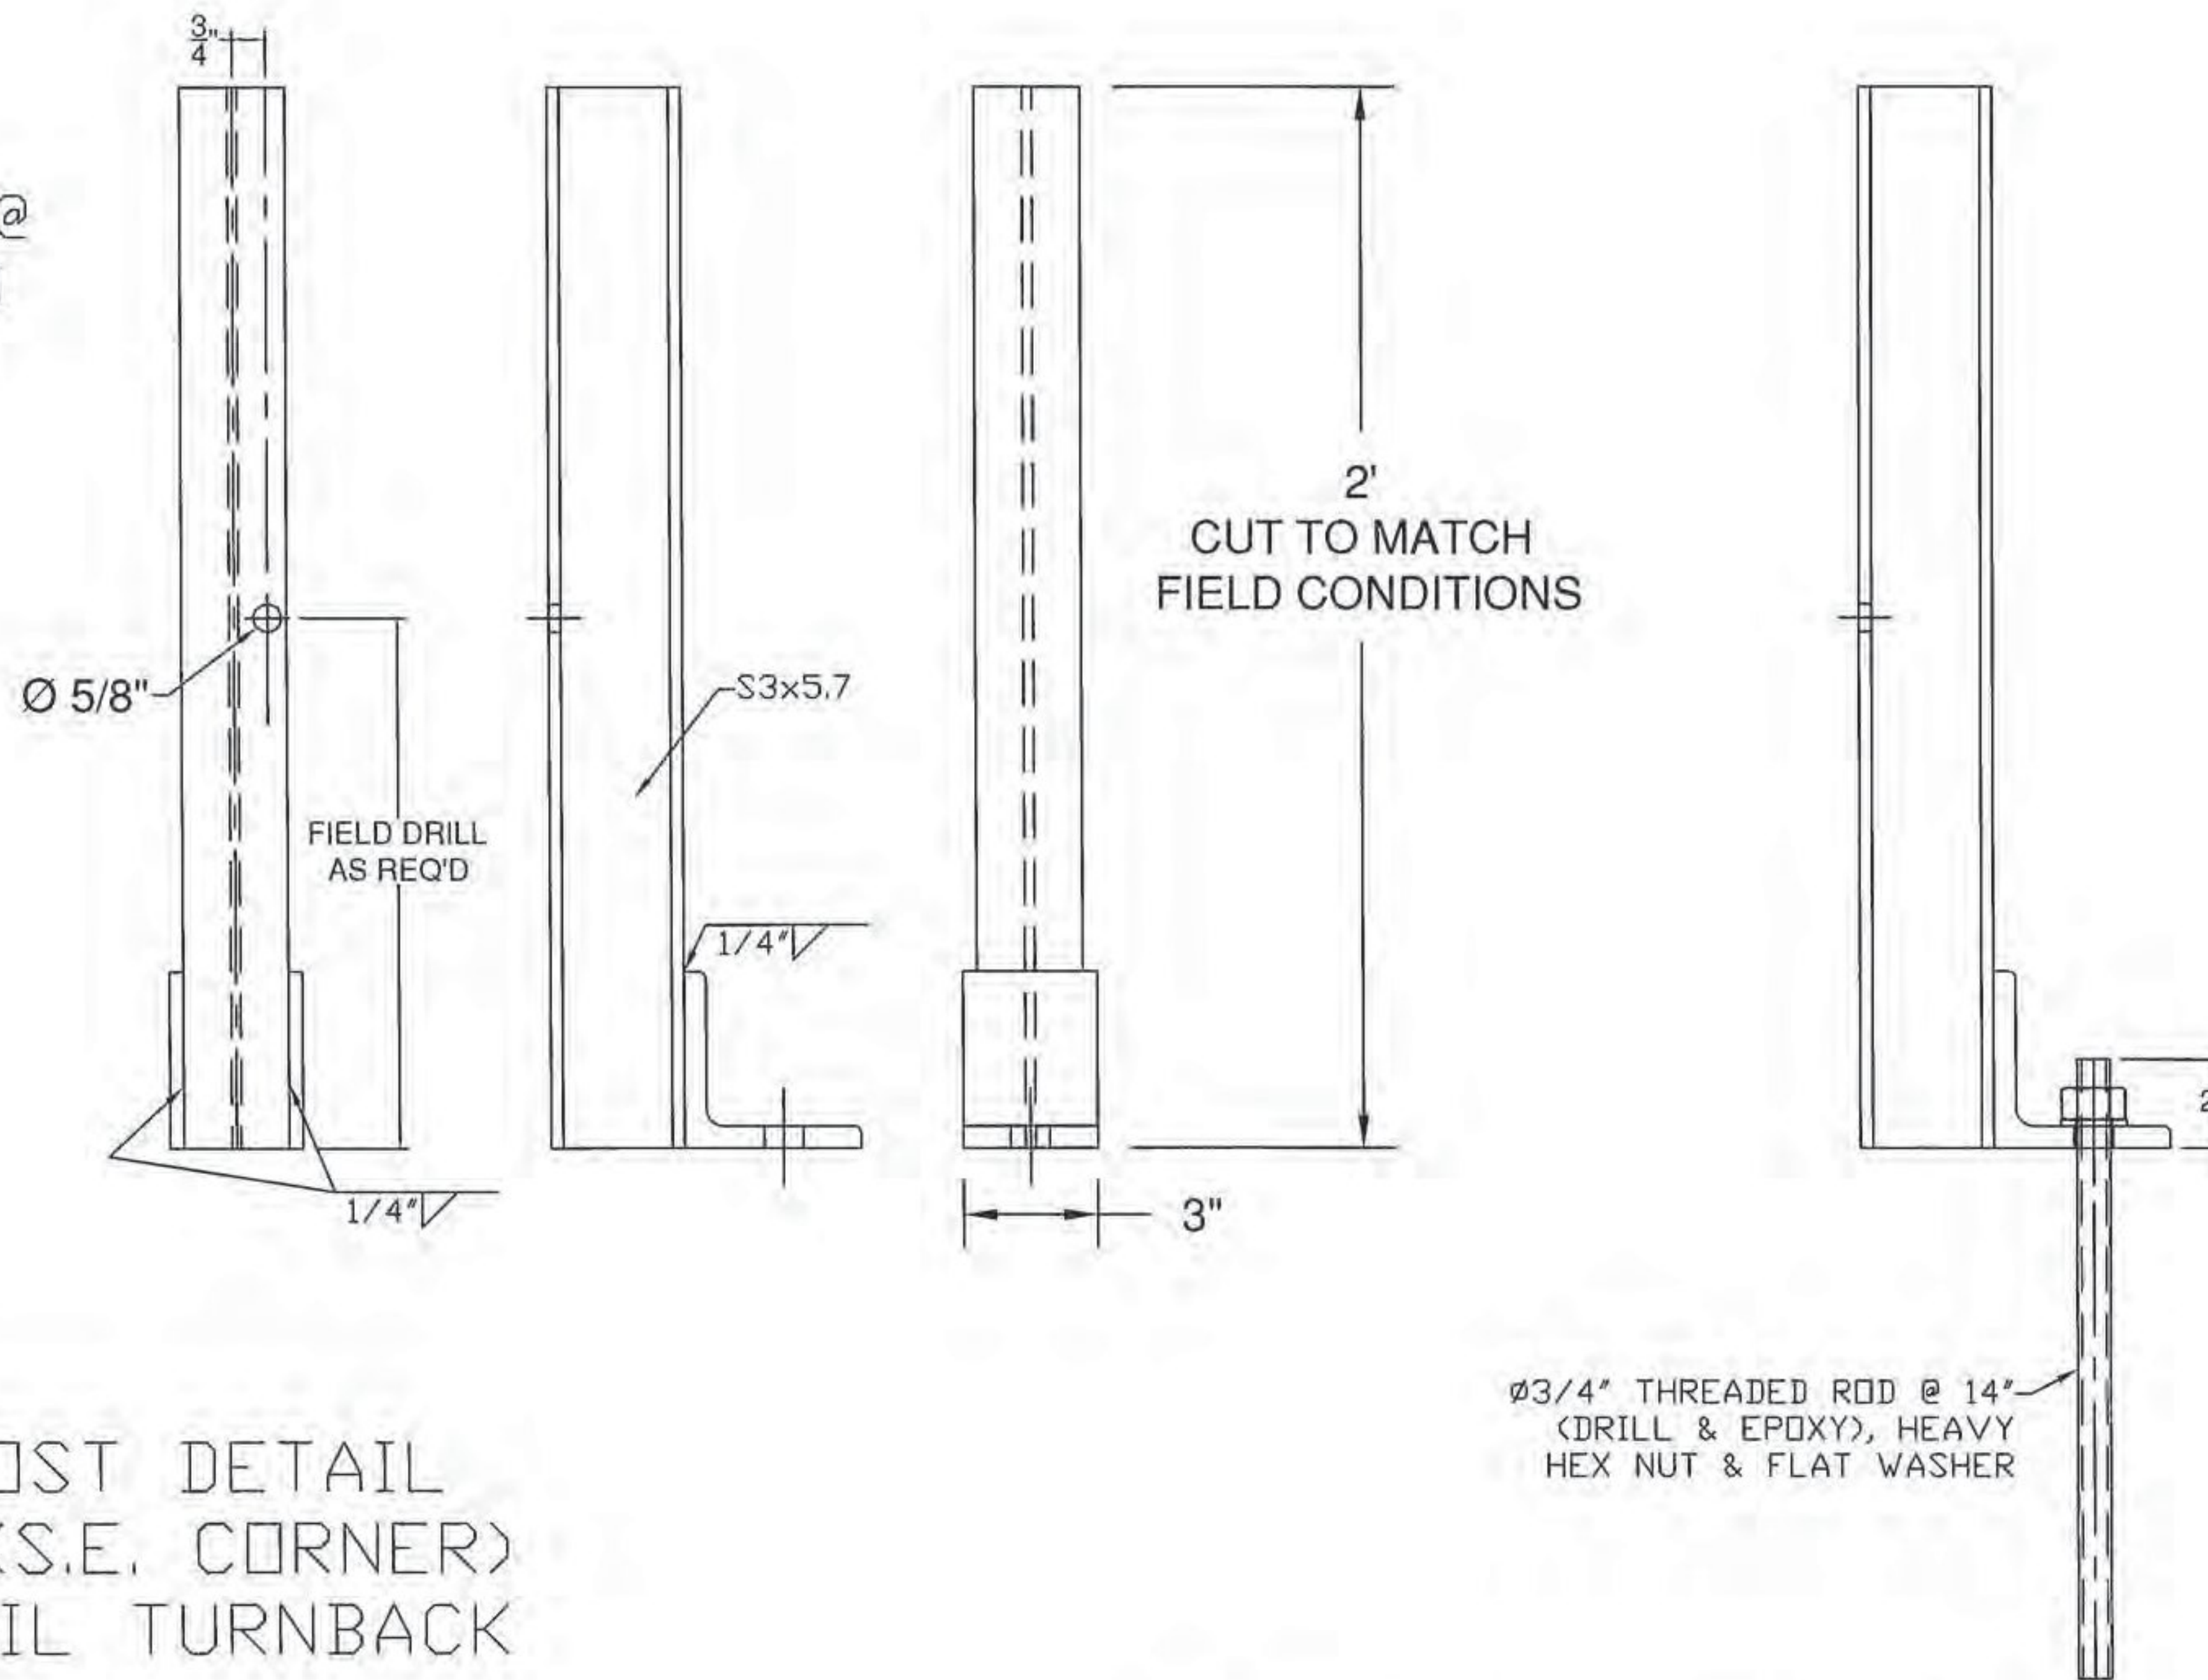

Vermont Agency of Transportation

RECEIVED

ON: December 29, 2014

and Checked for

CONFORMANCE

BY: TAS DATE: 01/20/2015

ITEM #: 621.72

STRUCTURAL STEEL TO
COMPLY W/ ASTM A6

TOLERANCE UNLESS
OTHERWISE NOTED:
FRACTIONS = ± 1/16"
ANGLES = ± 1/2"
DIAMETERS = ± 1/32"

SHEET 5 OF 5

GRAS, GLV 2 RAIL BOX BEAM

EM14-192, VT 121 (CL 2, TH 1) RURAL MAJOR COLLECTOR, BRIDGE NO: 11R
PROJECT: ROCKINGHAM BRIDGE 0126(12), TOWN OF ROCKINGHAM, WINDHAM COUNTY, VT

R	NO.	DATE	DESCRIPTION	BY	R	NO.	DATE	DESCRIPTION	BY
E					E				
V					V				

DRAWN	E.P.	12/24/14
CHECKED	D.L.	
APPROVED	M.V.	
SCALE	SCHEMATIC	
DRAWING NO. FR L - ROCKINGHAM-T		



ELDERLEE, INC.

OAKS CORNERS, NEW YORK 14578
E-Mail: dlong@elderlee.com / epeek@elderlee.com
Tel: 315-789-6670 Fax: 315-789-6616



CERTIFIED
FABRICATOR