




**BURLINGTON INTERCHANGE #14**  
**I-89**

RAMPS REQUIRING CRACK SEALING

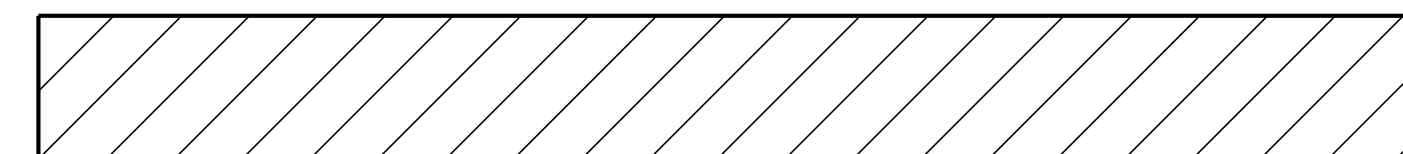

**NOT TO SCALE**

<b>INTERCHANGE          DETAIL          SHEET # 1</b>	PROJECT NAME: STATEWIDE	PLOT DATE: 10-OCT-2012 11:30
	PROJECT NUMBER: STP CRAK(29)	DRAWN BY: LOCKE
	FILE NAME: pi0k430.dgn PROJECT LEADER: FOWLER DESIGNED BY: LOCKE pi0k430int1.i	CHECKED BY: PAVT MGMT SHEET 6 OF 12