


RAMPS REQUIRING CRACK SEALING

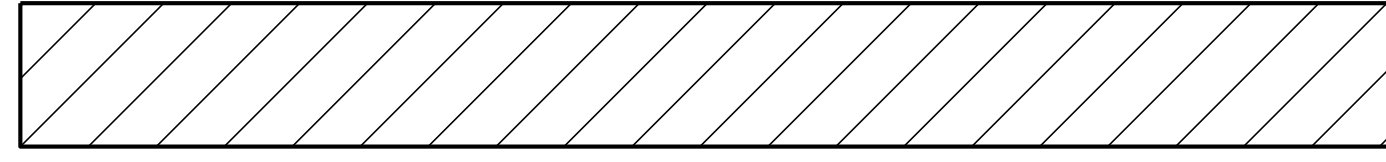

**HIGHGATE INTERCHANGE #22**  
**I-89**

**NOT TO SCALE**

<b>INTERCHANGE DETAIL SHEET # 5</b>	PROJECT NAME: STATEWIDE		PLOT DATE: 10-OCT-2012 11:31
	PROJECT NUMBER: STP CRAK(29)		DRAWN BY: LOCKE
	FILE NAME: p10k430.dgn	DESIGNED BY: LOCKE	CHECKED BY: PAVT MGMT
		p10k430in+5.i	SHEET 10 OF 12