



STATE OF VERMONT AGENCY OF TRANSPORTATION

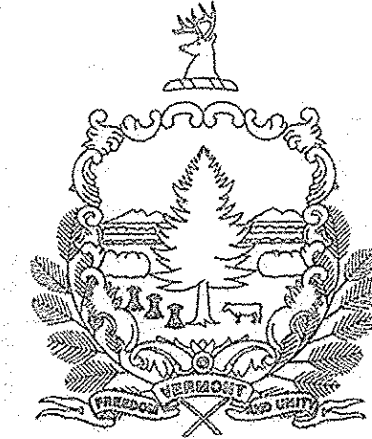

PROPOSED IMPROVEMENT BRIDGE PROJECT TOWN OF BRIDPORT COUNTY OF ADDISON VT ROUTE 125 (MAJOR COLLECTOR) BRIDGE NUMBERS 2 AND 5

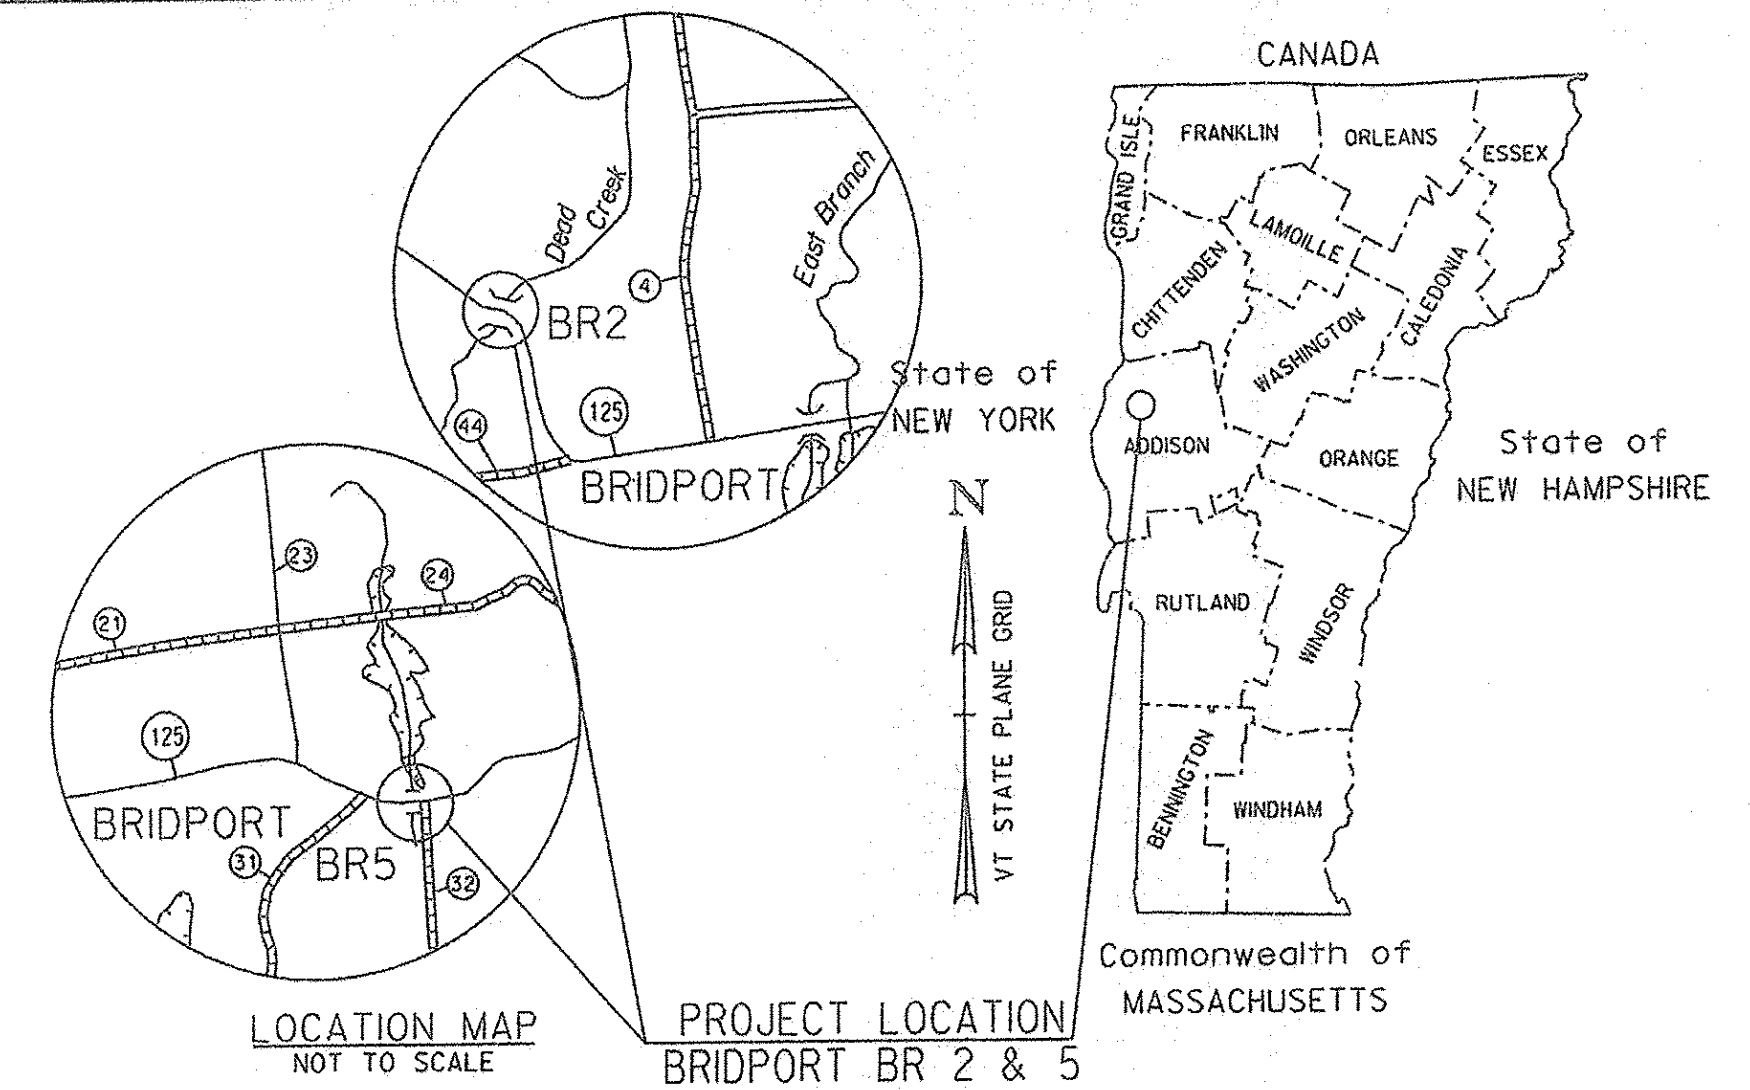



RECORD PLANS	
CONTRACTOR:	PECKHAM ROAD CORPORATION - WHITE PLAINS, NY
RESIDENT ENGINEER:	CHRIS LAVALETTE
CONSTRUCTION BEGAN:	MAY 21, 2015
CONSTRUCTION COMPLETE:	AUGUST 6, 2015
RECORD PLANS BY:	CHRIS LAVALETTE & AARON JAMES
I HEREBY CERTIFY THAT ALL THE CONSTRUCTION REQUIRED BY THIS SET OF DRAWINGS HAS BEEN ACCOMPLISHED AS INDICATED HEREIN.	
BY:	RESIDENT ENGINEER
DATE:	9/1/16
NOTE: Any further information concerning final quantities, amounts or other details relative to this project may be found at Central Files in the electronic archives.	

PROJECT LOCATION: BRIDGE NO. 2 IS LOCATED ON VERMONT ROUTE 125, 2.3 MILES WEST OF THE JUNCTION WITH VERMONT ROUTE 22A. BRIDGE NO. 5 IS LOCATED ON VERMONT ROUTE 125, 1.6 MILES EAST OF THE JUNCTION WITH VERMONT ROUTE 22A.

PROJECT DESCRIPTION: REPLACEMENT OF EXISTING CORRUGATED STEEL CULVERTS WITH PRECAST CONCRETE STRUCTURES ALONG WITH RELATED ROADWAY AND CHANNEL WORK.


LENGTH OF PROJECT: BRIDGE 2: 140 FEET
BRIDGE 5: 80 FEET

TOTAL PROJECT LENGTH: 220 FEET

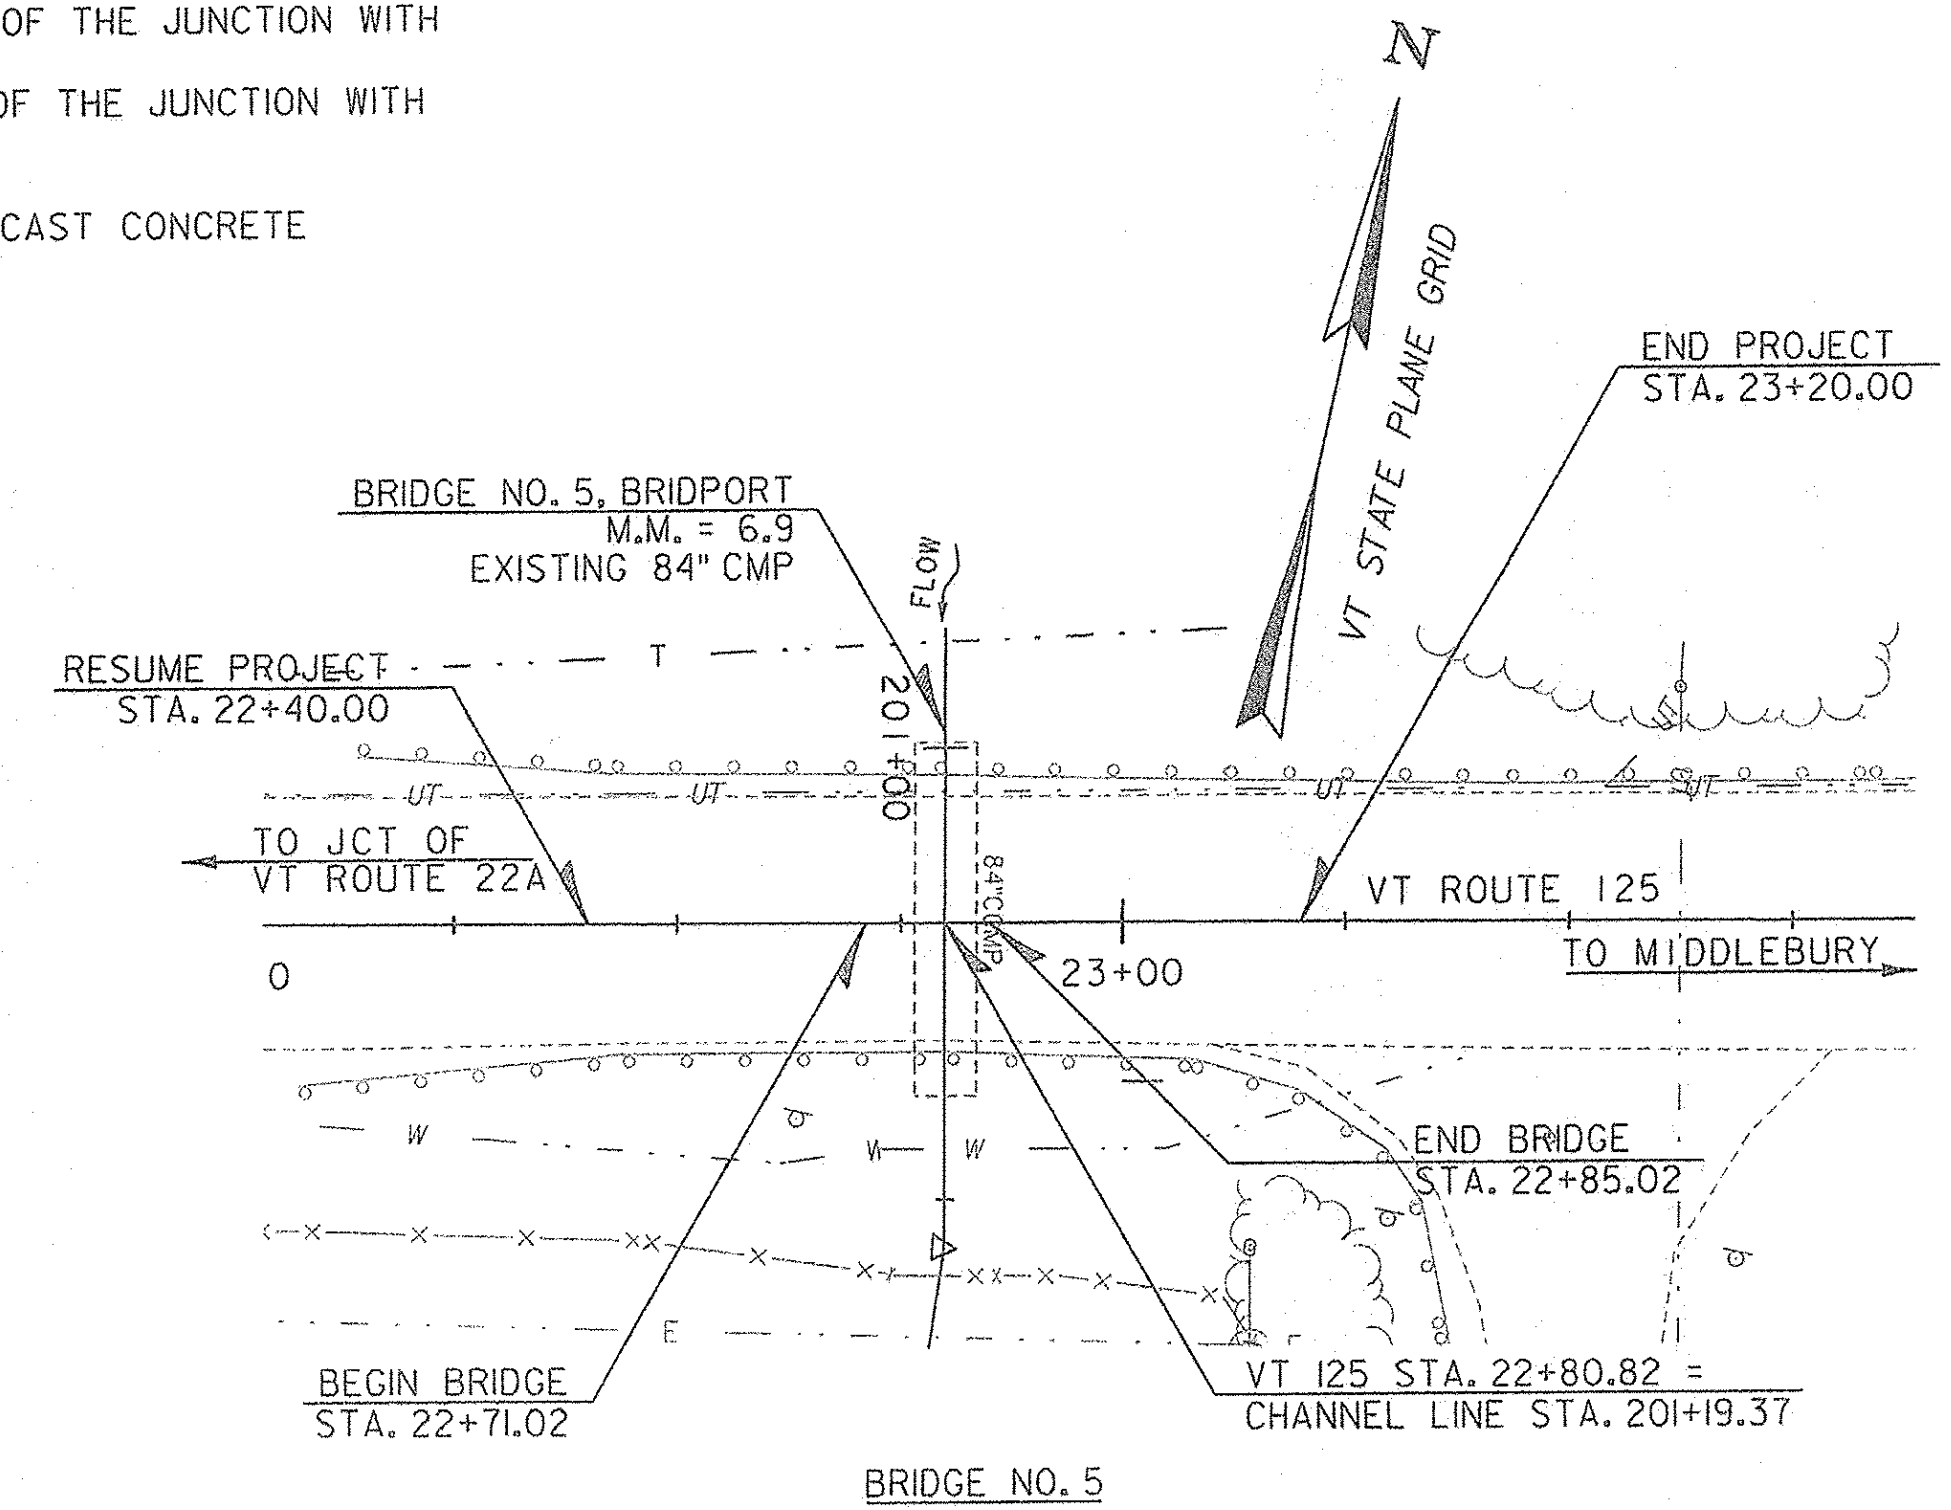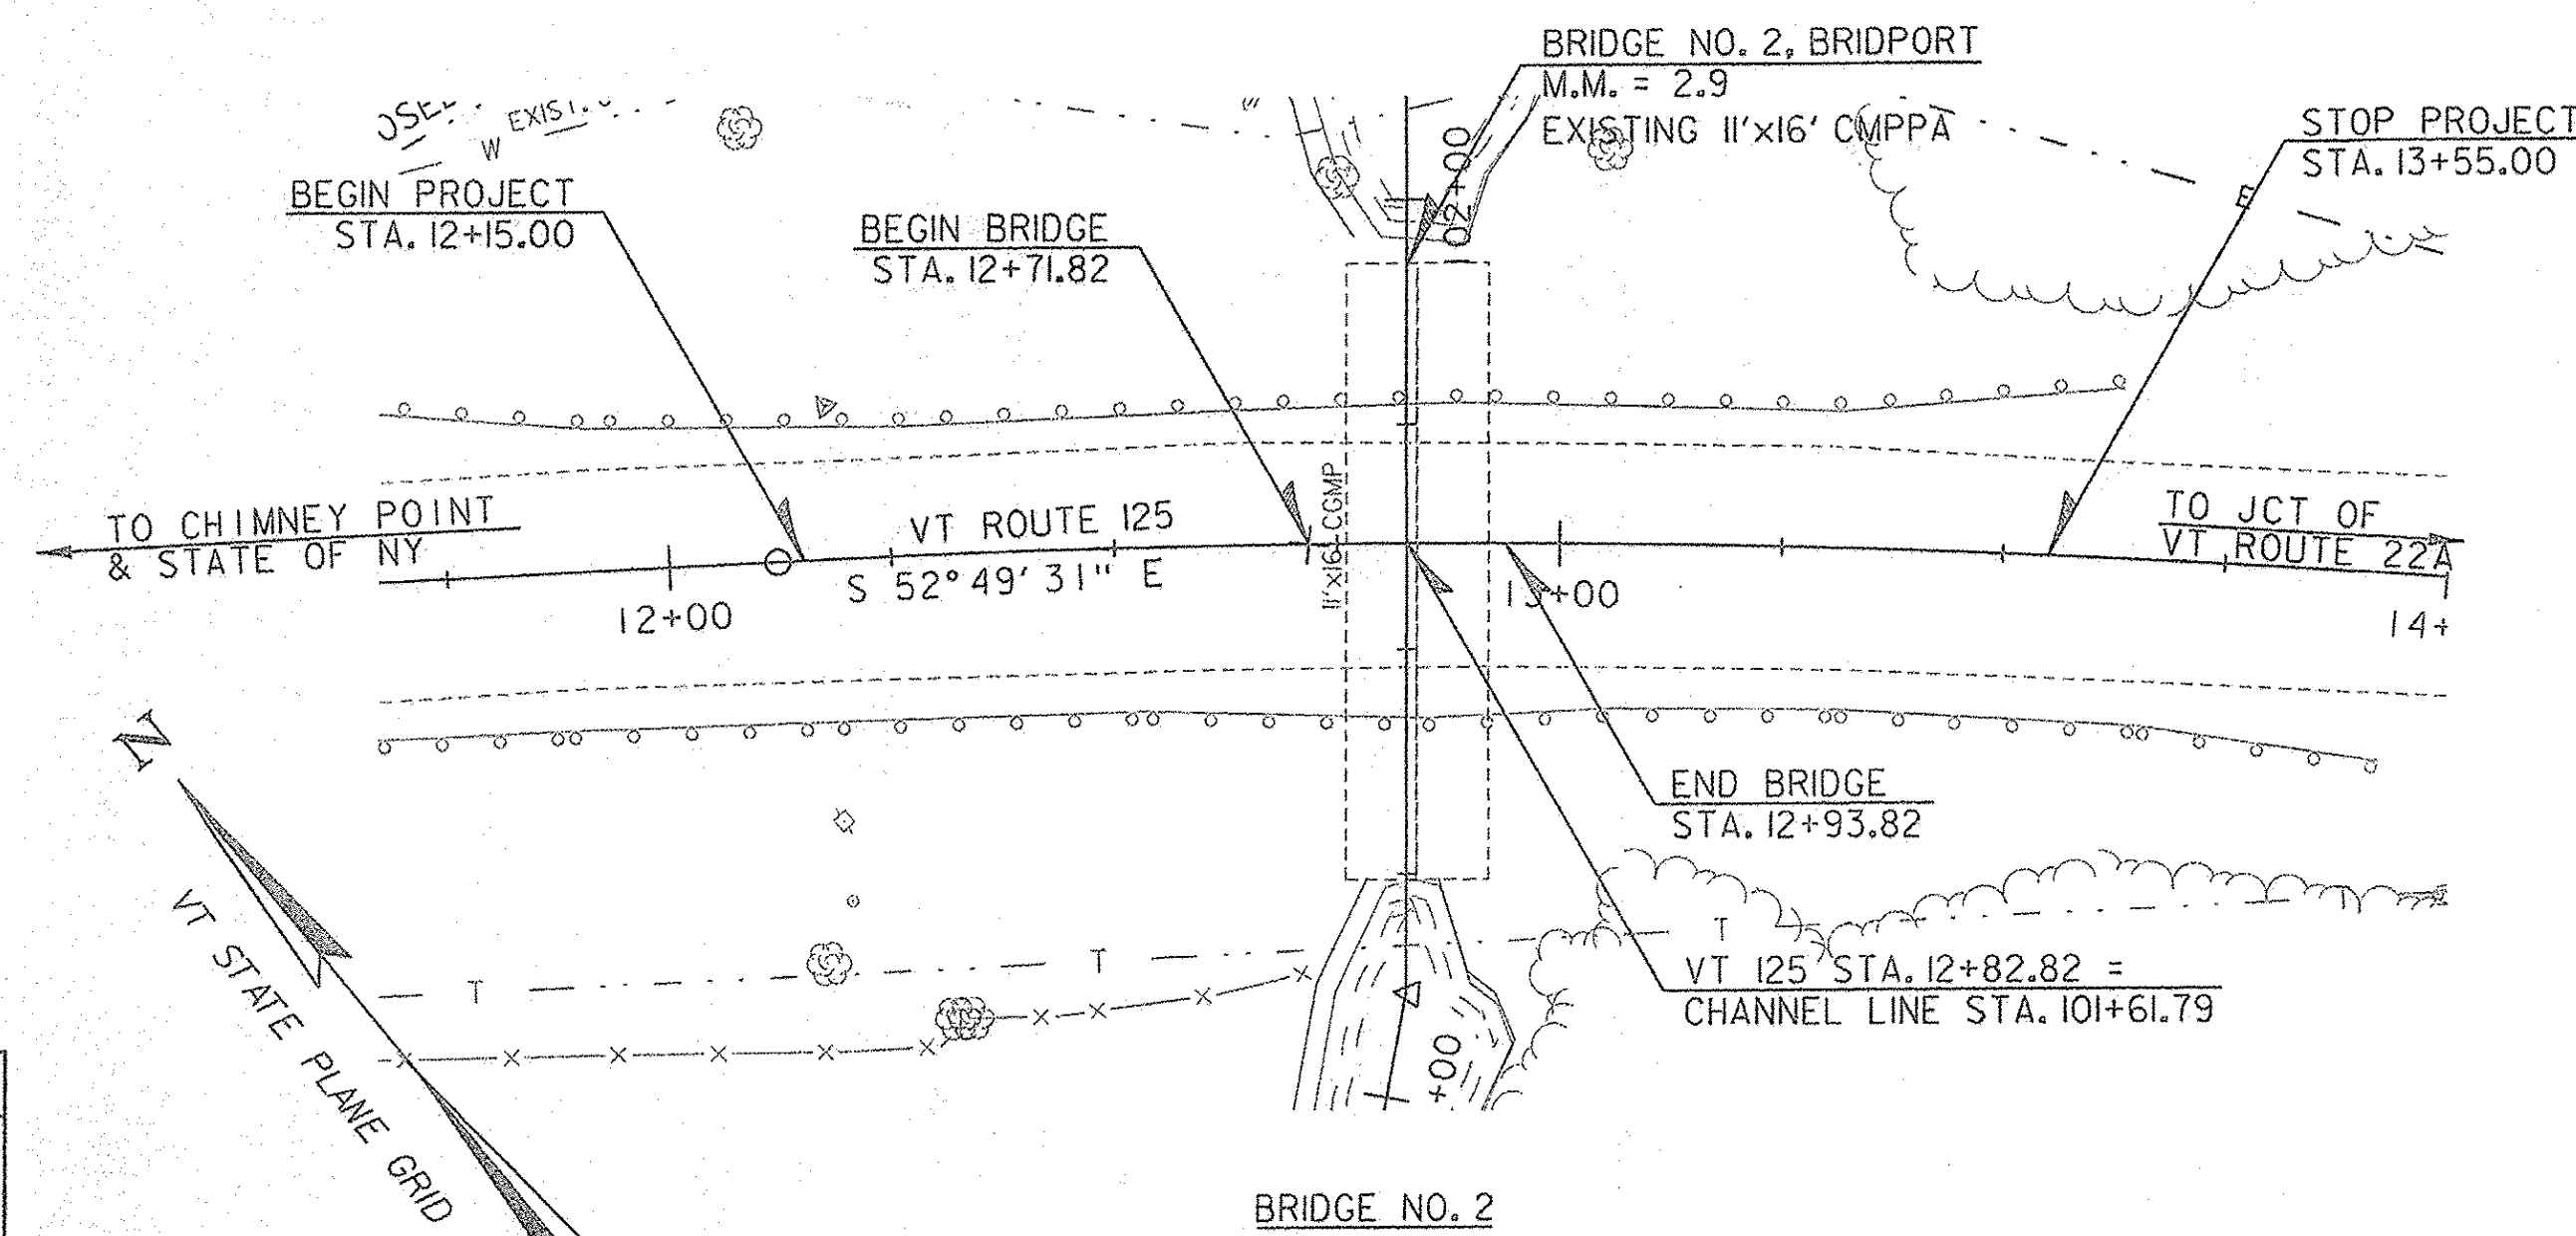

CONSTRUCTION IS TO BE CARRIED ON IN ACCORDANCE WITH THESE PLANS AND THE STANDARD SPECIFICATIONS FOR CONSTRUCTION DATED 2011, AS APPROVED BY THE FEDERAL HIGHWAY ADMINISTRATION ON JULY 20, 2011 FOR USE ON THIS PROJECT, INCLUDING ALL SUBSEQUENT REVISIONS AND SUCH REVISED SPECIFICATIONS AND SPECIAL PROVISIONS AS ARE INCORPORATED IN THESE PLANS.

QUALITY ASSURANCE PROGRAM : LEVEL 2	
SURVEYED BY : VTRANS	
SURVEYED DATE : FEBRUARY 2012	
DATUM	
VERTICAL	(SEE SURVEY CONTROL AND TIE SHEETS)
HORIZONTAL	(SEE SURVEY CONTROL AND TIE SHEETS)

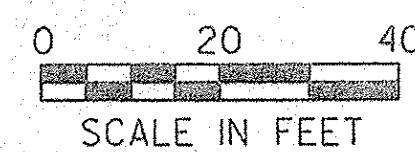

		DIRECTOR OF PROJECT DELIVERY APPROVED DATE 9/11/2014
	Stantec Consulting Services Inc. 55 Green Mountain Drive South Burlington VT U.S.A. 05403 Phone: (802) 864-0223 Fax: (802) 864-0165 www.stantec.com	PROJECT MANAGER : MARK SARGENT
	PROJECT NAME : BRIDPORT PROJECT NUMBER : STP CULV (29)	
	SHEET 1 OF 57 SHEETS	