



11+50

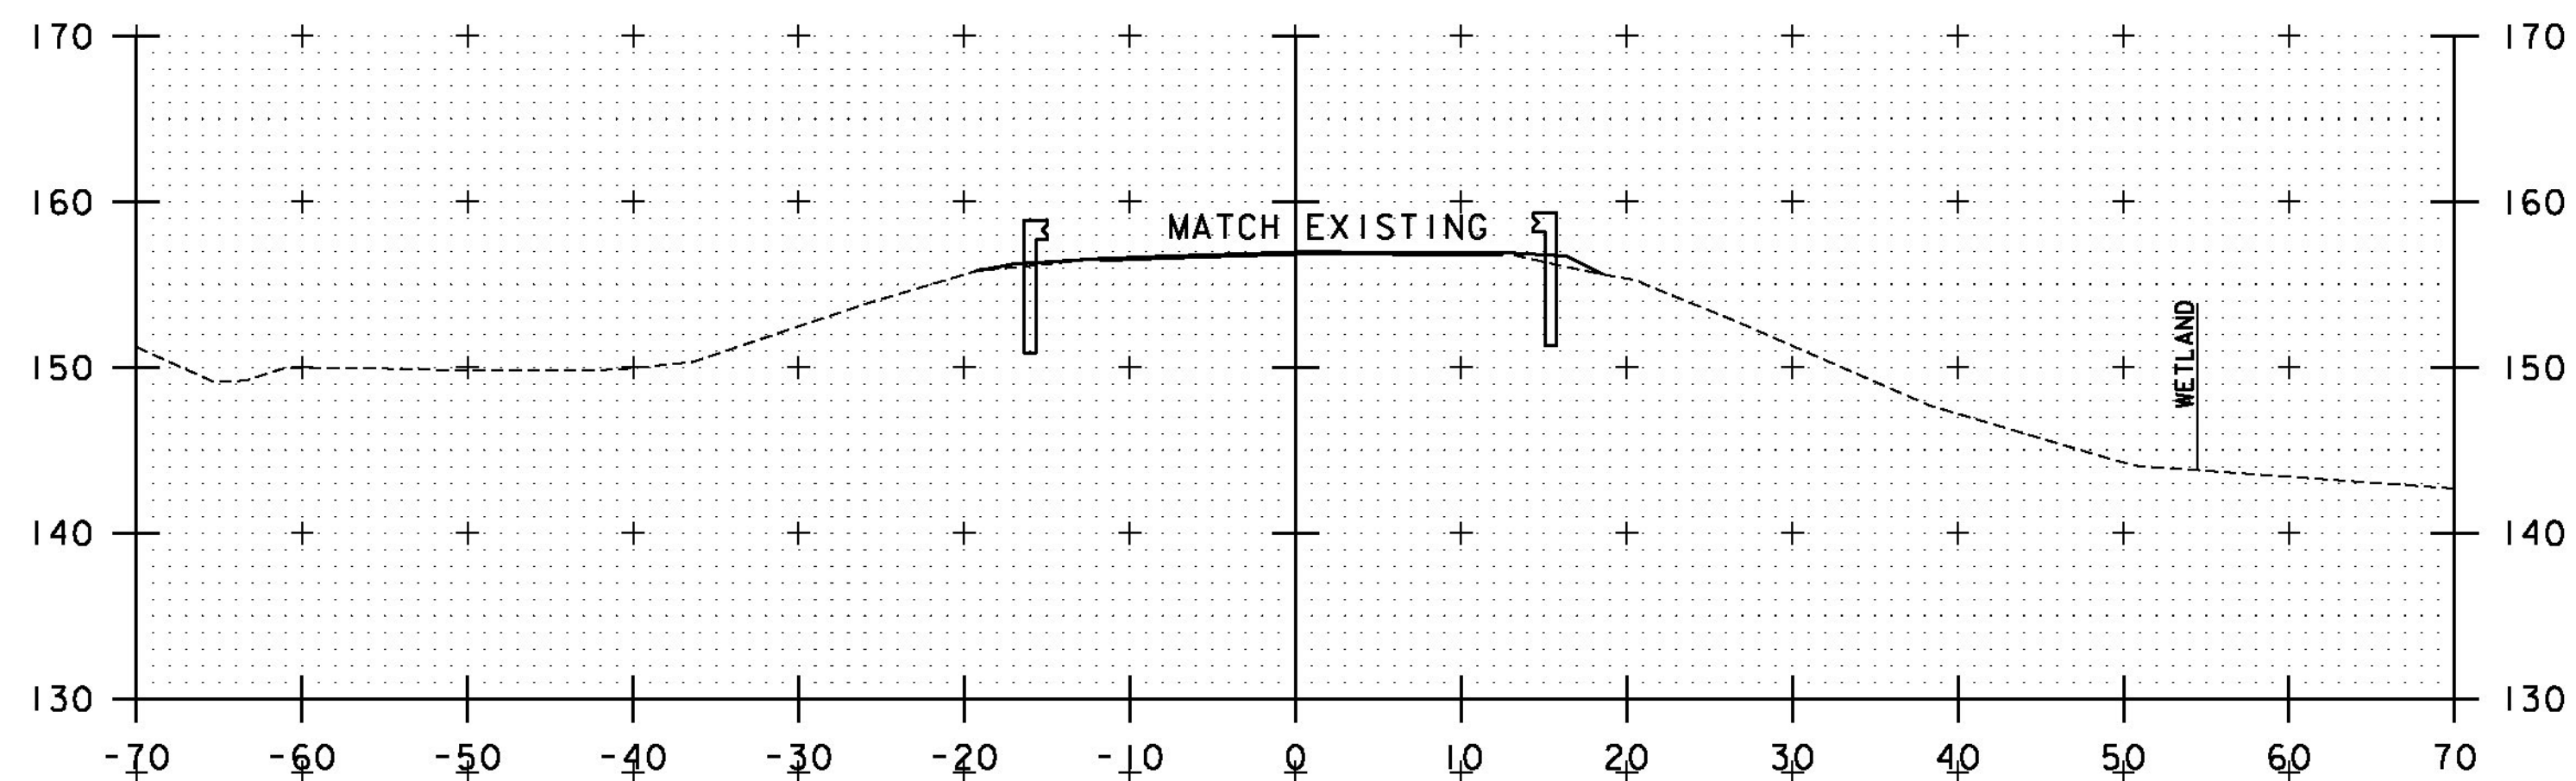


11+25

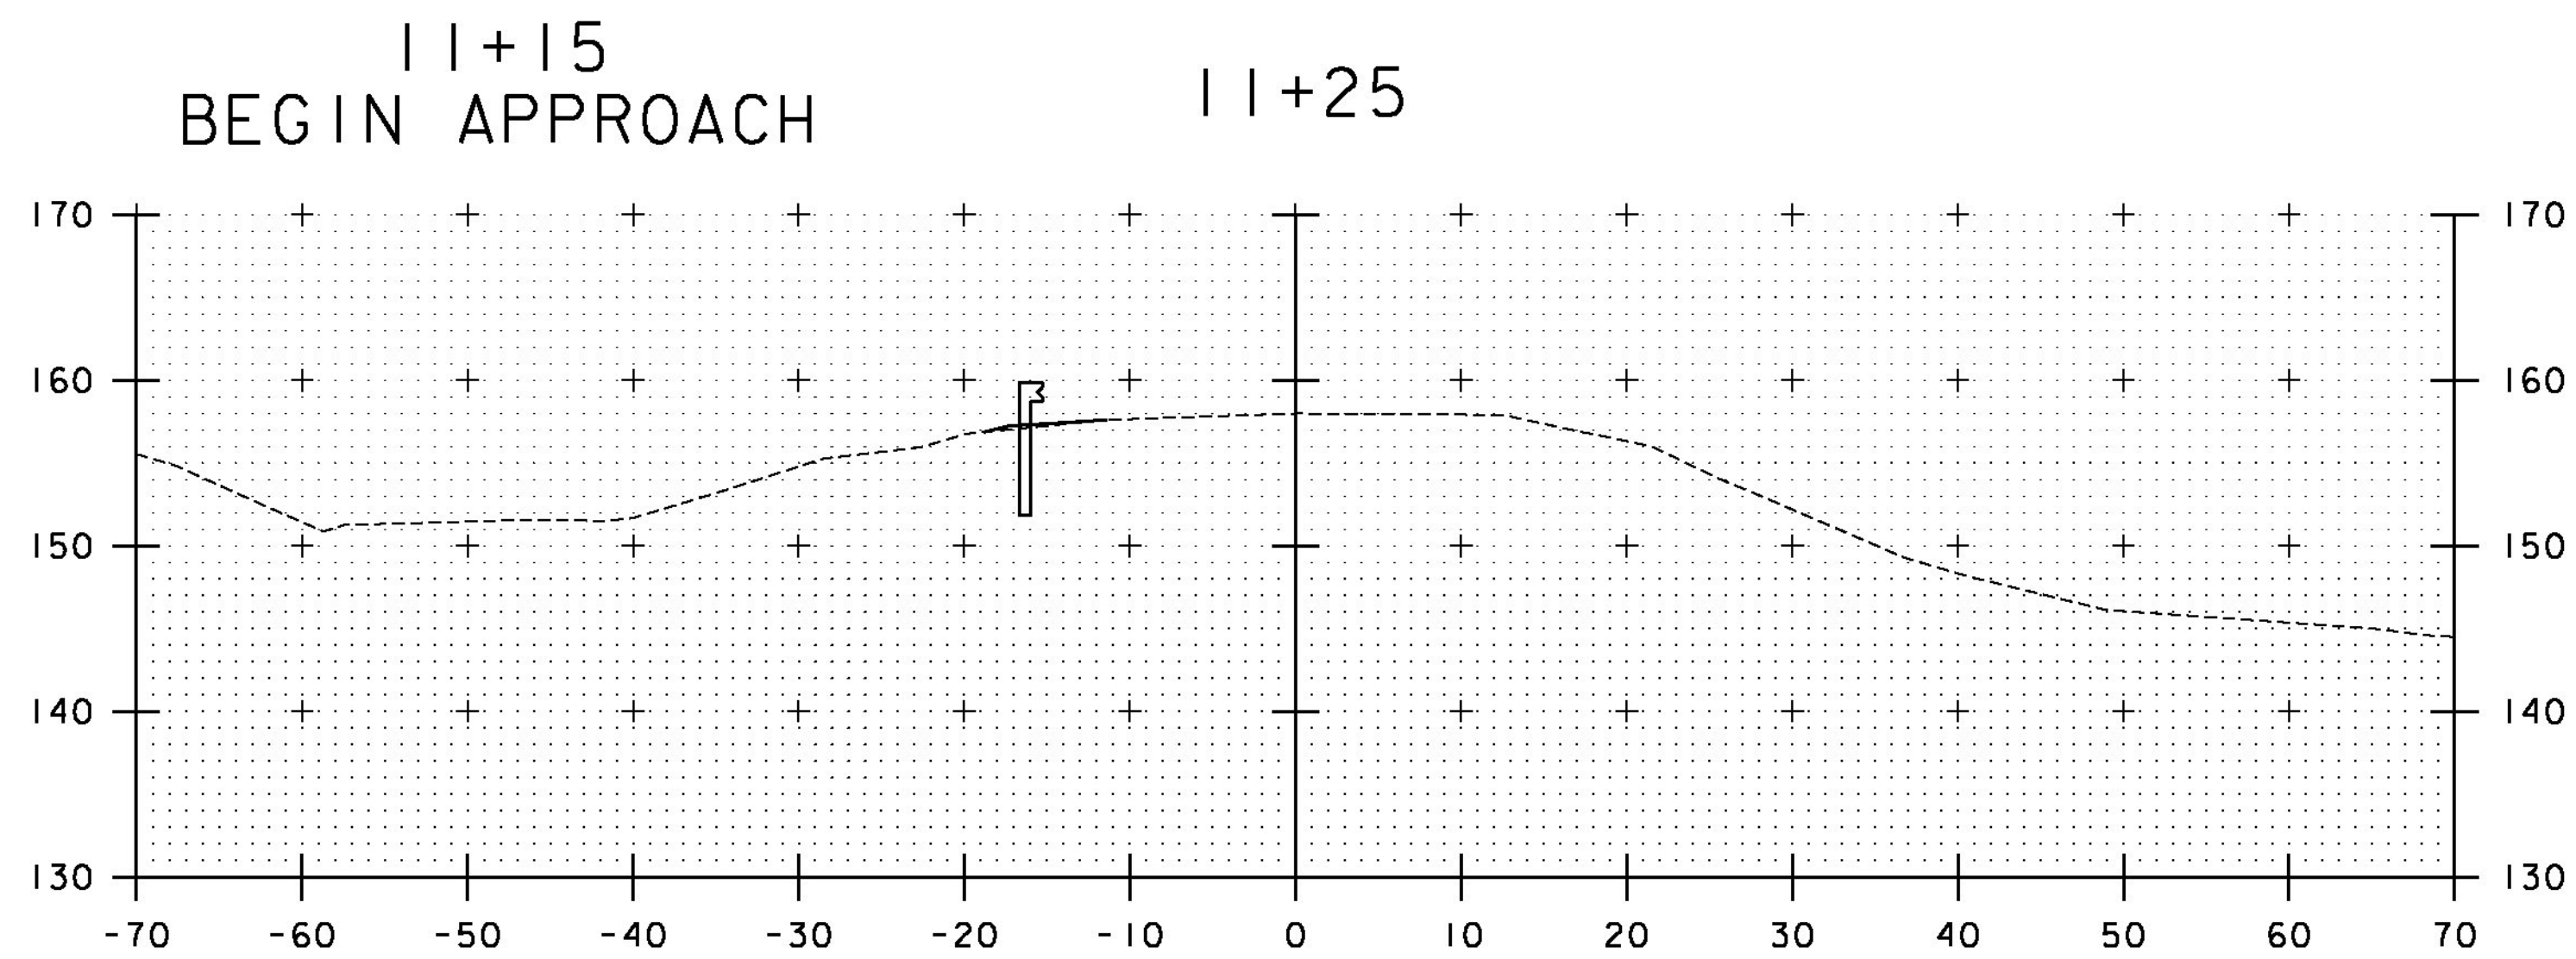


11+15
BEGIN APPROACH

11+00

12+15
BEGIN PROJECT

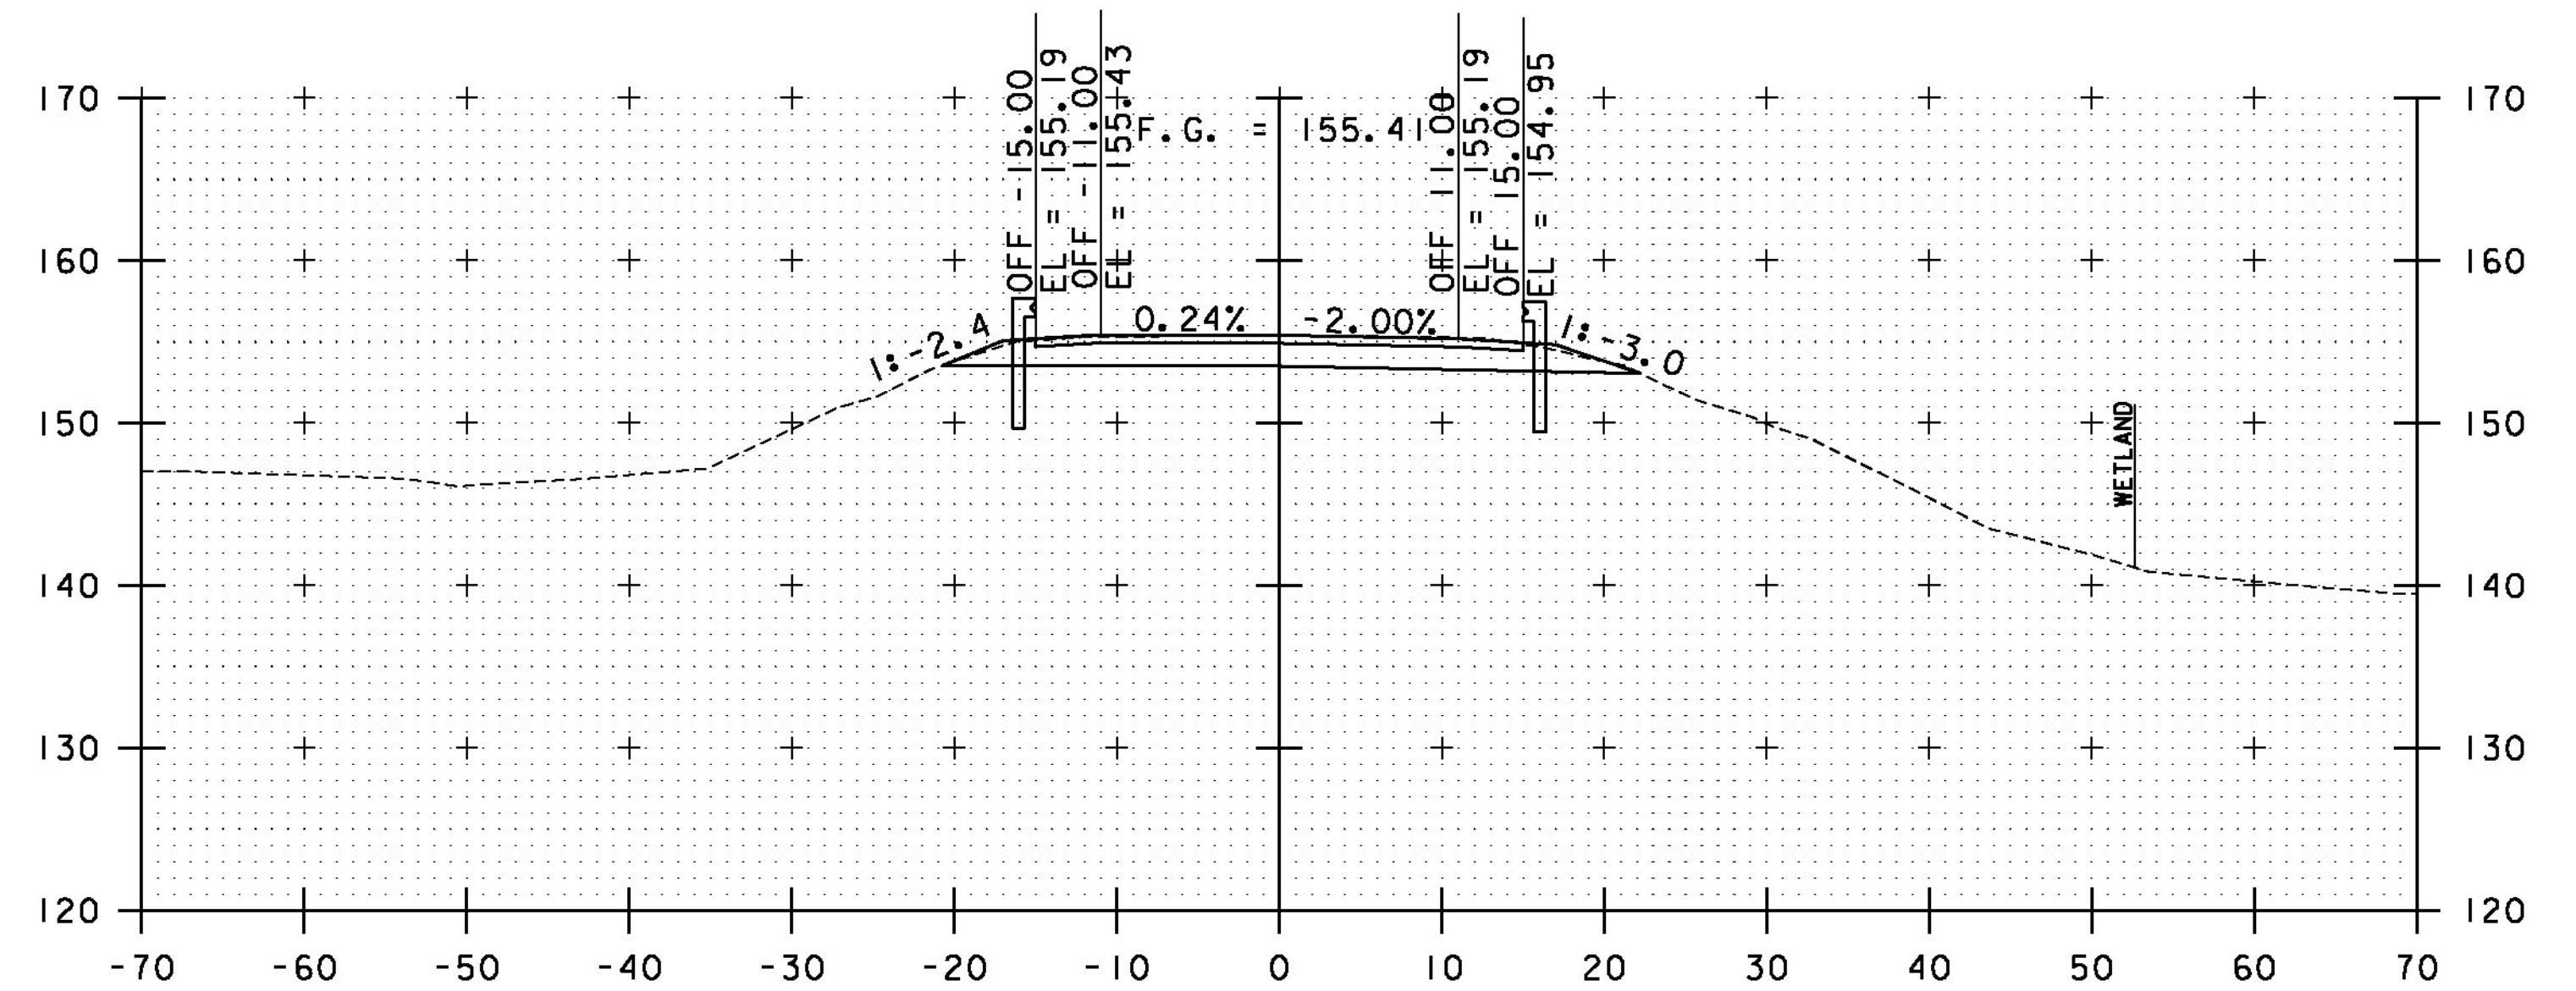

12+00

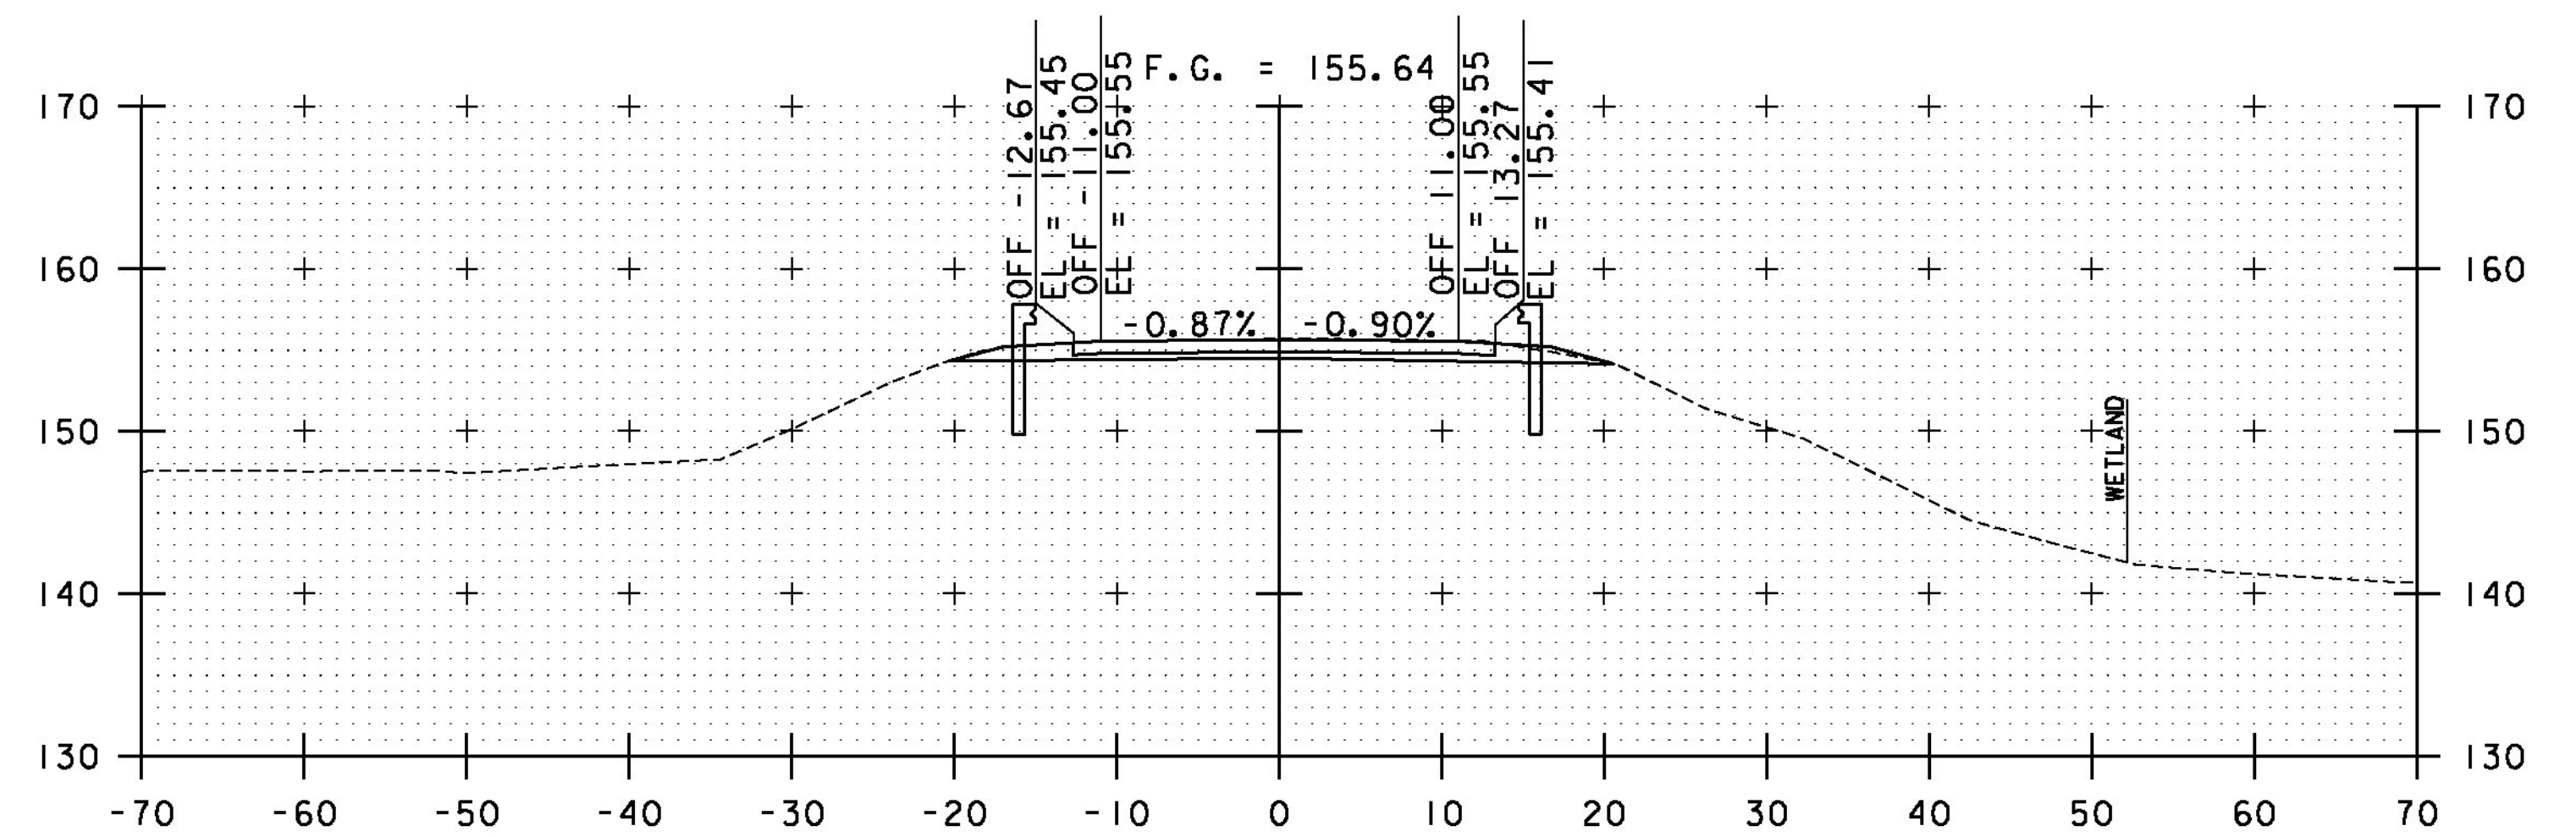

11+75

STA. 11+00 TO STA. 12+00

PROJECT NAME: BRIDPORT
PROJECT NUMBER: STP CULV(29)

FILE NAME: zllc264xs_br2.dgn
PROJECT LEADER: M. CHENETTE
DESIGNED BY: J. HUNGERFORD
ROADWAY CROSS SECTIONS - RXSI - BR2

PLOT DATE: 8/22/2014
DRAWN BY: L. BUXTON
CHECKED BY: M. CHENETTE
SHEET 24 OF 57

