

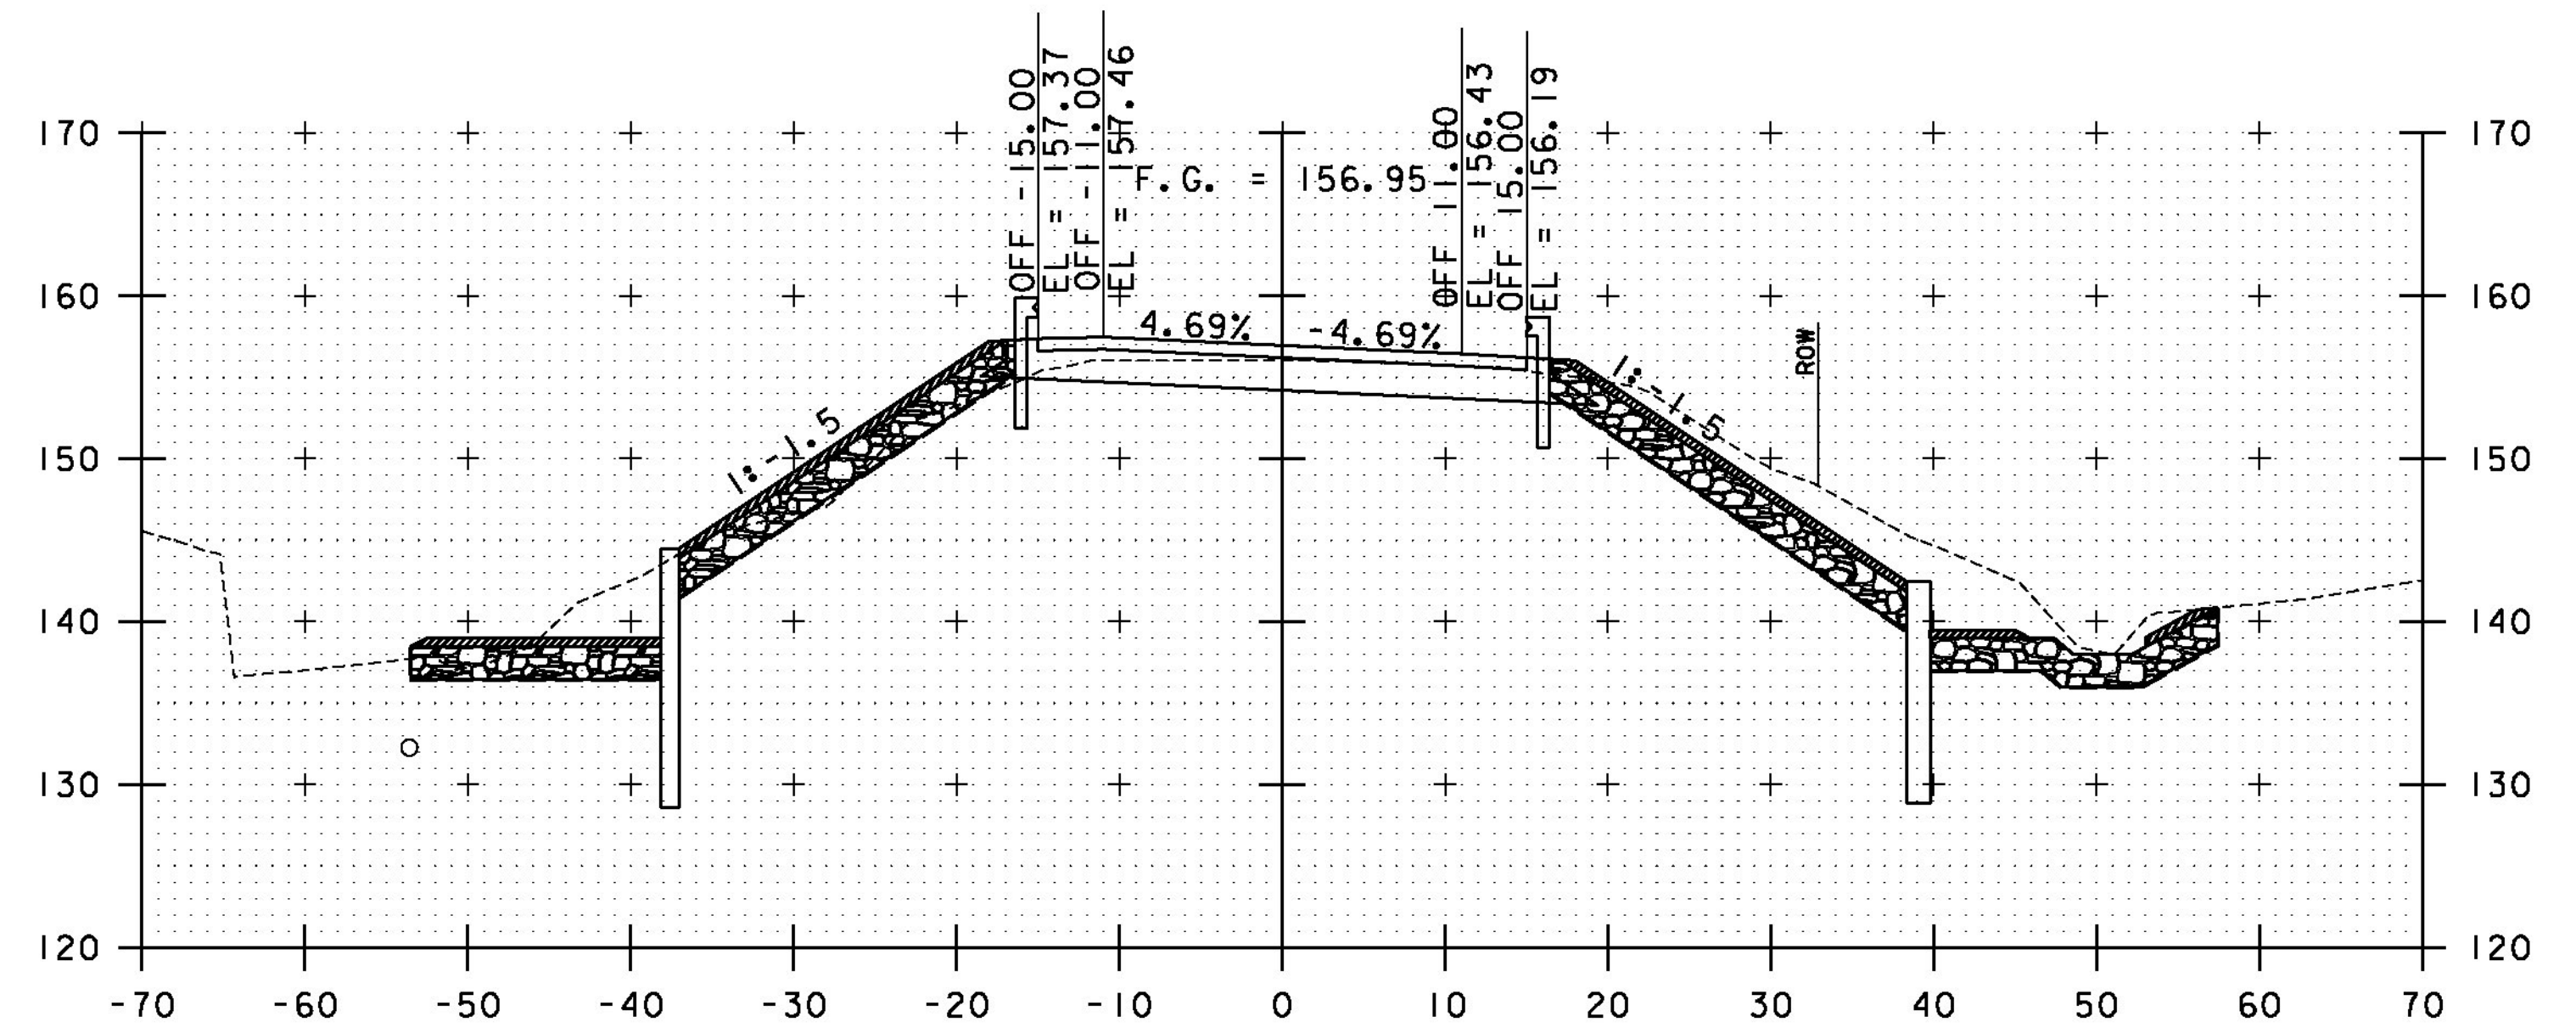



12+71.82
BEGIN BRIDGE

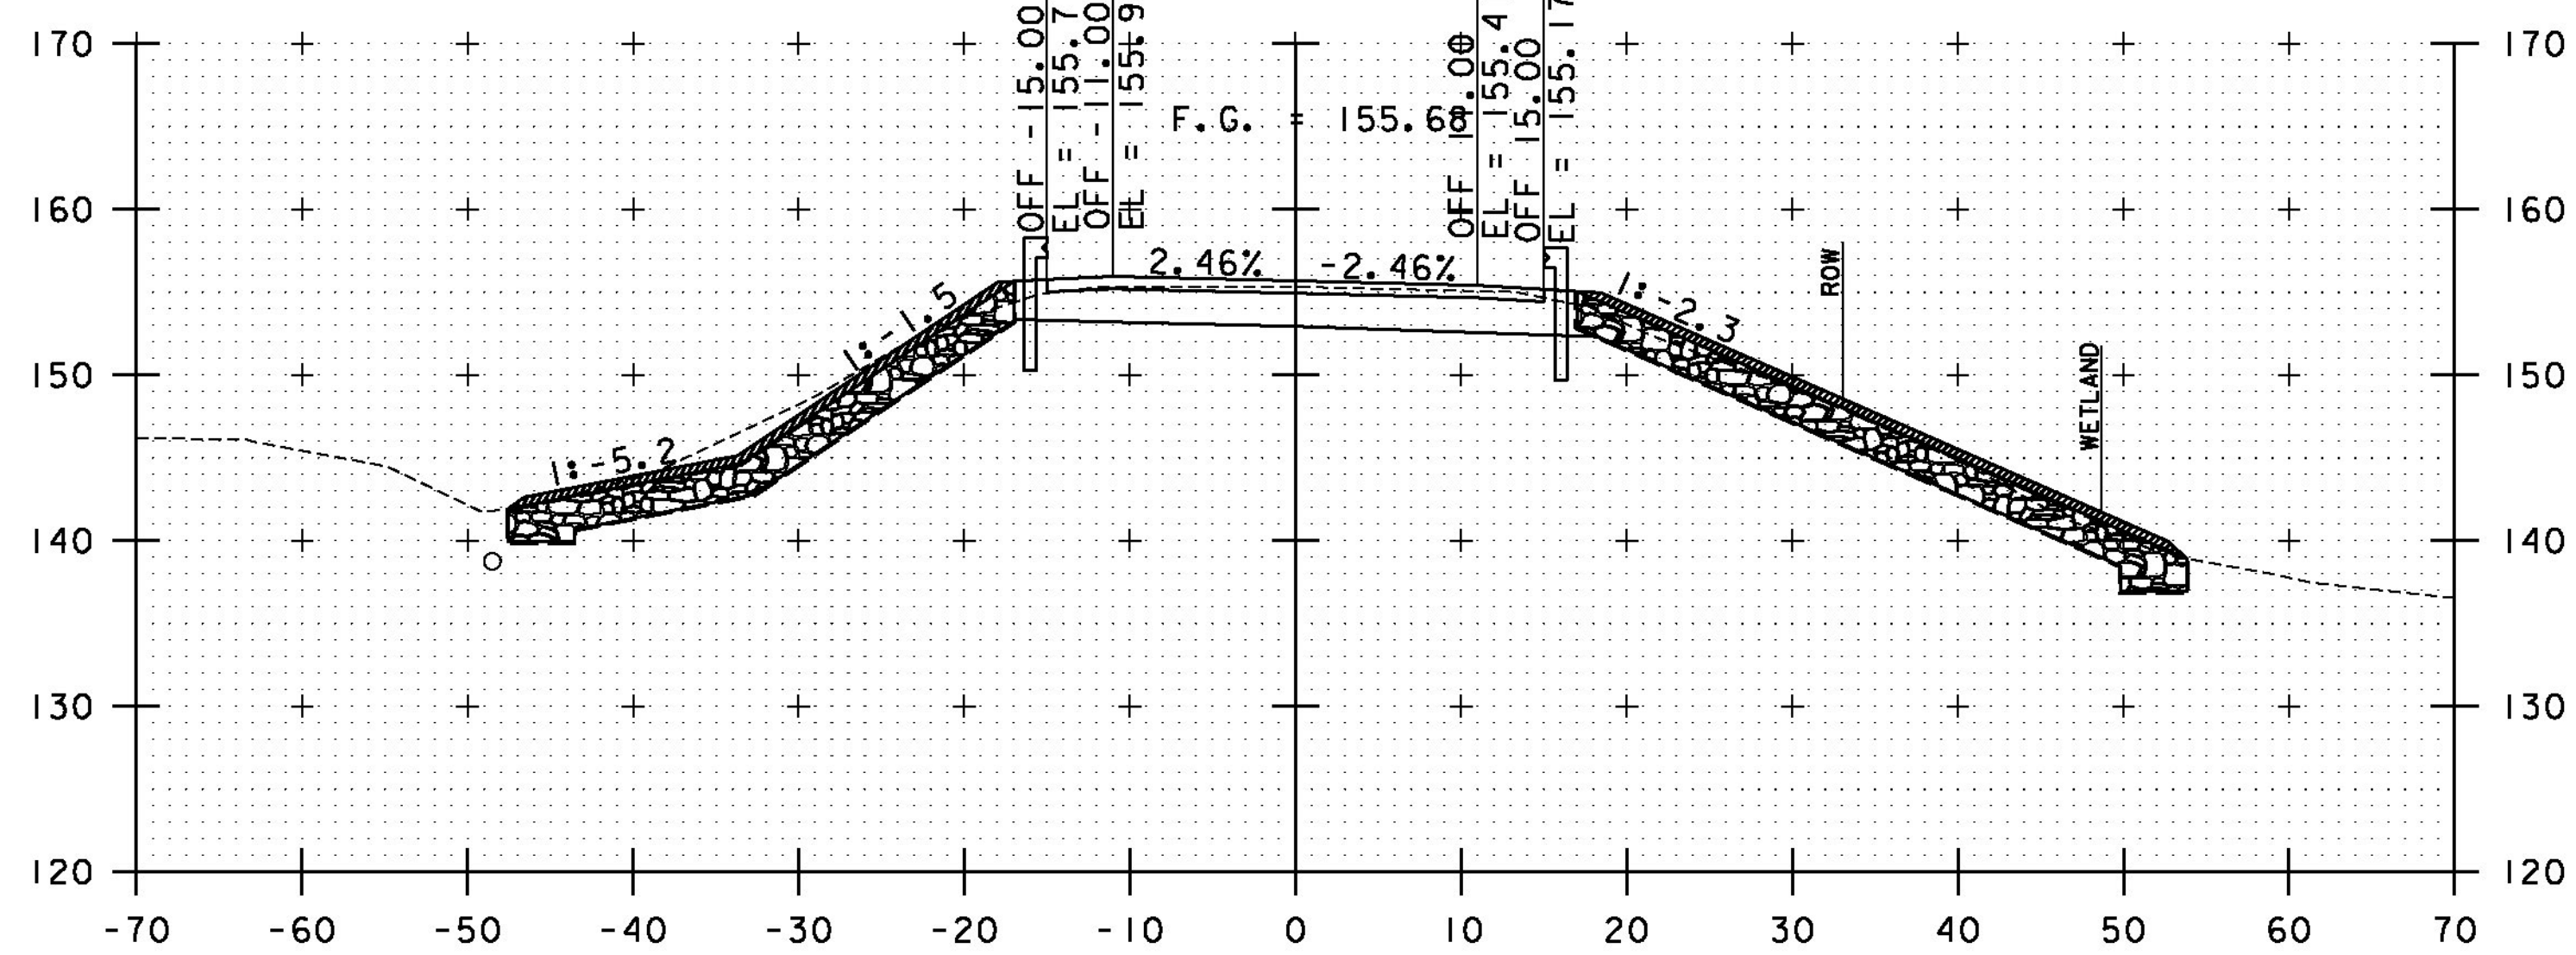

12+50

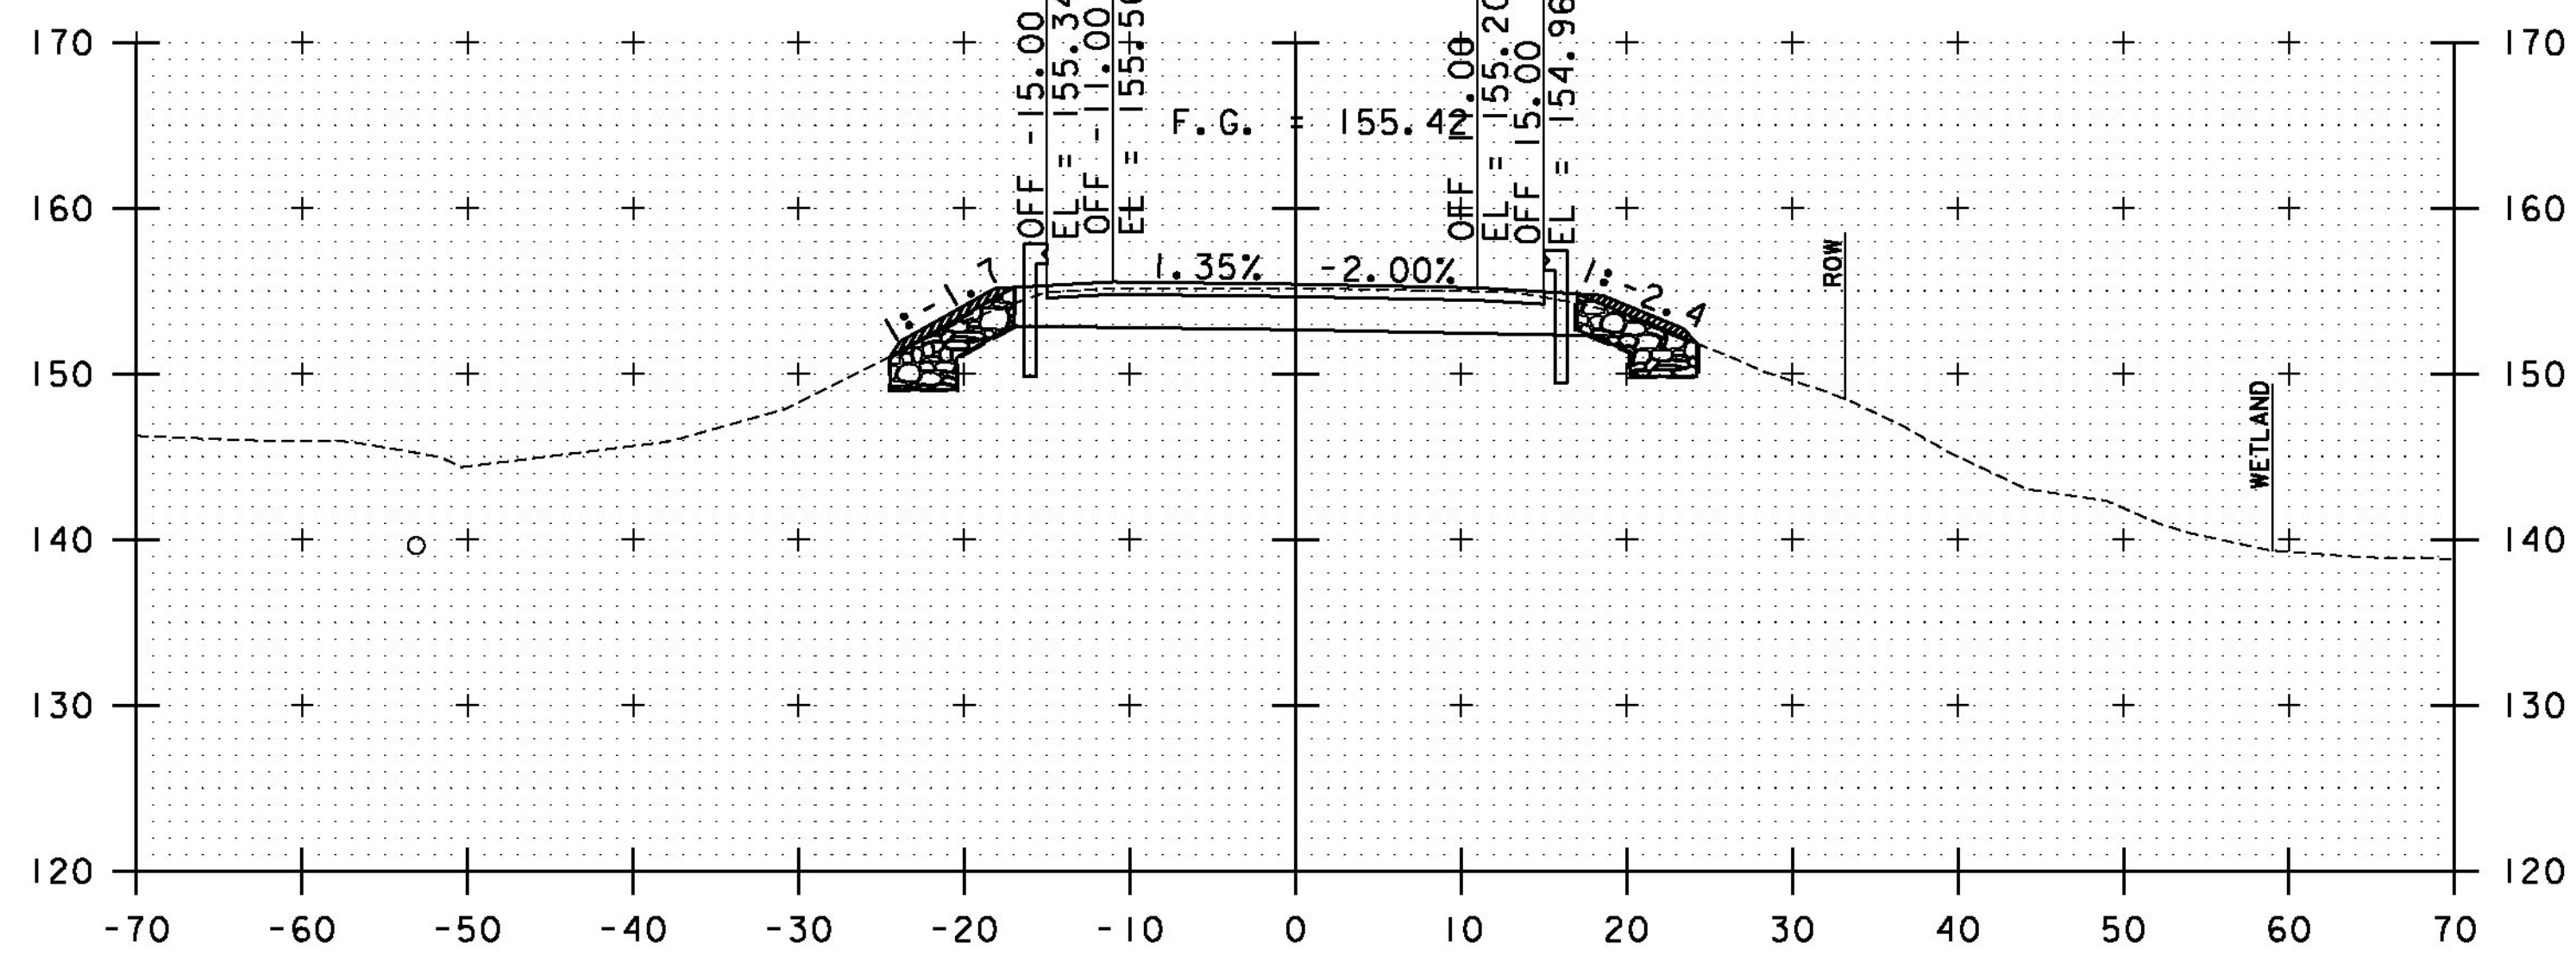

13+00
12+93.82
END BRIDGE

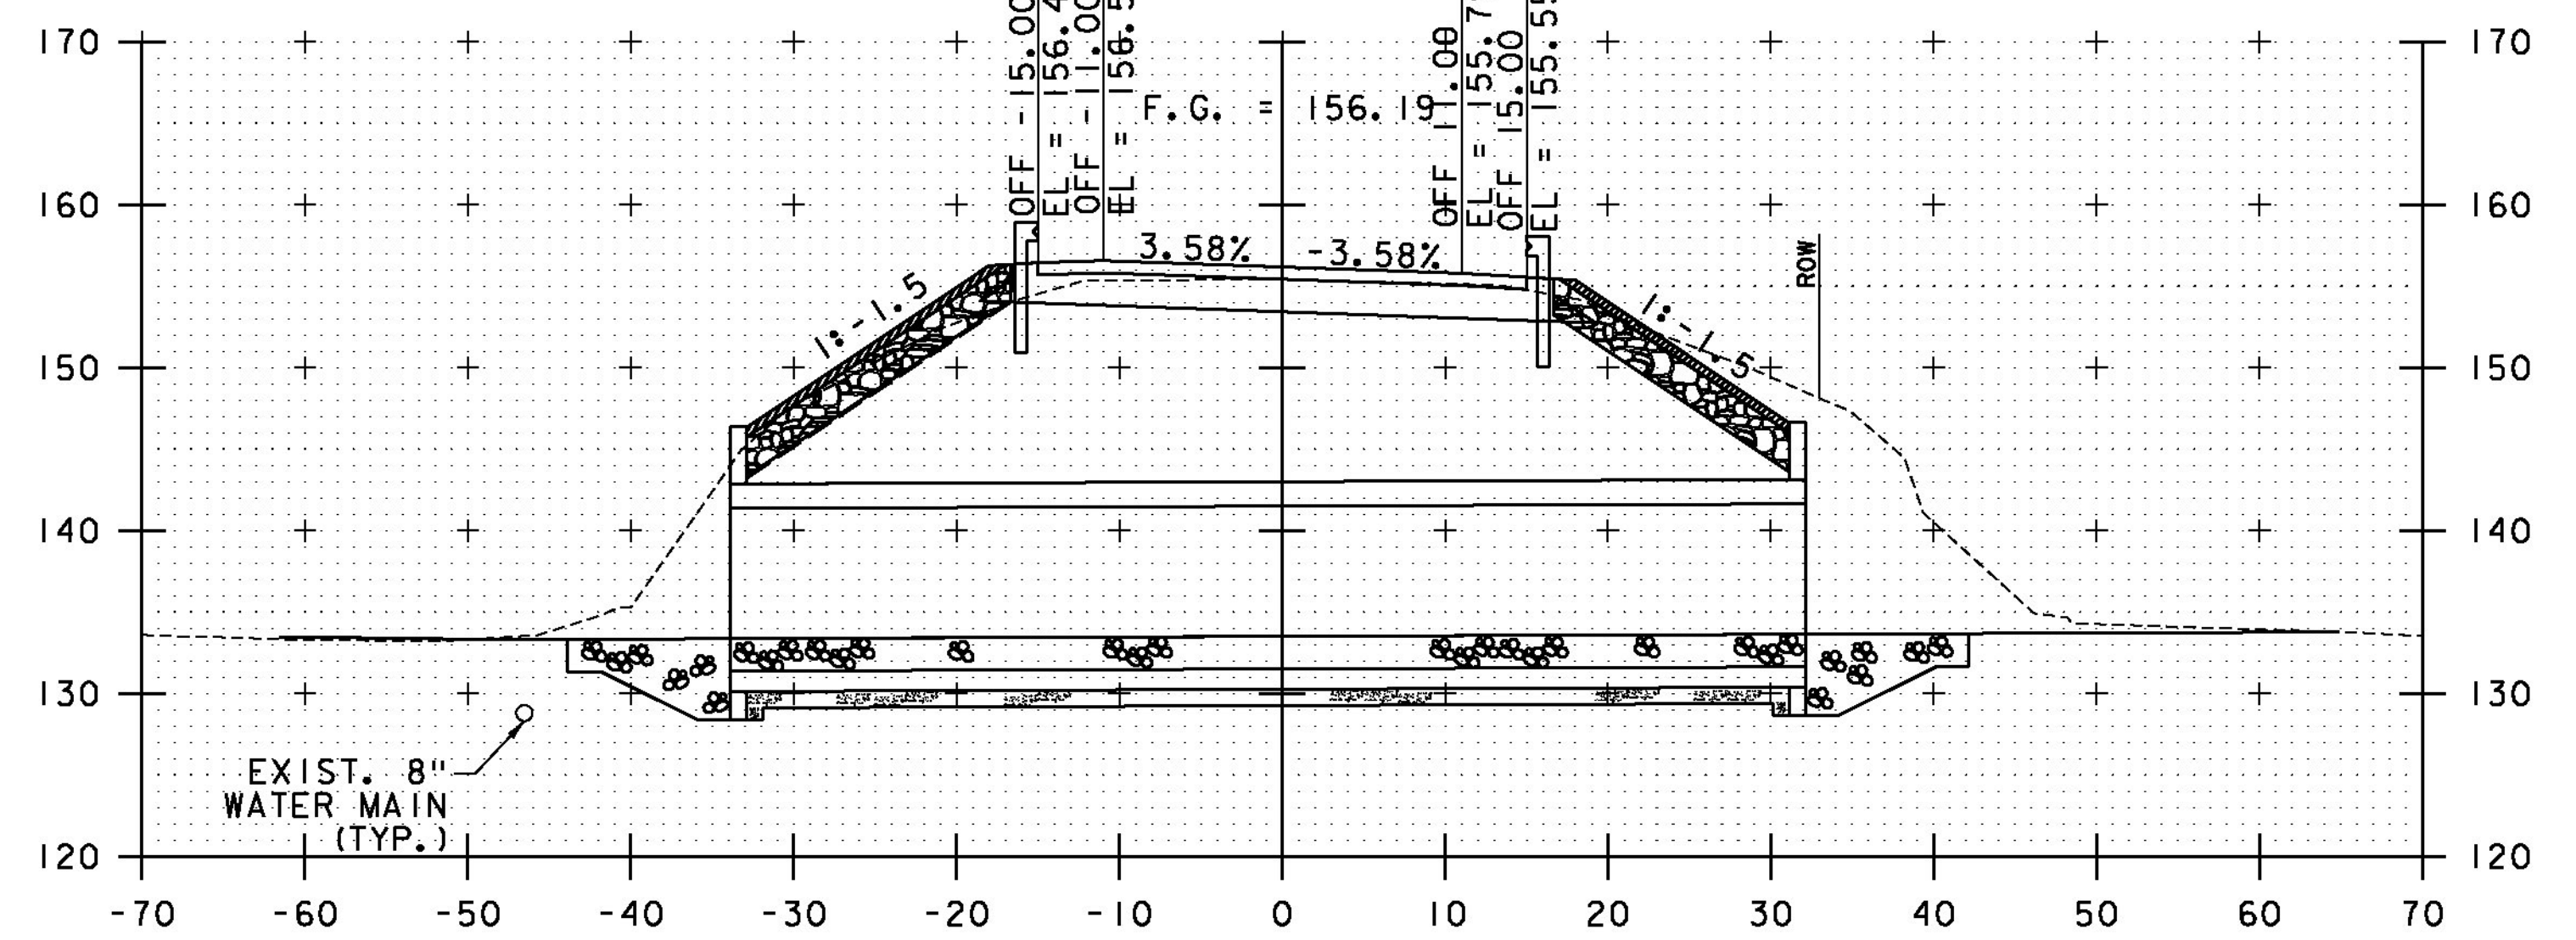

12+25

12+75

STA. 12+25 TO STA. 13+00

PROJECT NAME: BRIDPORT
PROJECT NUMBER: STP CULV(29)

FILE NAME: zllc264xs_br2.dgn
PROJECT LEADER: M. CHENETTE
DESIGNED BY: J. HUNGERFORD
ROADWAY CROSS SECTIONS - RXS2 - BR2

PLOT DATE: 8/22/2014
DRAWN BY: L. BUXTON
CHECKED BY: M. CHENETTE
SHEET 25 OF 57

