




13+55
END PROJECT

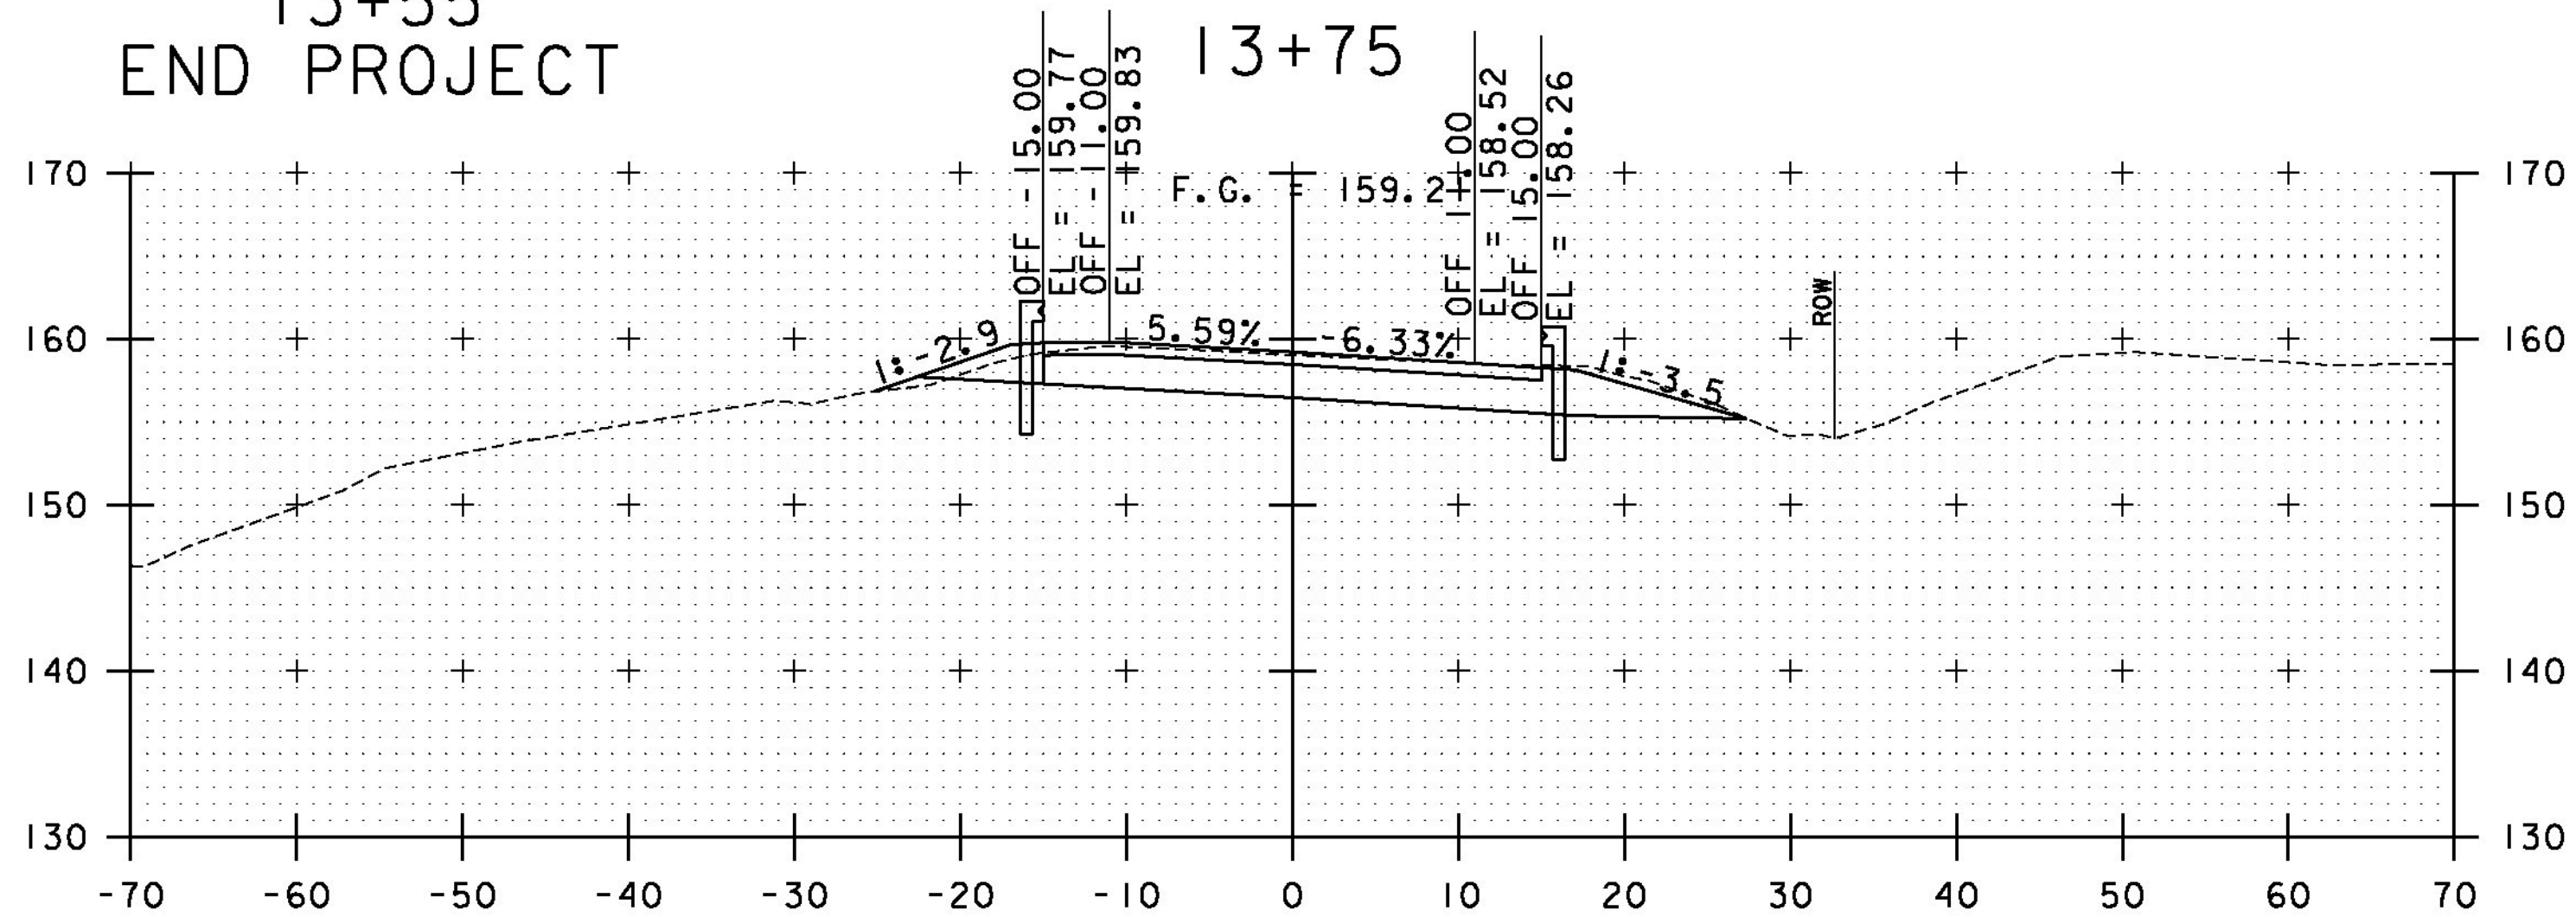


13+50

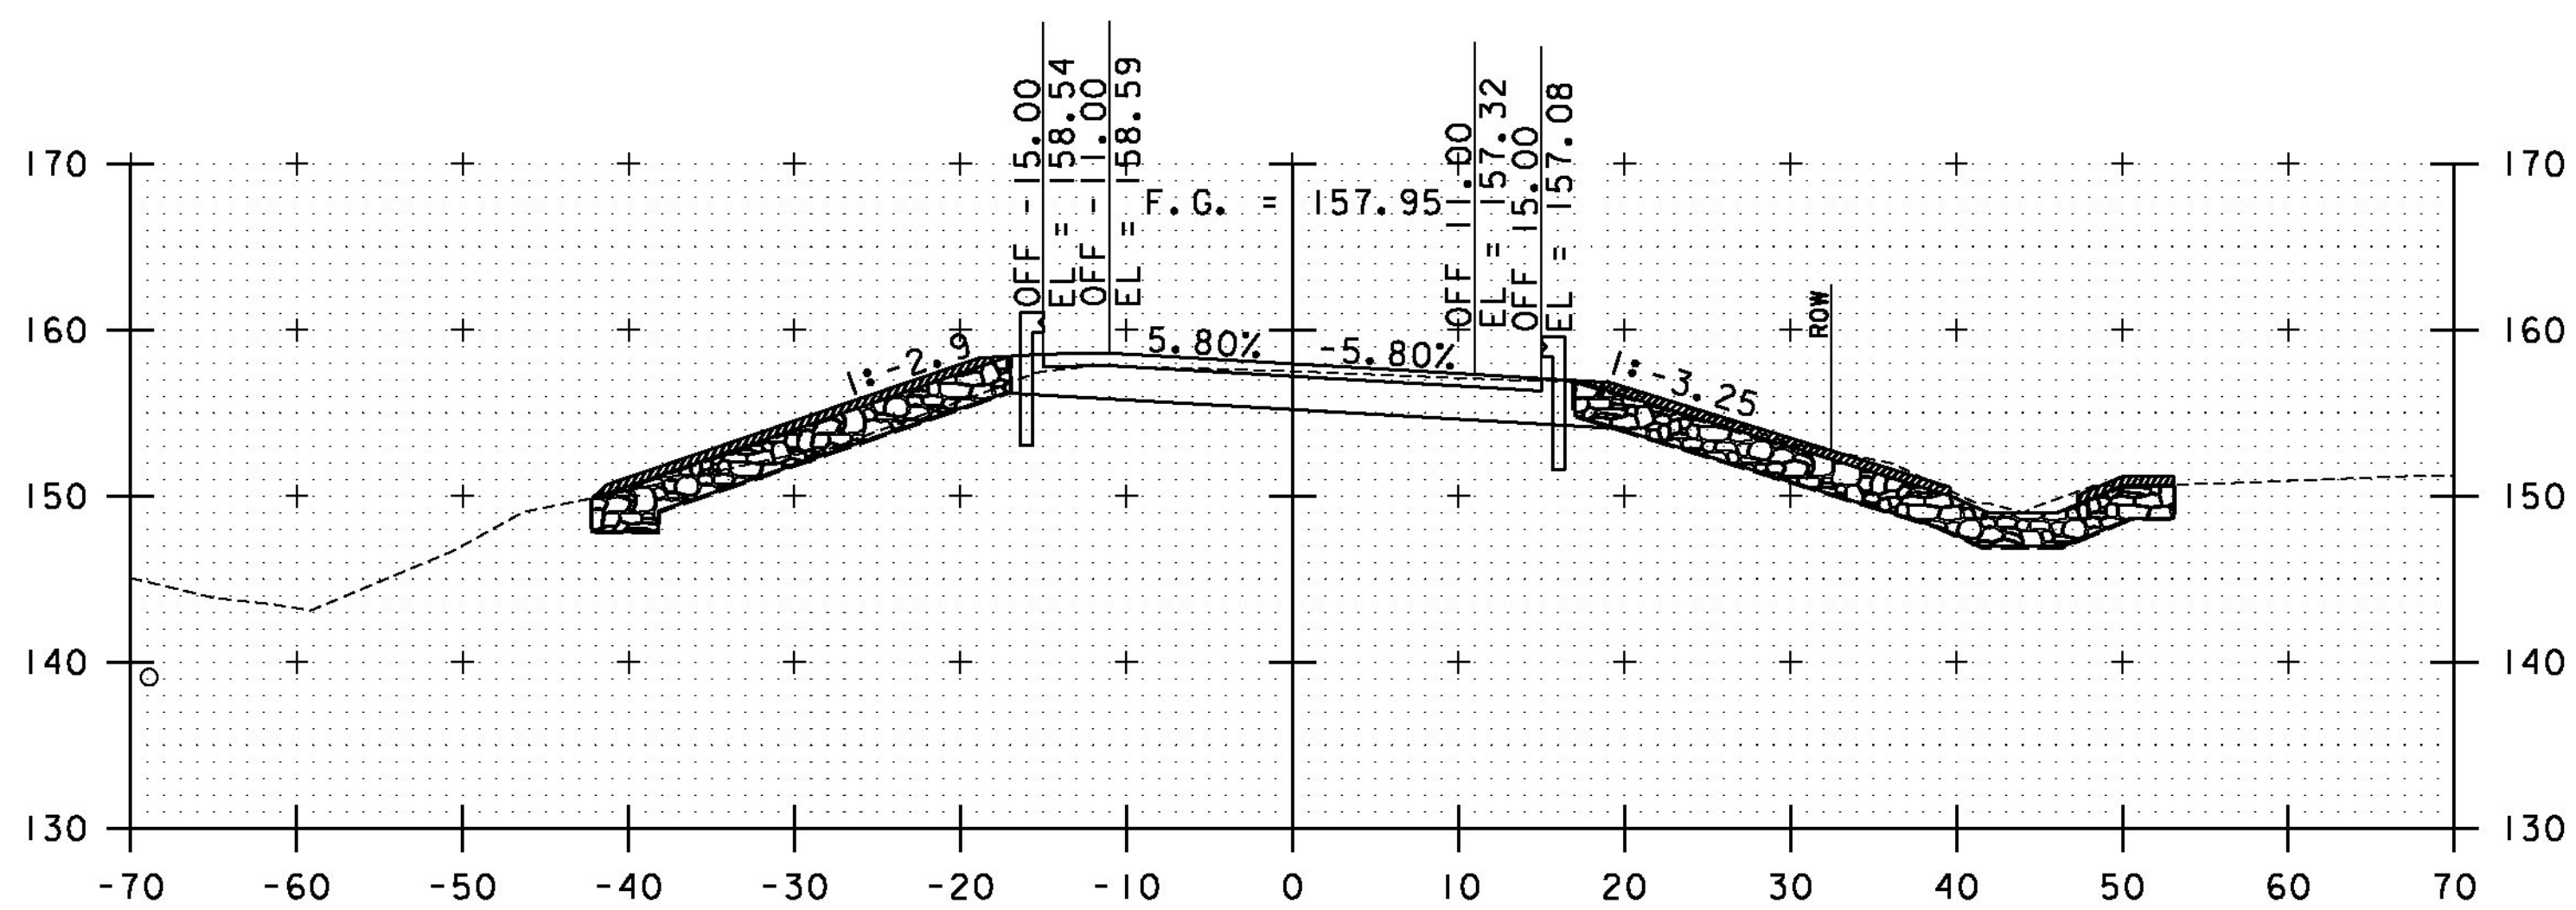

13+25

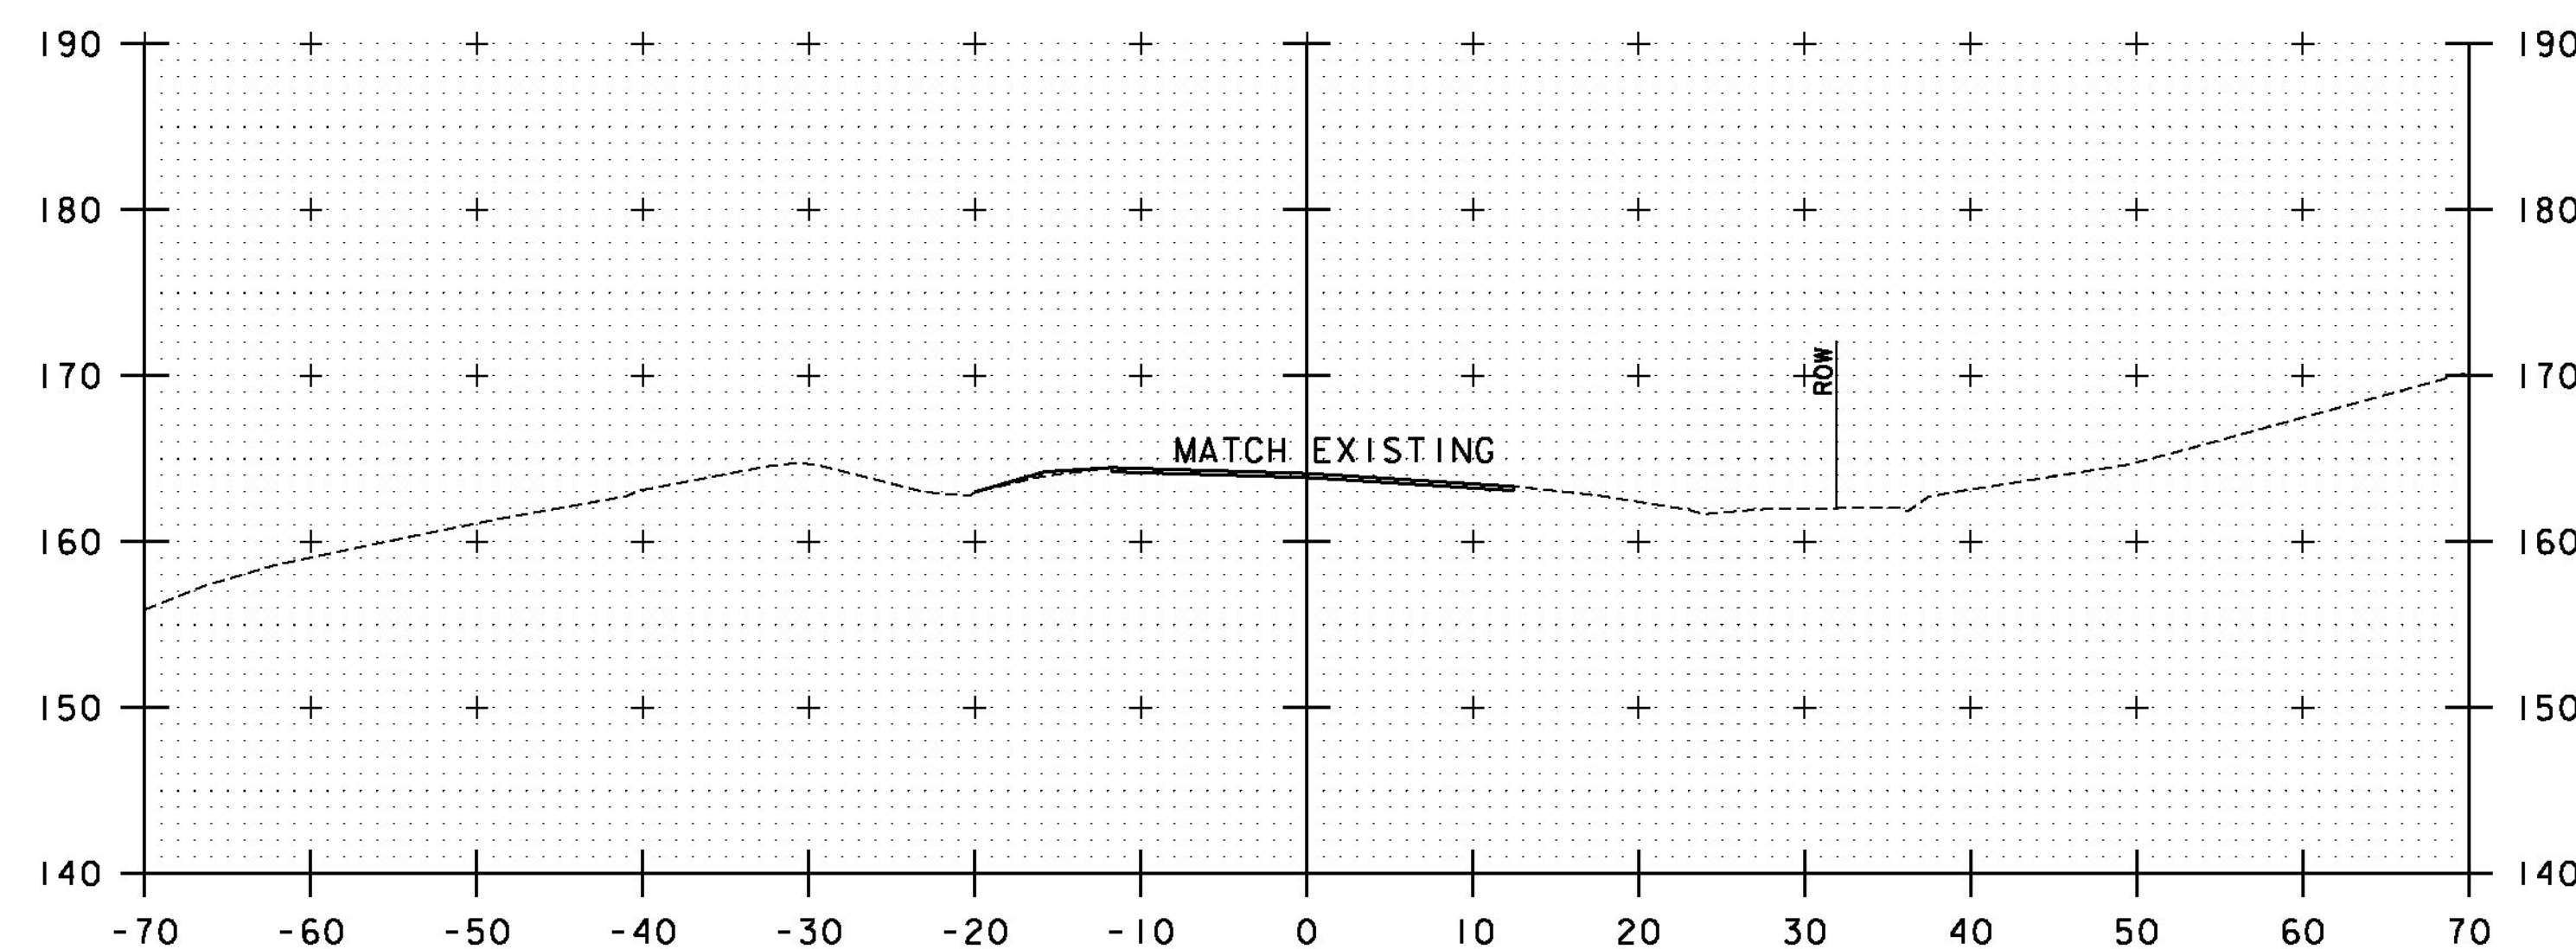

14+25

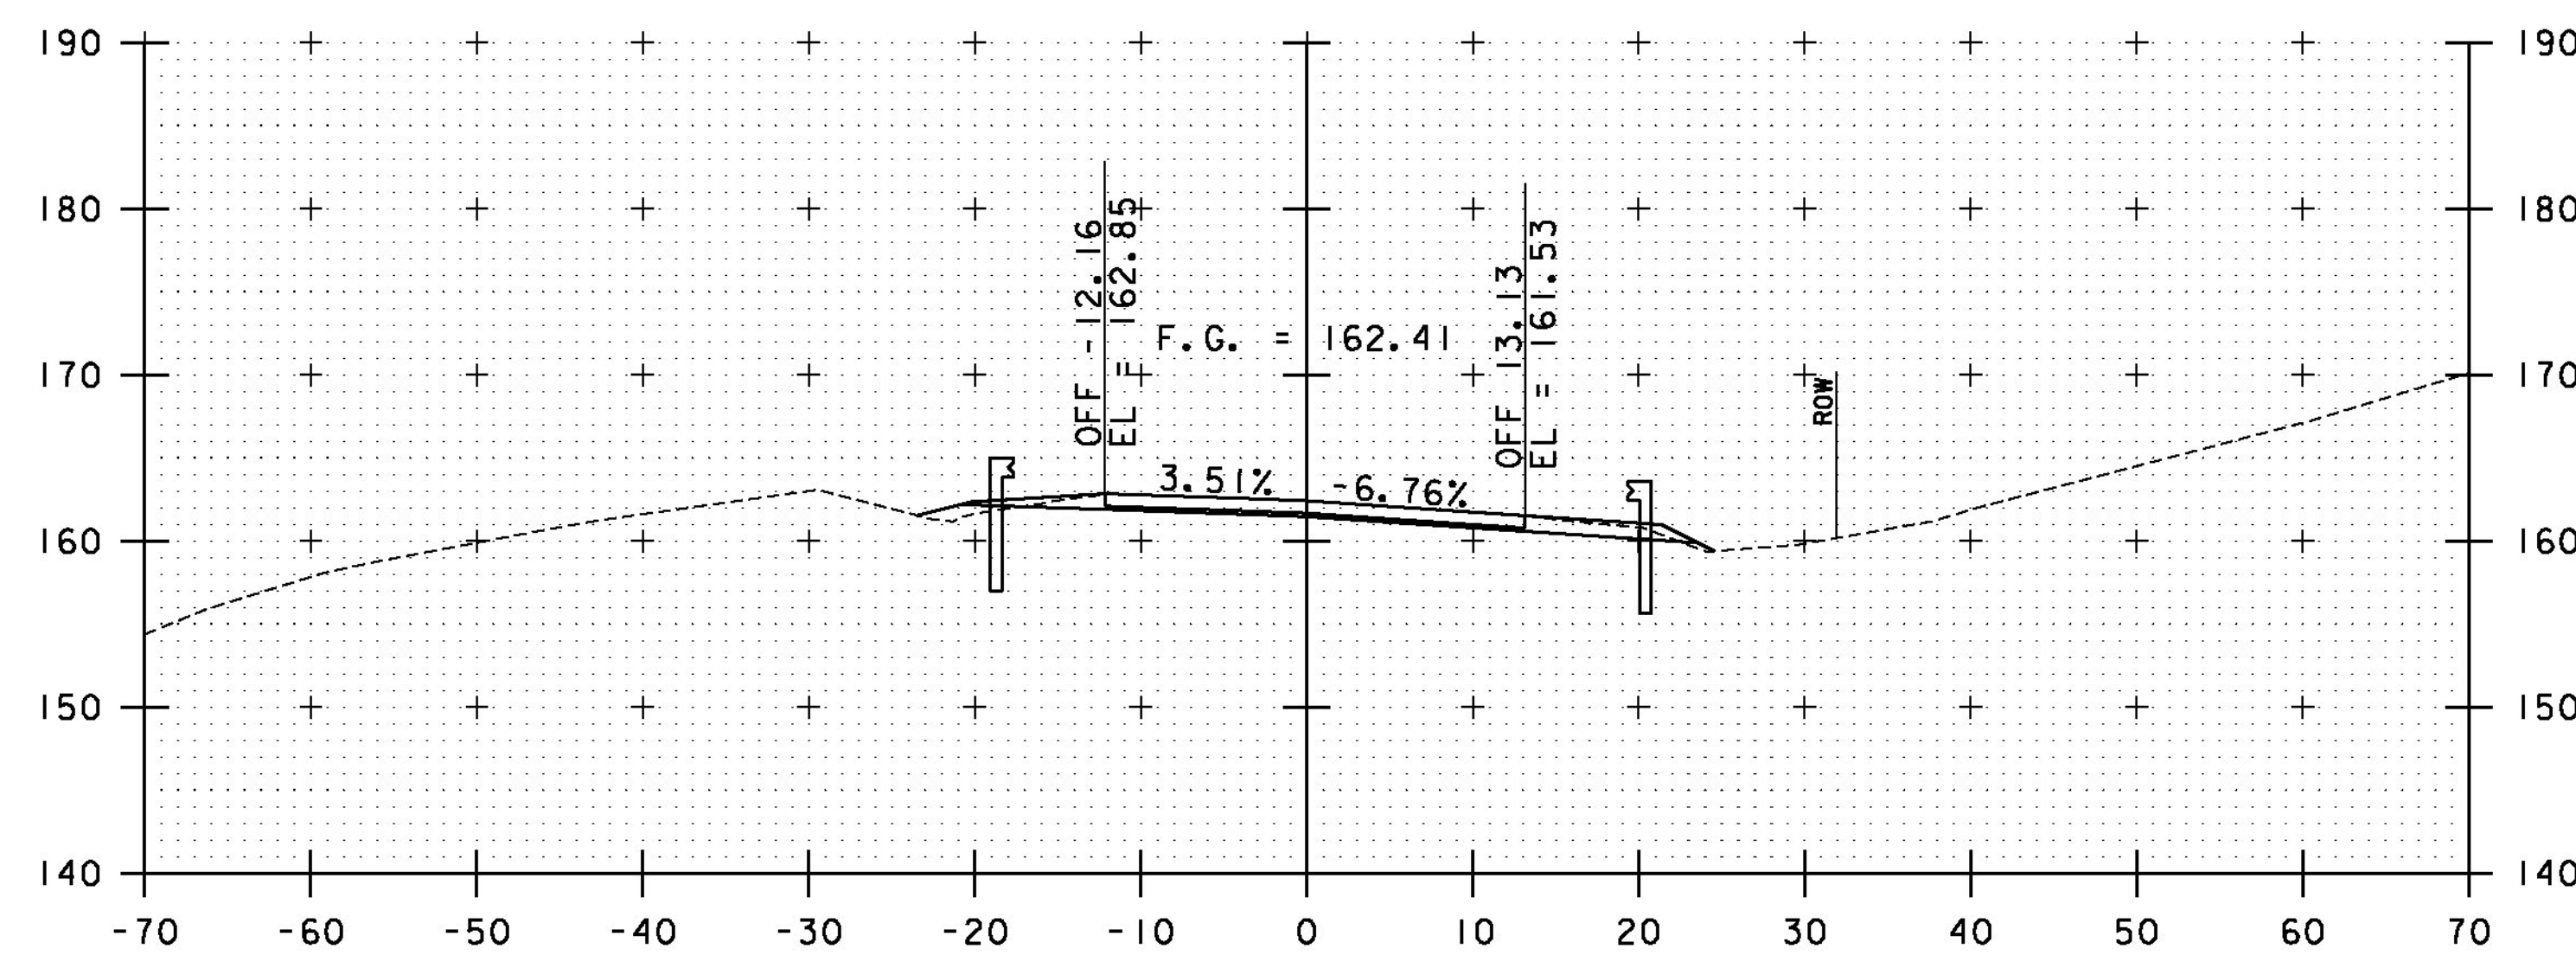

14+00

STA. 13+25 TO STA. 14+25

PROJECT NAME: BRIDPORT
PROJECT NUMBER: STP CULV(29)

FILE NAME: zllc264xs_br2.dgn
PROJECT LEADER: M. CHENETTE
DESIGNED BY: J. HUNGERFORD
ROADWAYCROSS SECTIONS - Rxs3 - BR2

PLOT DATE: 8/22/2014
DRAWN BY: L. BUXTON
CHECKED BY: M. CHENETTE
SHEET 26 OF 57

