


14+55  
END APPROACH

14+75

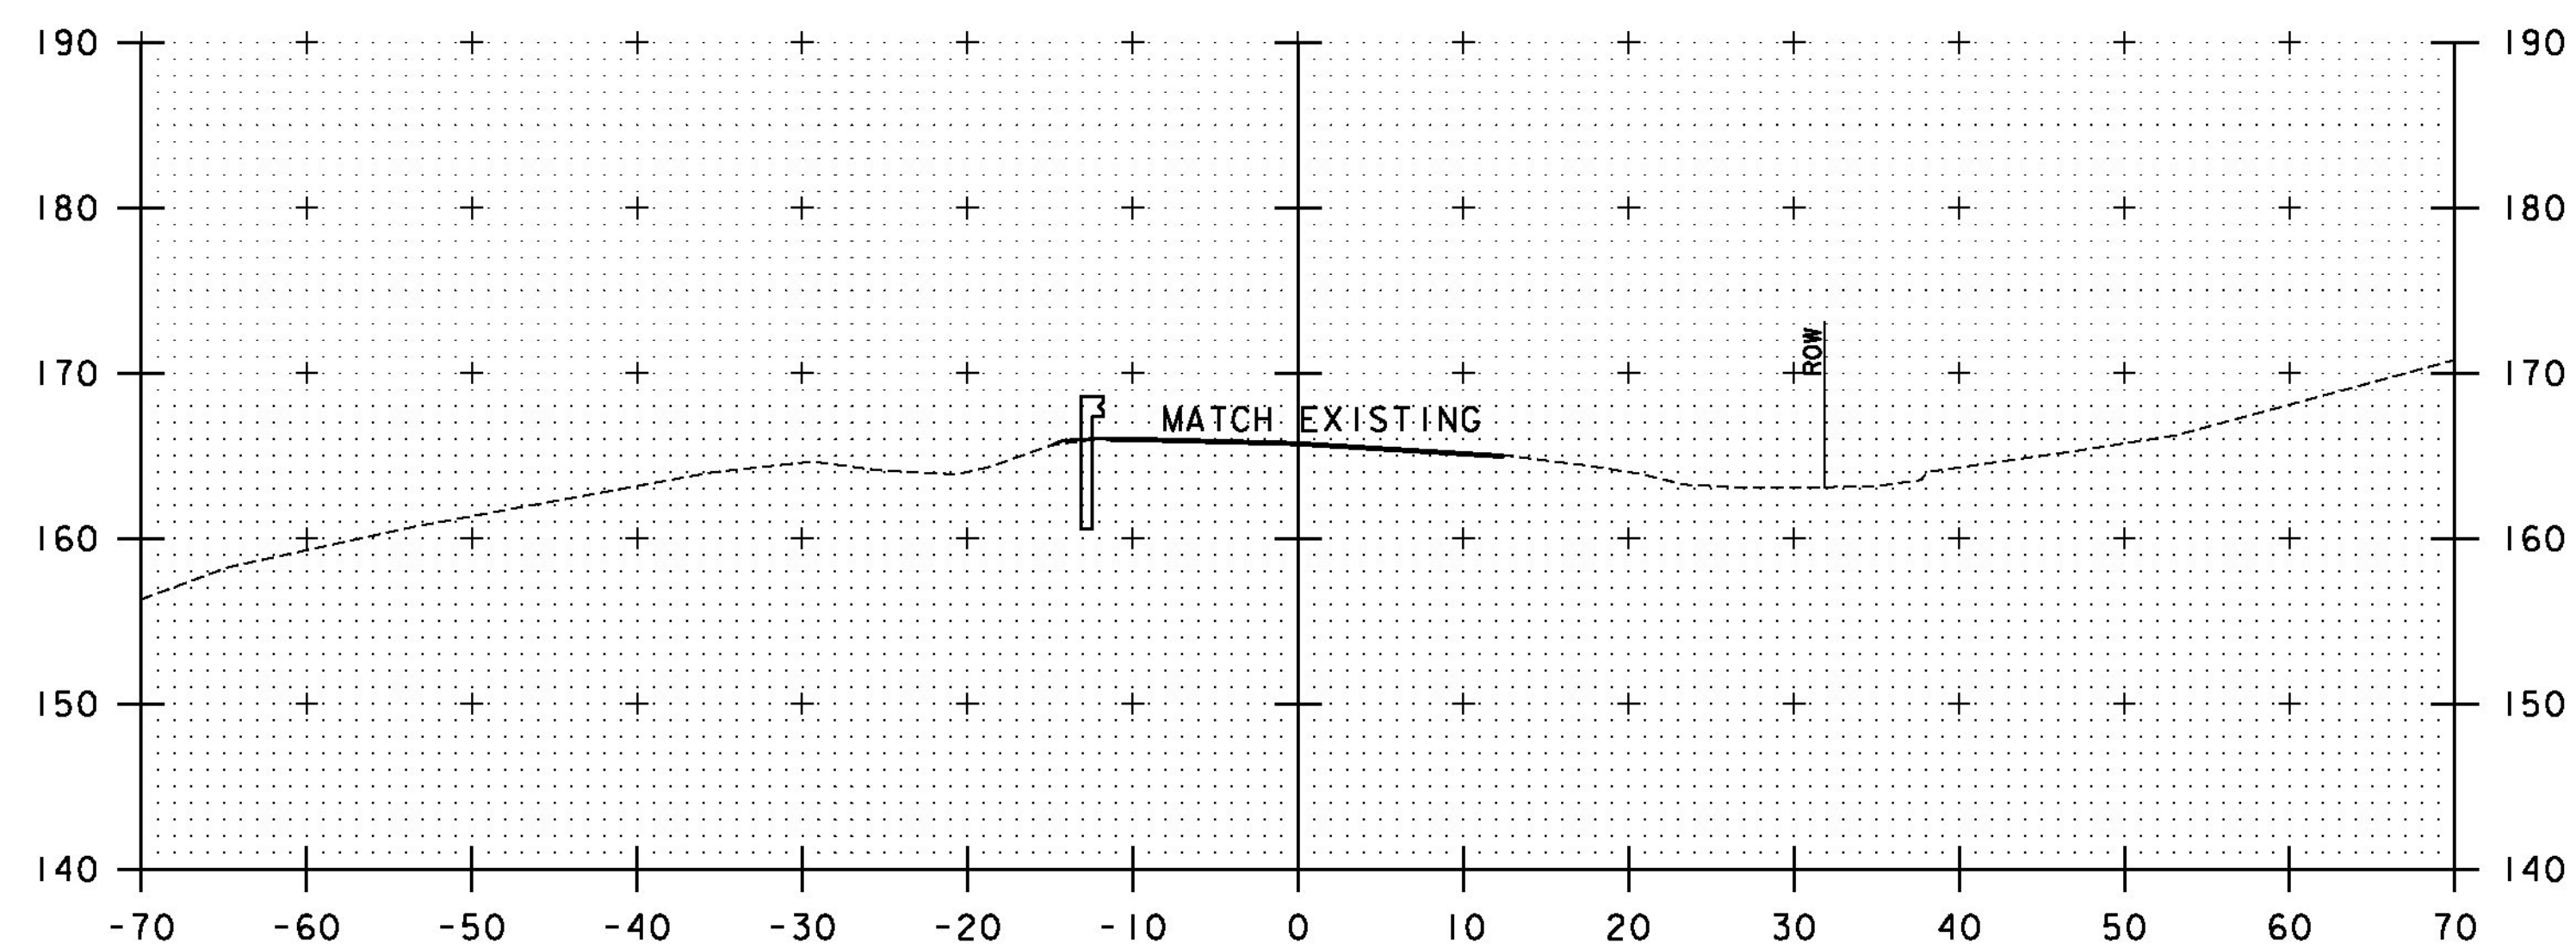

14+50

STA. 14+50 TO STA. 14+75

PROJECT NAME: BRIDPORT  
PROJECT NUMBER: STP CULV(29)

FILE NAME: zllc264xs\_br2.dgn  
PROJECT LEADER: M. CHENETTE  
DESIGNED BY: J. HUNGERFORD  
ROADWAY CROSS SECTIONS - RXS4 - BR2

PLOT DATE: 8/22/2014  
DRAWN BY: L. BUXTON  
CHECKED BY: M. CHENETTE  
SHEET 27 OF 57

