


NOT TO SCALE

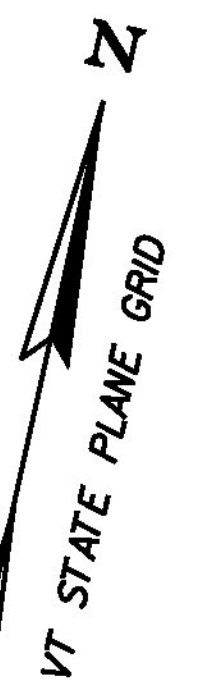


LEGEND

 STABILIZED CONSTRUCTION ENTRANCE

ITEM 653.55 PROJECT DEMARCATION FENCE
 STA. 20+37.32 - 23+39.36, RT.
 STA. 20+42.71 - 23+46.84, LT.

ITEM 649.51 GEOTEXTILE FOR SILT FENCE
 SEE LOCATIONS, THIS SHEET.

PLAN
 SCALE: 1" = 20'-0"


NOTE:
 THE CONTRACTOR IS RESPONSIBLE FOR DEVELOPING A TEMPORARY STREAM DIVERSION PLAN. THE PLAN SHALL INCLUDE EROSION CONTROL MEASURES AS NECESSARY TO PREVENT AND CONTROL SEDIMENT DISCHARGE. SEE SPECIAL PROVISION 900.645 (TEMPORARY RELOCATION OF STREAM).

PROJECT NAME: BRIDPORT	FILE NAME: zllc264bdr_ero_br5.dgn	PLOT DATE: 8/22/2014
PROJECT NUMBER: STP CULV(29)	PROJECT LEADER: M. CHENETTE	DRAWN BY: L. BUXTON
	DESIGNED BY: J. HUNGERFORD	CHECKED BY: M. CHENETTE
	EPSC CONST. SITE PLAN - ECP 1- BR5	SHEET 53 OF 57

